




This document should not be relied on or used in circumstances other than those for which it was prepared and for which Westridge was commissioned. Westridge accepts no responsibility for this document to any other party other than the person by whom it was commissioned. All setting out dimensions on drawings are to be confirmed on site, if there are any discrepancies then please notify Westridge for clarification.

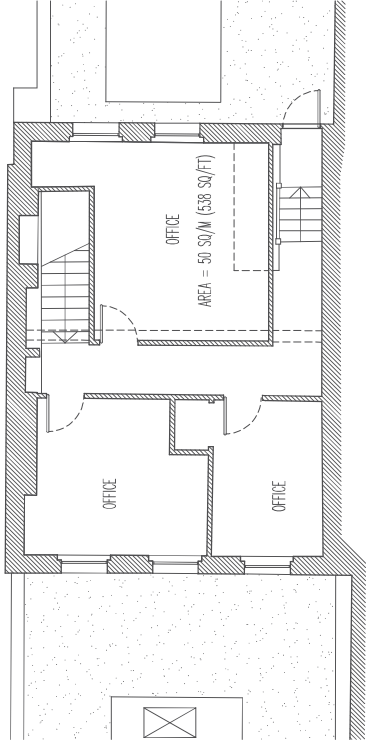


SECOND FLOOR

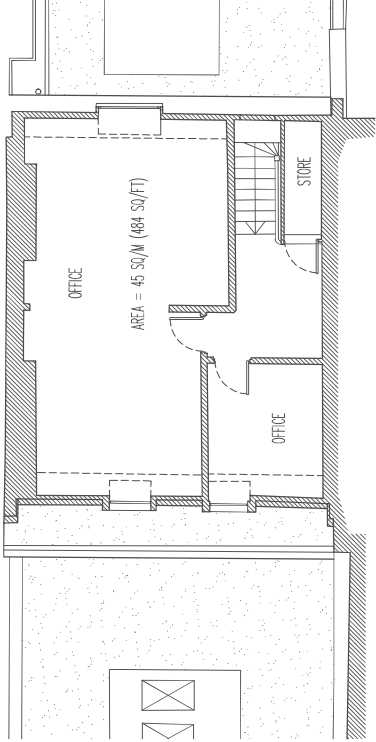

THIRD FLOOR

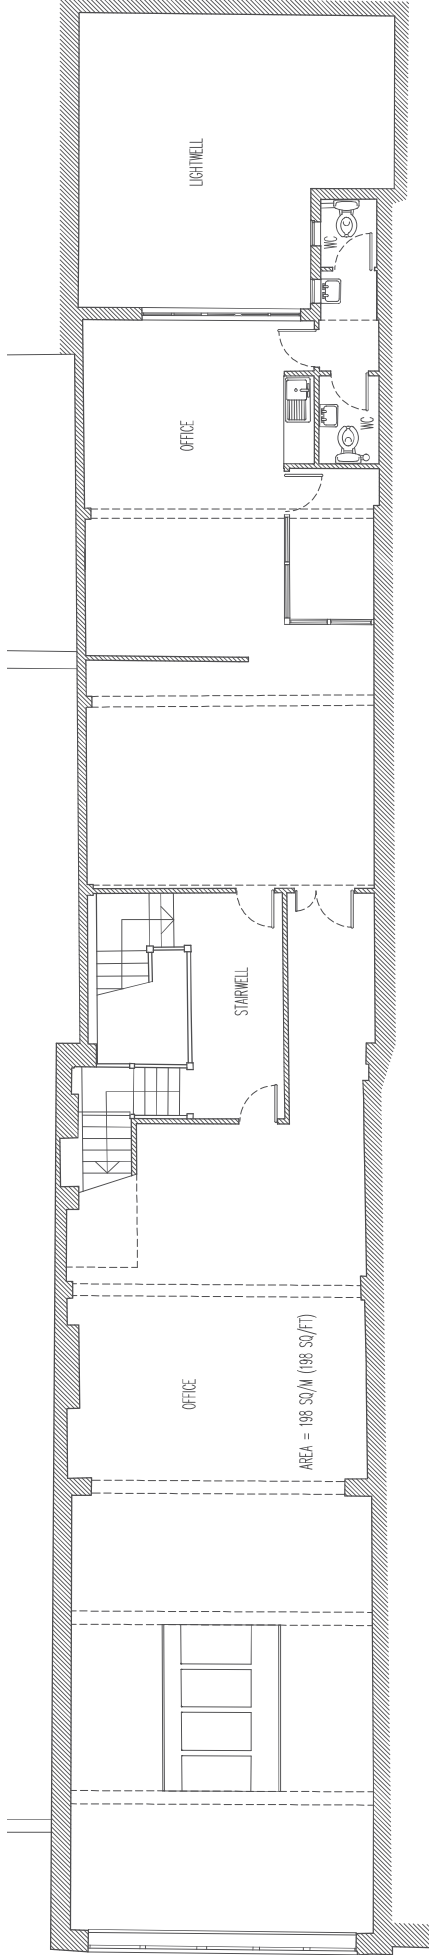

FIRST FLOOR

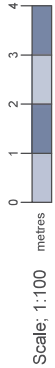

WESTRIDGE Property Consultants Ltd Design - Development - Project Management		CLIENT: MAJESTY DEVELOPMENTS		DRAWING: EXISTING FIRST, SECOND & THIRD FLOORS		General Arrangement DO NOT SCALE OFF THIS DRAWING	
Mill House, Mill Court Great Shelford Cambridge CB22 5LD Tel: 01223 233 600 www.westridgeconsultants.co.uk		PROJECT: 162 HOLLOWAY ROAD - LONDON - AS BUILT		Scale: 1:100		Job No: WPC0546	
				Date: 03 October 2024		Dwg No: CA-02	
						Rev: 0	