


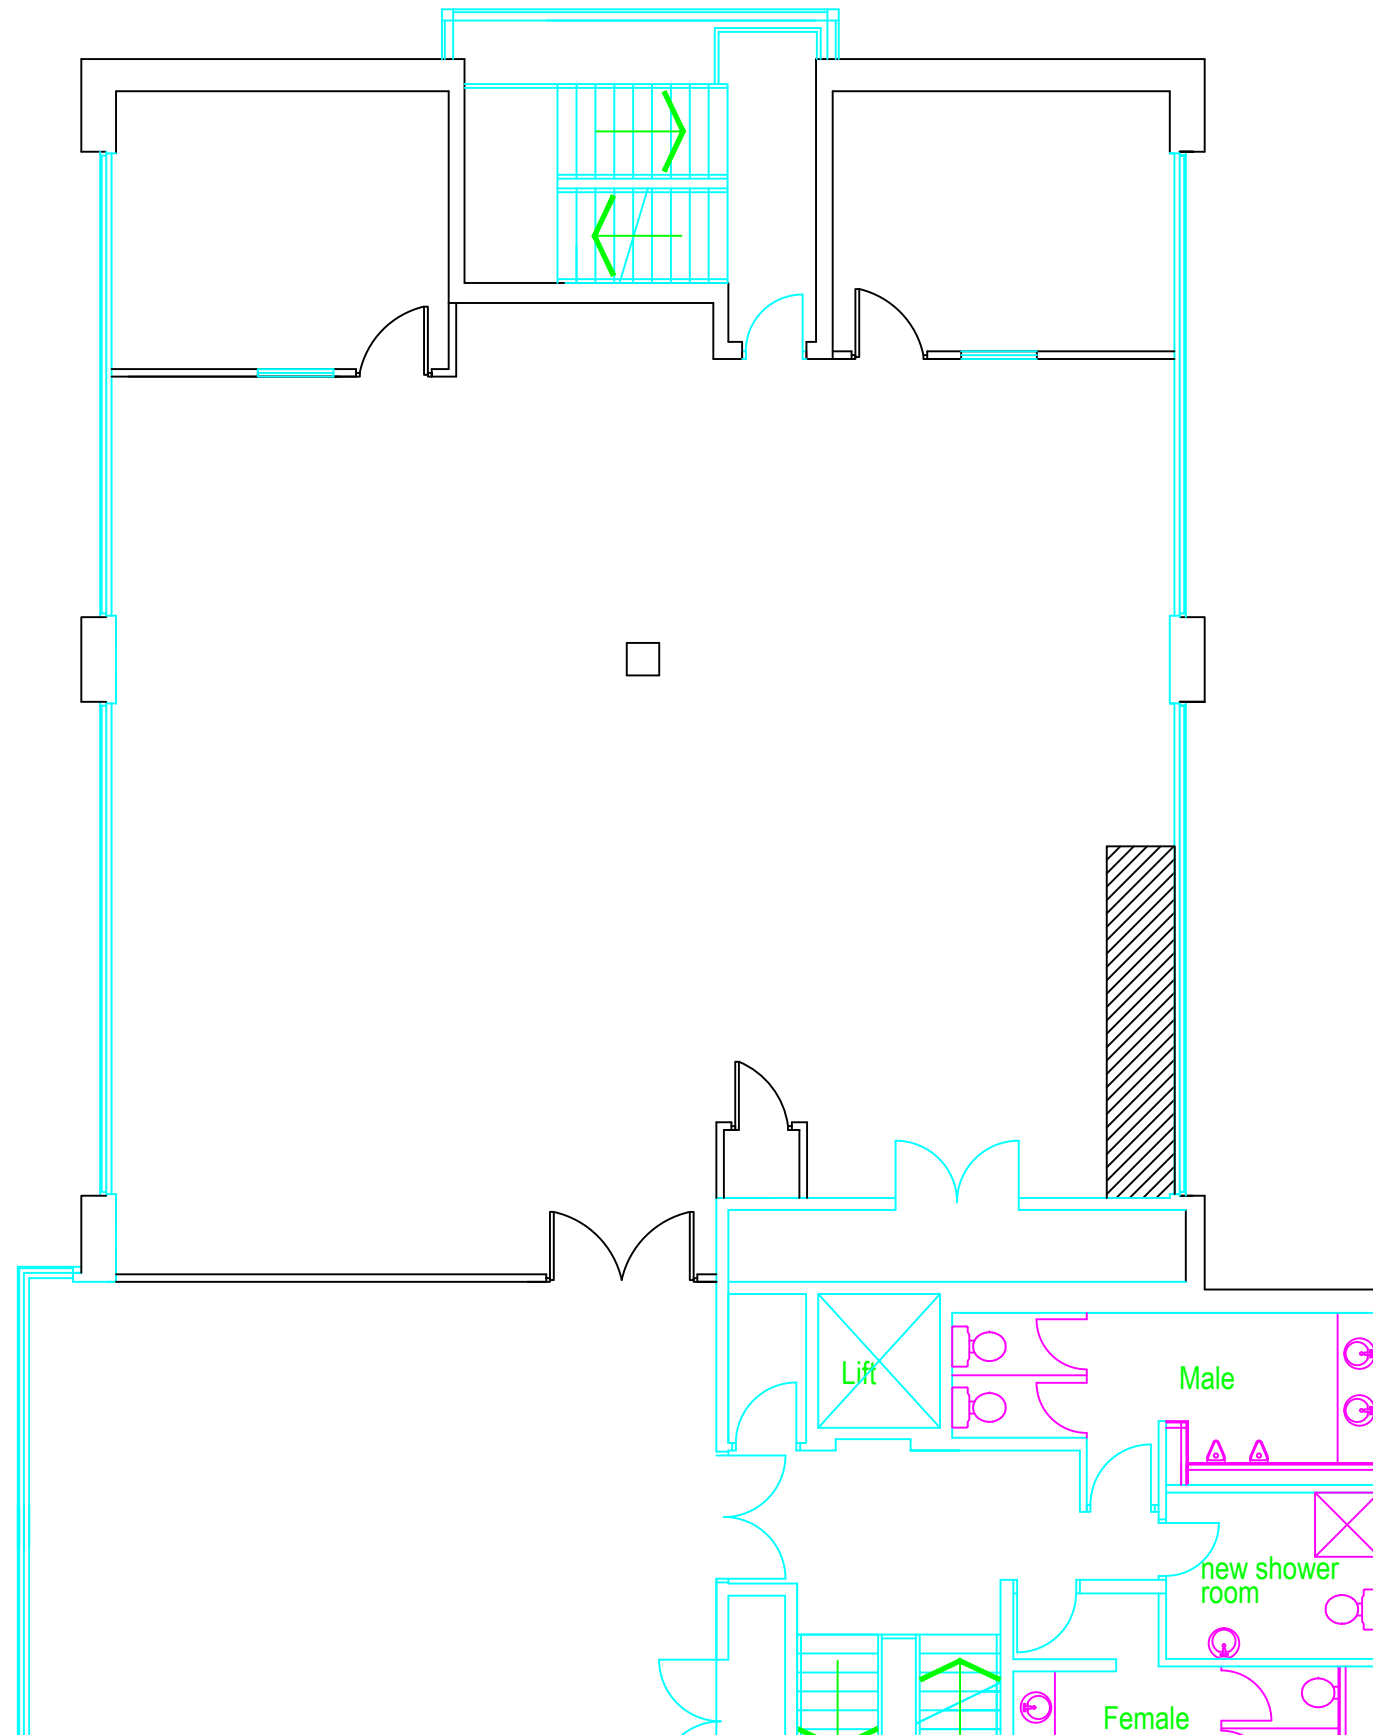

Client.
Horta Properties

Project.
249 Silbury Boulevard
Milton Keynes
Part of First Floor

Drawing
As Built

Scale	Date	Job Reference.	Dwg. No.
1:100 @A3	05/2022	.	001

MK2

REAL ESTATE

57 Cornwall Street, Birmingham, B3 2EE
0121 214 1970