


NOTES: DO NOT SCALE FROM THIS DRAWING.

- THIS DRAWING REQUIRES:
- CLIENT APPROVAL
 - LANDLORD APPROVAL
 - BUILDING CONTROL APPROVAL
 - FIRE OFFICER APPROVAL

REV BY	DATE	DESCRIPTION
A		FIRST ISSUE
B	13.12.20	COMMS ROOM ADDED
C	07.03.21	FOR CONSTRUCTION
D	22.03.21	REMOVE FURNITURE
E	16.05.21	AS BUILT

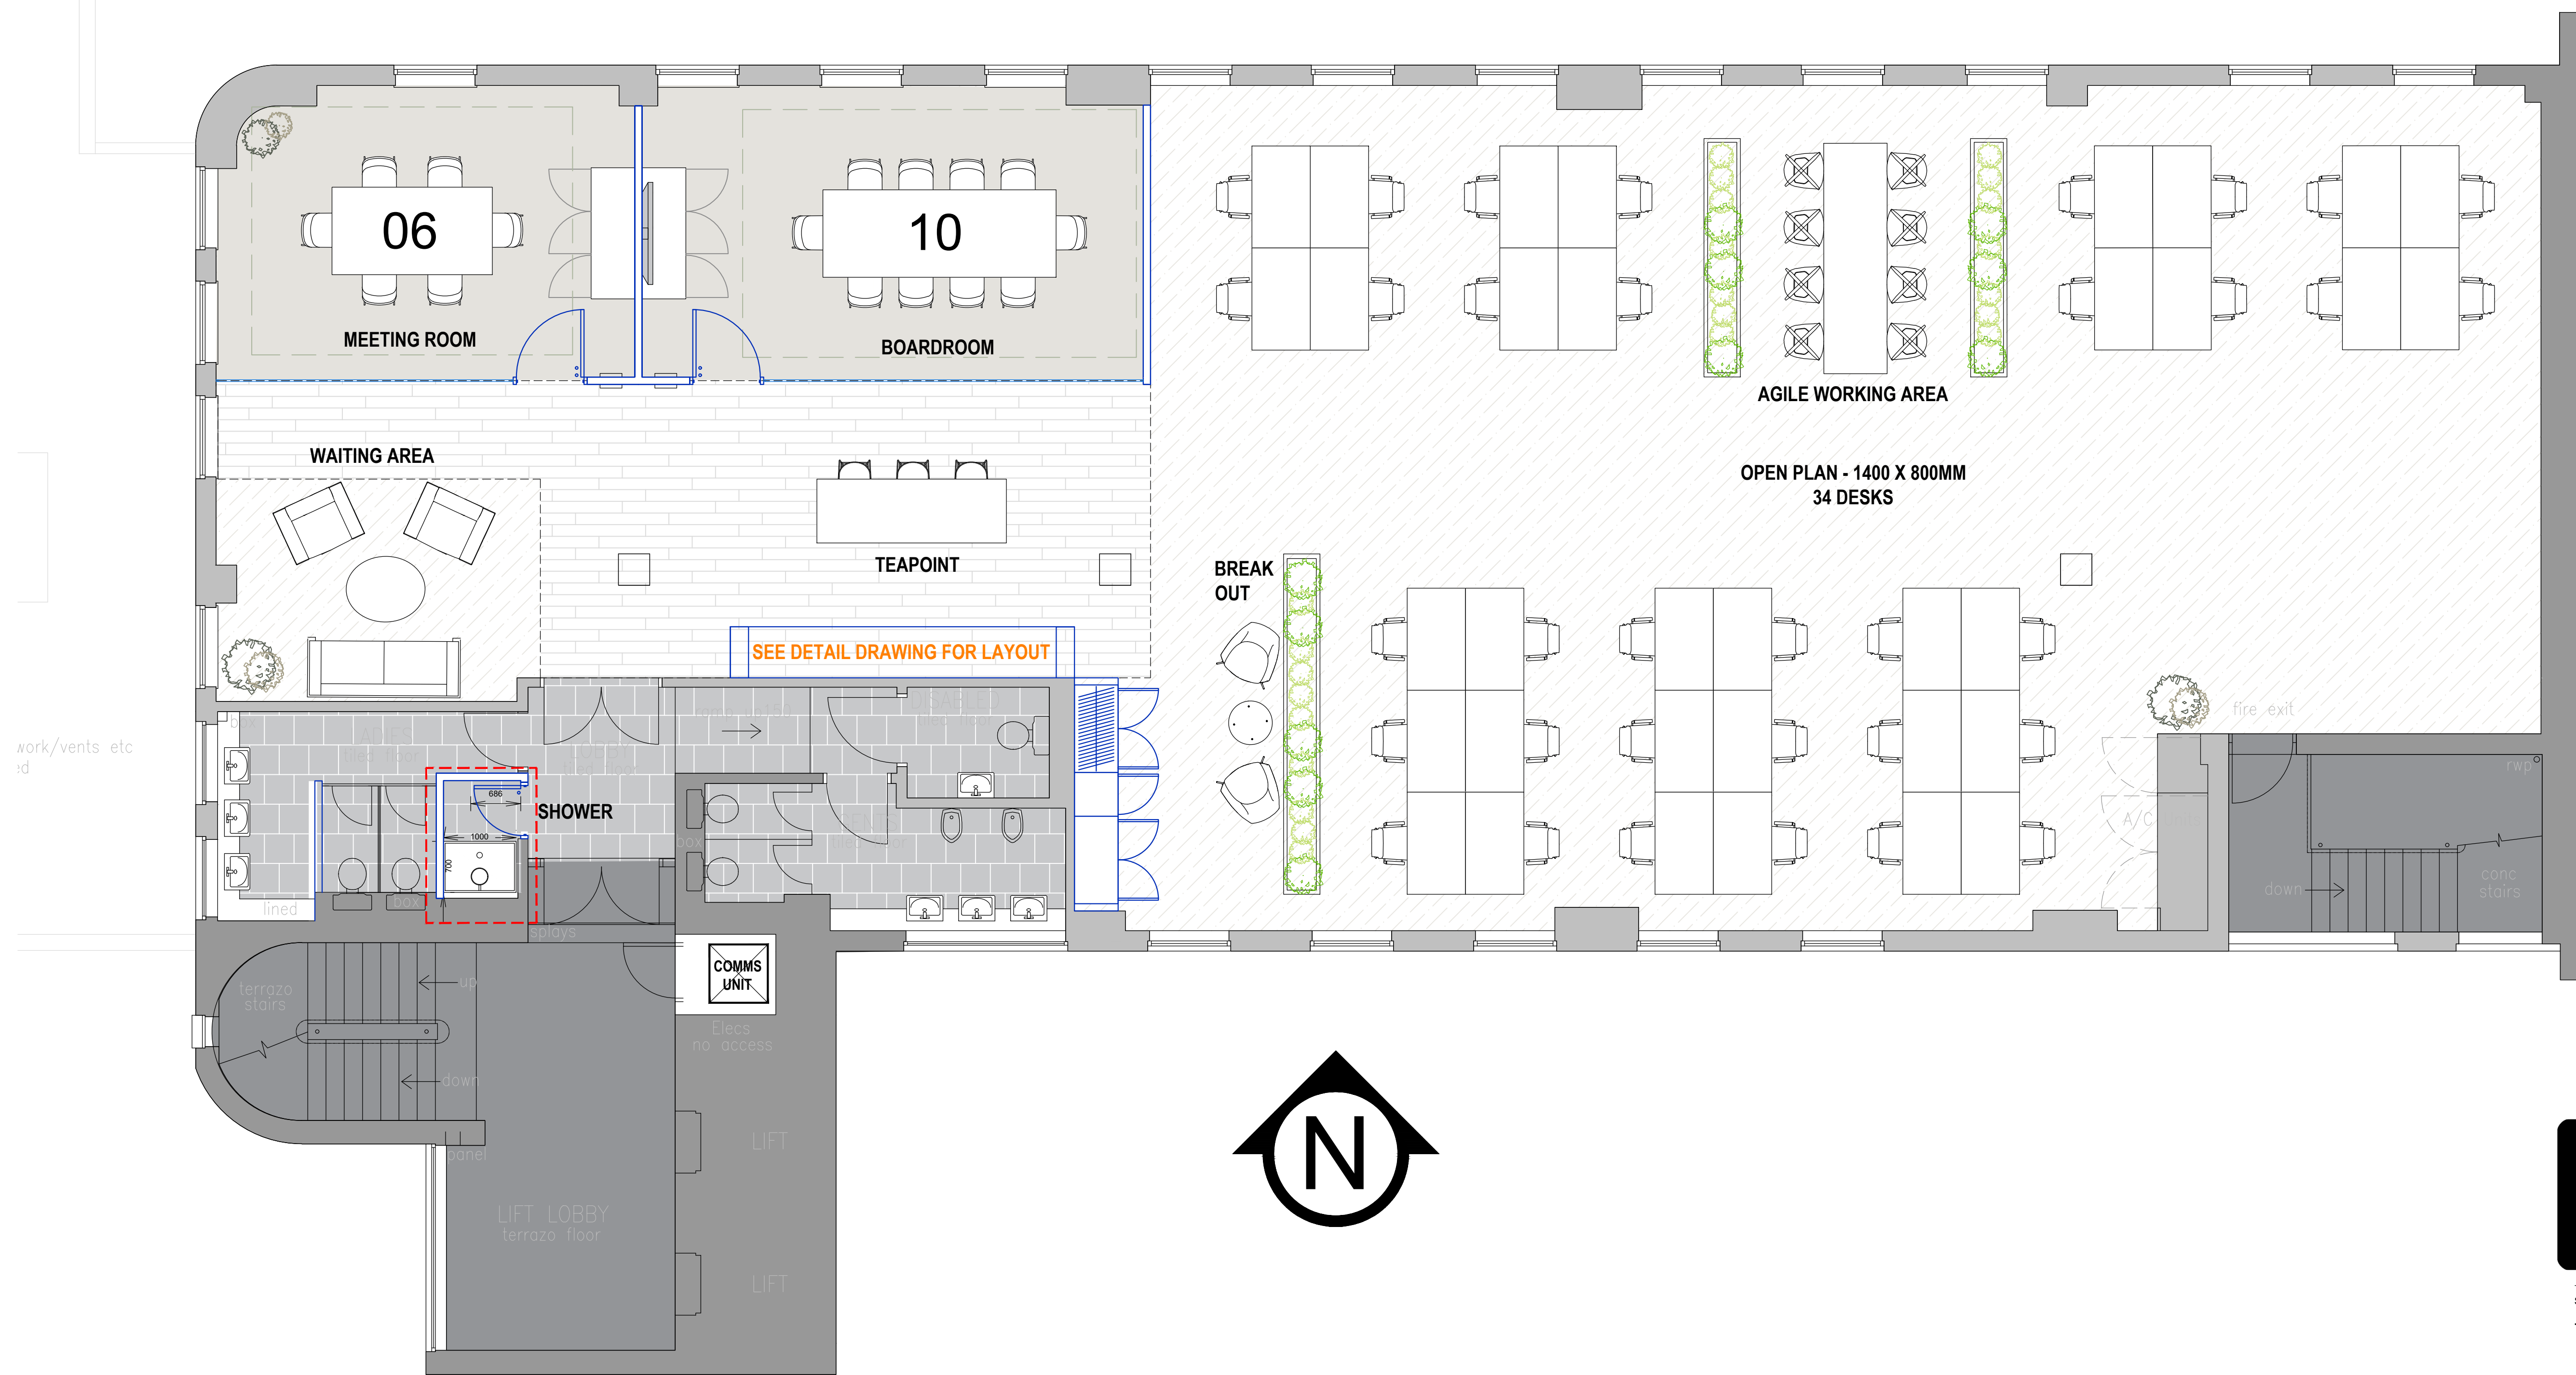

SITE ADDRESS:
 - ANGEL WALK,
 65 - 79 KING STREET
 HAMMERSMITH
 W6 9HW

DRAWING TITLE:
 SPACE PLAN

SCALE: 1:50@A1 DRAWN BY: DATE: 16.05.2021

JOB No.	TYPE	SERIES	FLOOR	REV.
0001	SP	1	03	E

AS - BUILT

SIGNED BY CLIENT..... DATE.....