

NOTE

This drawing is not to be scaled.
Approved contractors are requested to notify Peldon Rose Limited of any construction.
All information is subject to statutory approval and site survey.

The general contractor is to carry out a check site survey to confirm that the information is correct and to advise the appropriate of the construction in which it is to be installed.
The general contractor is to notify Peldon Rose Limited in writing of all changes to the information shown on this drawing.

DRAWING STATUS

RECORD DRAWING

REVISIONS

REV	DATE	DESCRIPTION	BY	CHK
1	16/07/21	Record Drawing	SW	-
2	16/08/21	Office Service point updated	SW	-
3	22/08/21	Plan adjusted to suit kitchen size change and office machines	SW	-
4	27/08/21	Office machines and desk window added	SW	-
5	16/08/21	Updated to construction drawing	SW	-

PROJECT
PANAGRAM BUILDING
27 GOSWELL ROAD
LONDON EC1M 7GT

TITLE
FOURTH FLOOR
GENERAL ARRANGEMENT
PLAN

Leigh Day

Creating a
Workplace
Balance

Peldon Rose Limited
Sterrington House, 142 Worpole Road
London SW16 6EG

Telephone 020 8971 7777 web: peldonrose.com



DATE	SHEET SIZE	DRAWN BY
01.03.21	A0	SW
SCALE	CHECKED BY	
1:50 @ A0	-	

PROJECT NUMBER	FLOOR TYPE	NUMBER	REVISION
EN2708	04	01	RD

This drawing is protected under copyright and all rights reserved. It shall not be reproduced in whole or in part without the permission of Peldon Rose Limited.

© COPYRIGHT

4th Floor

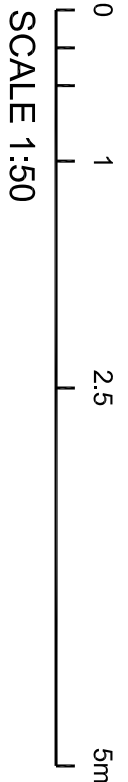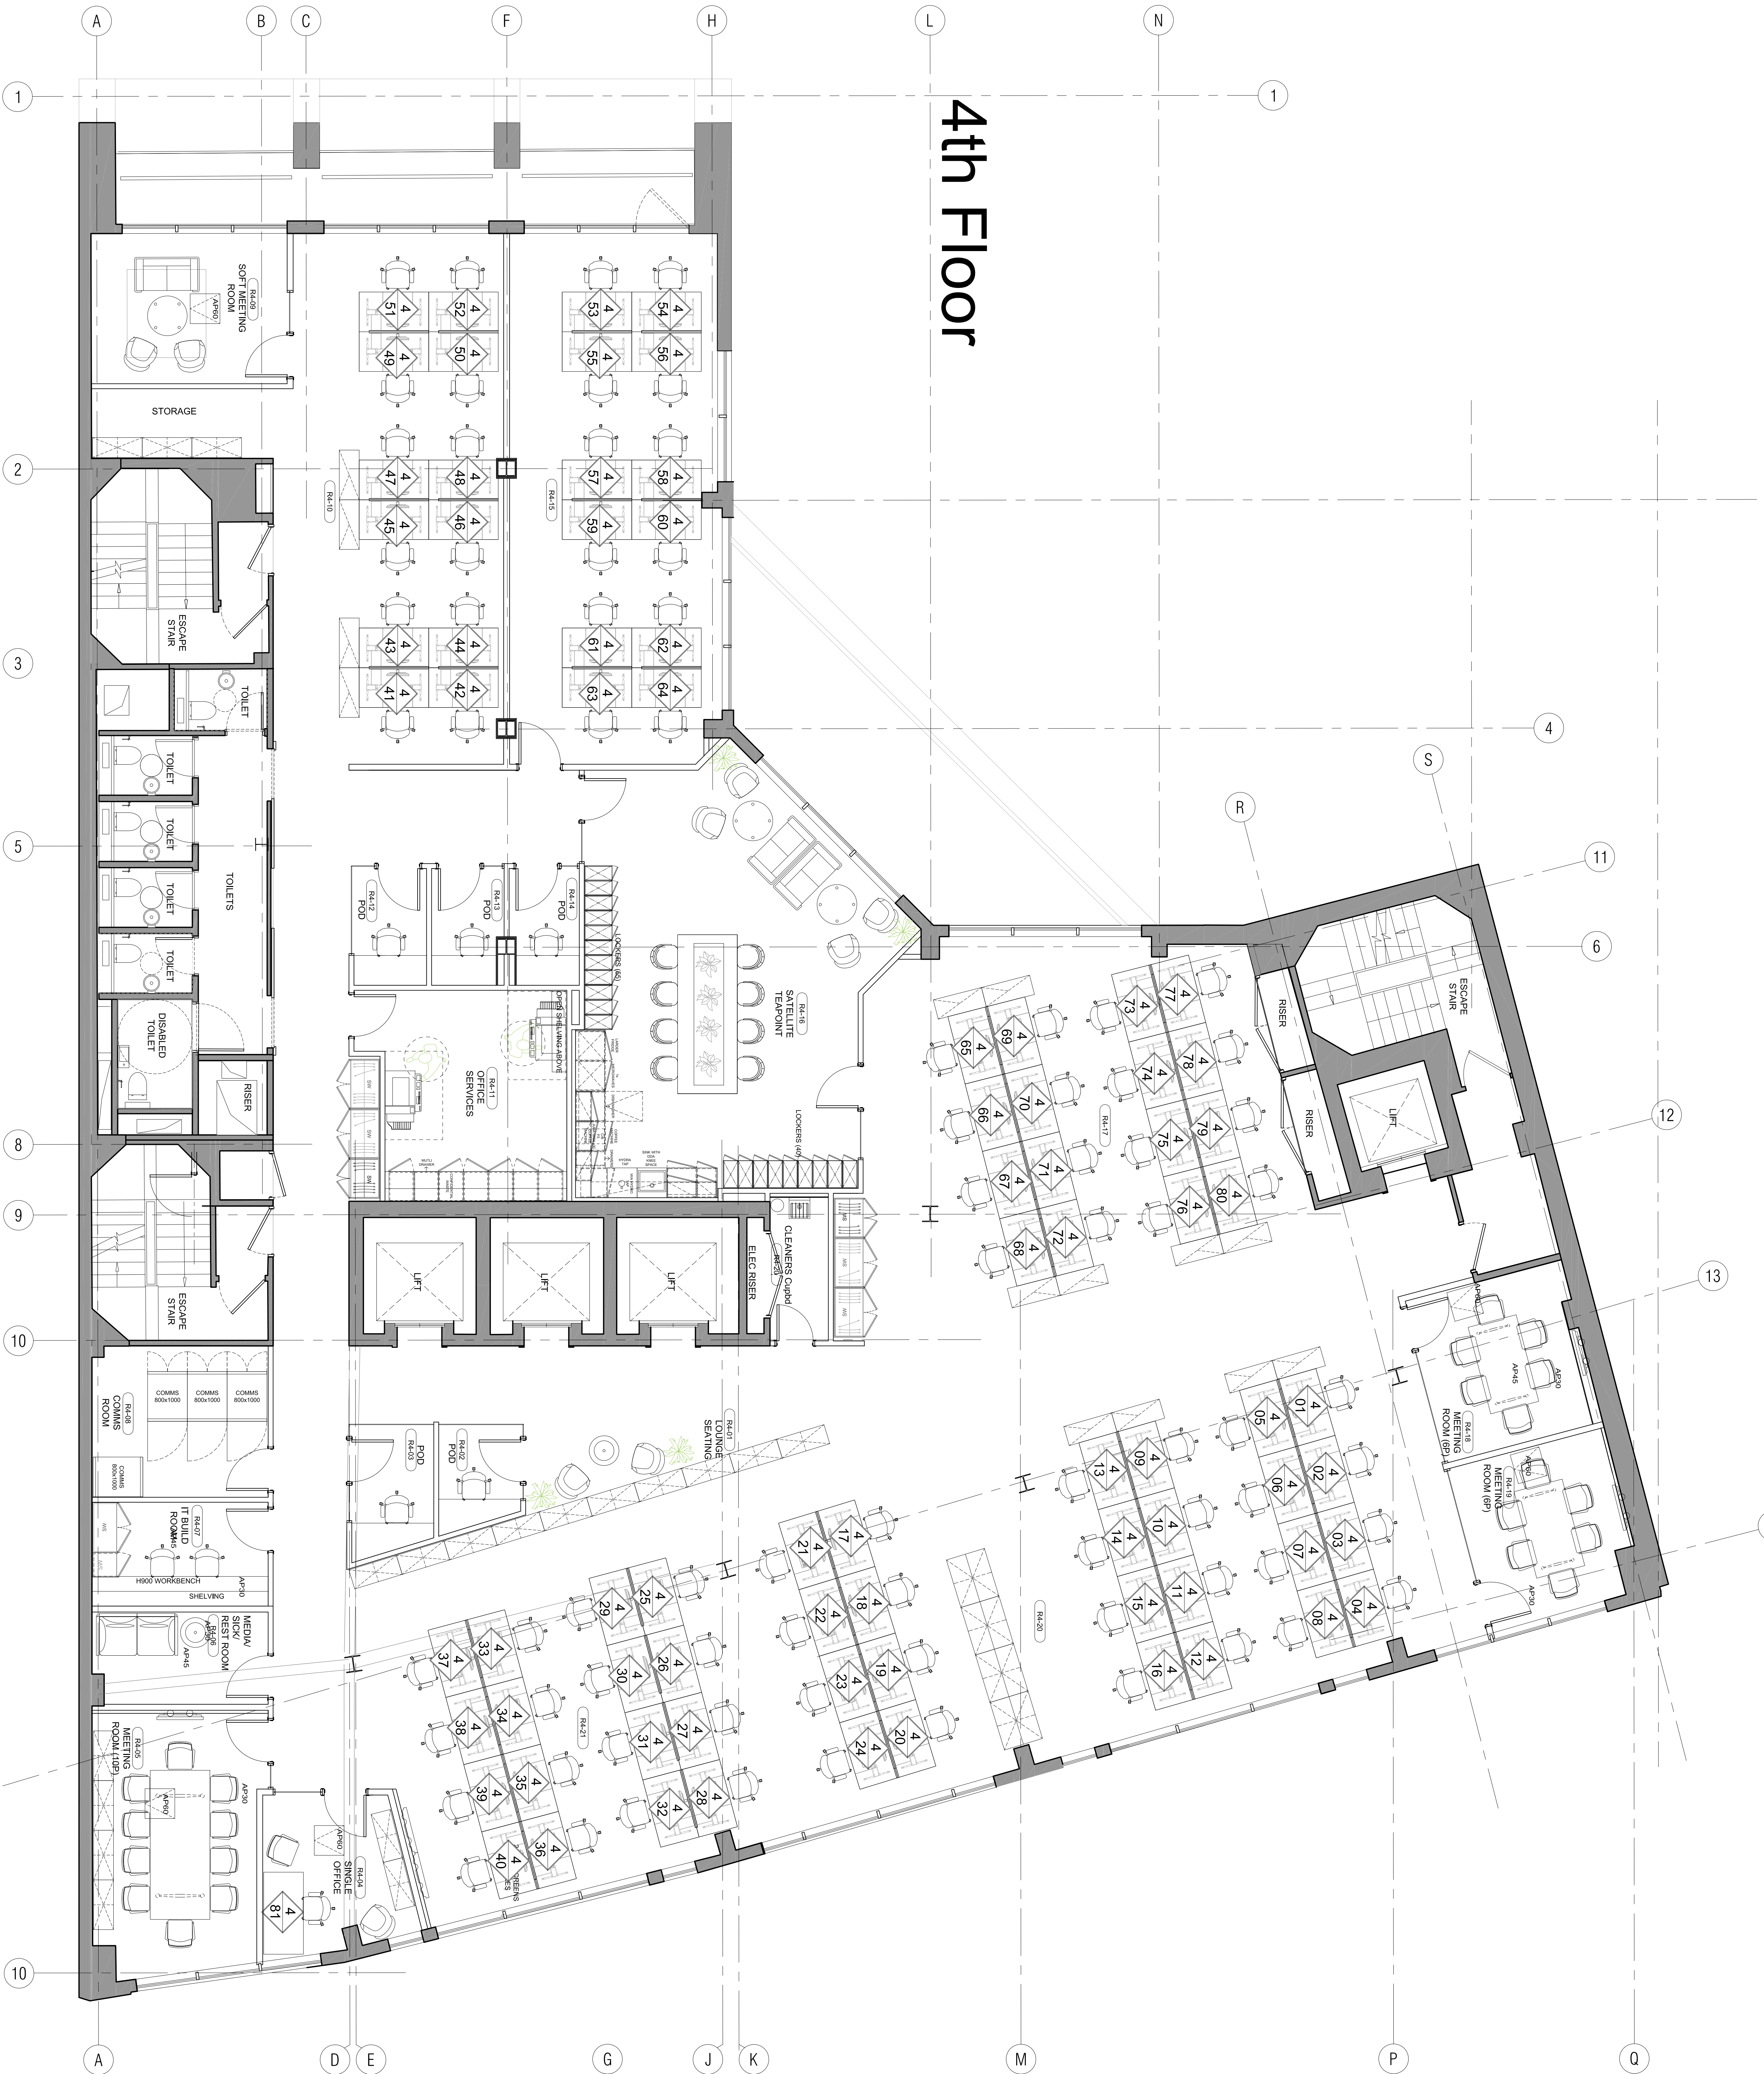

N