


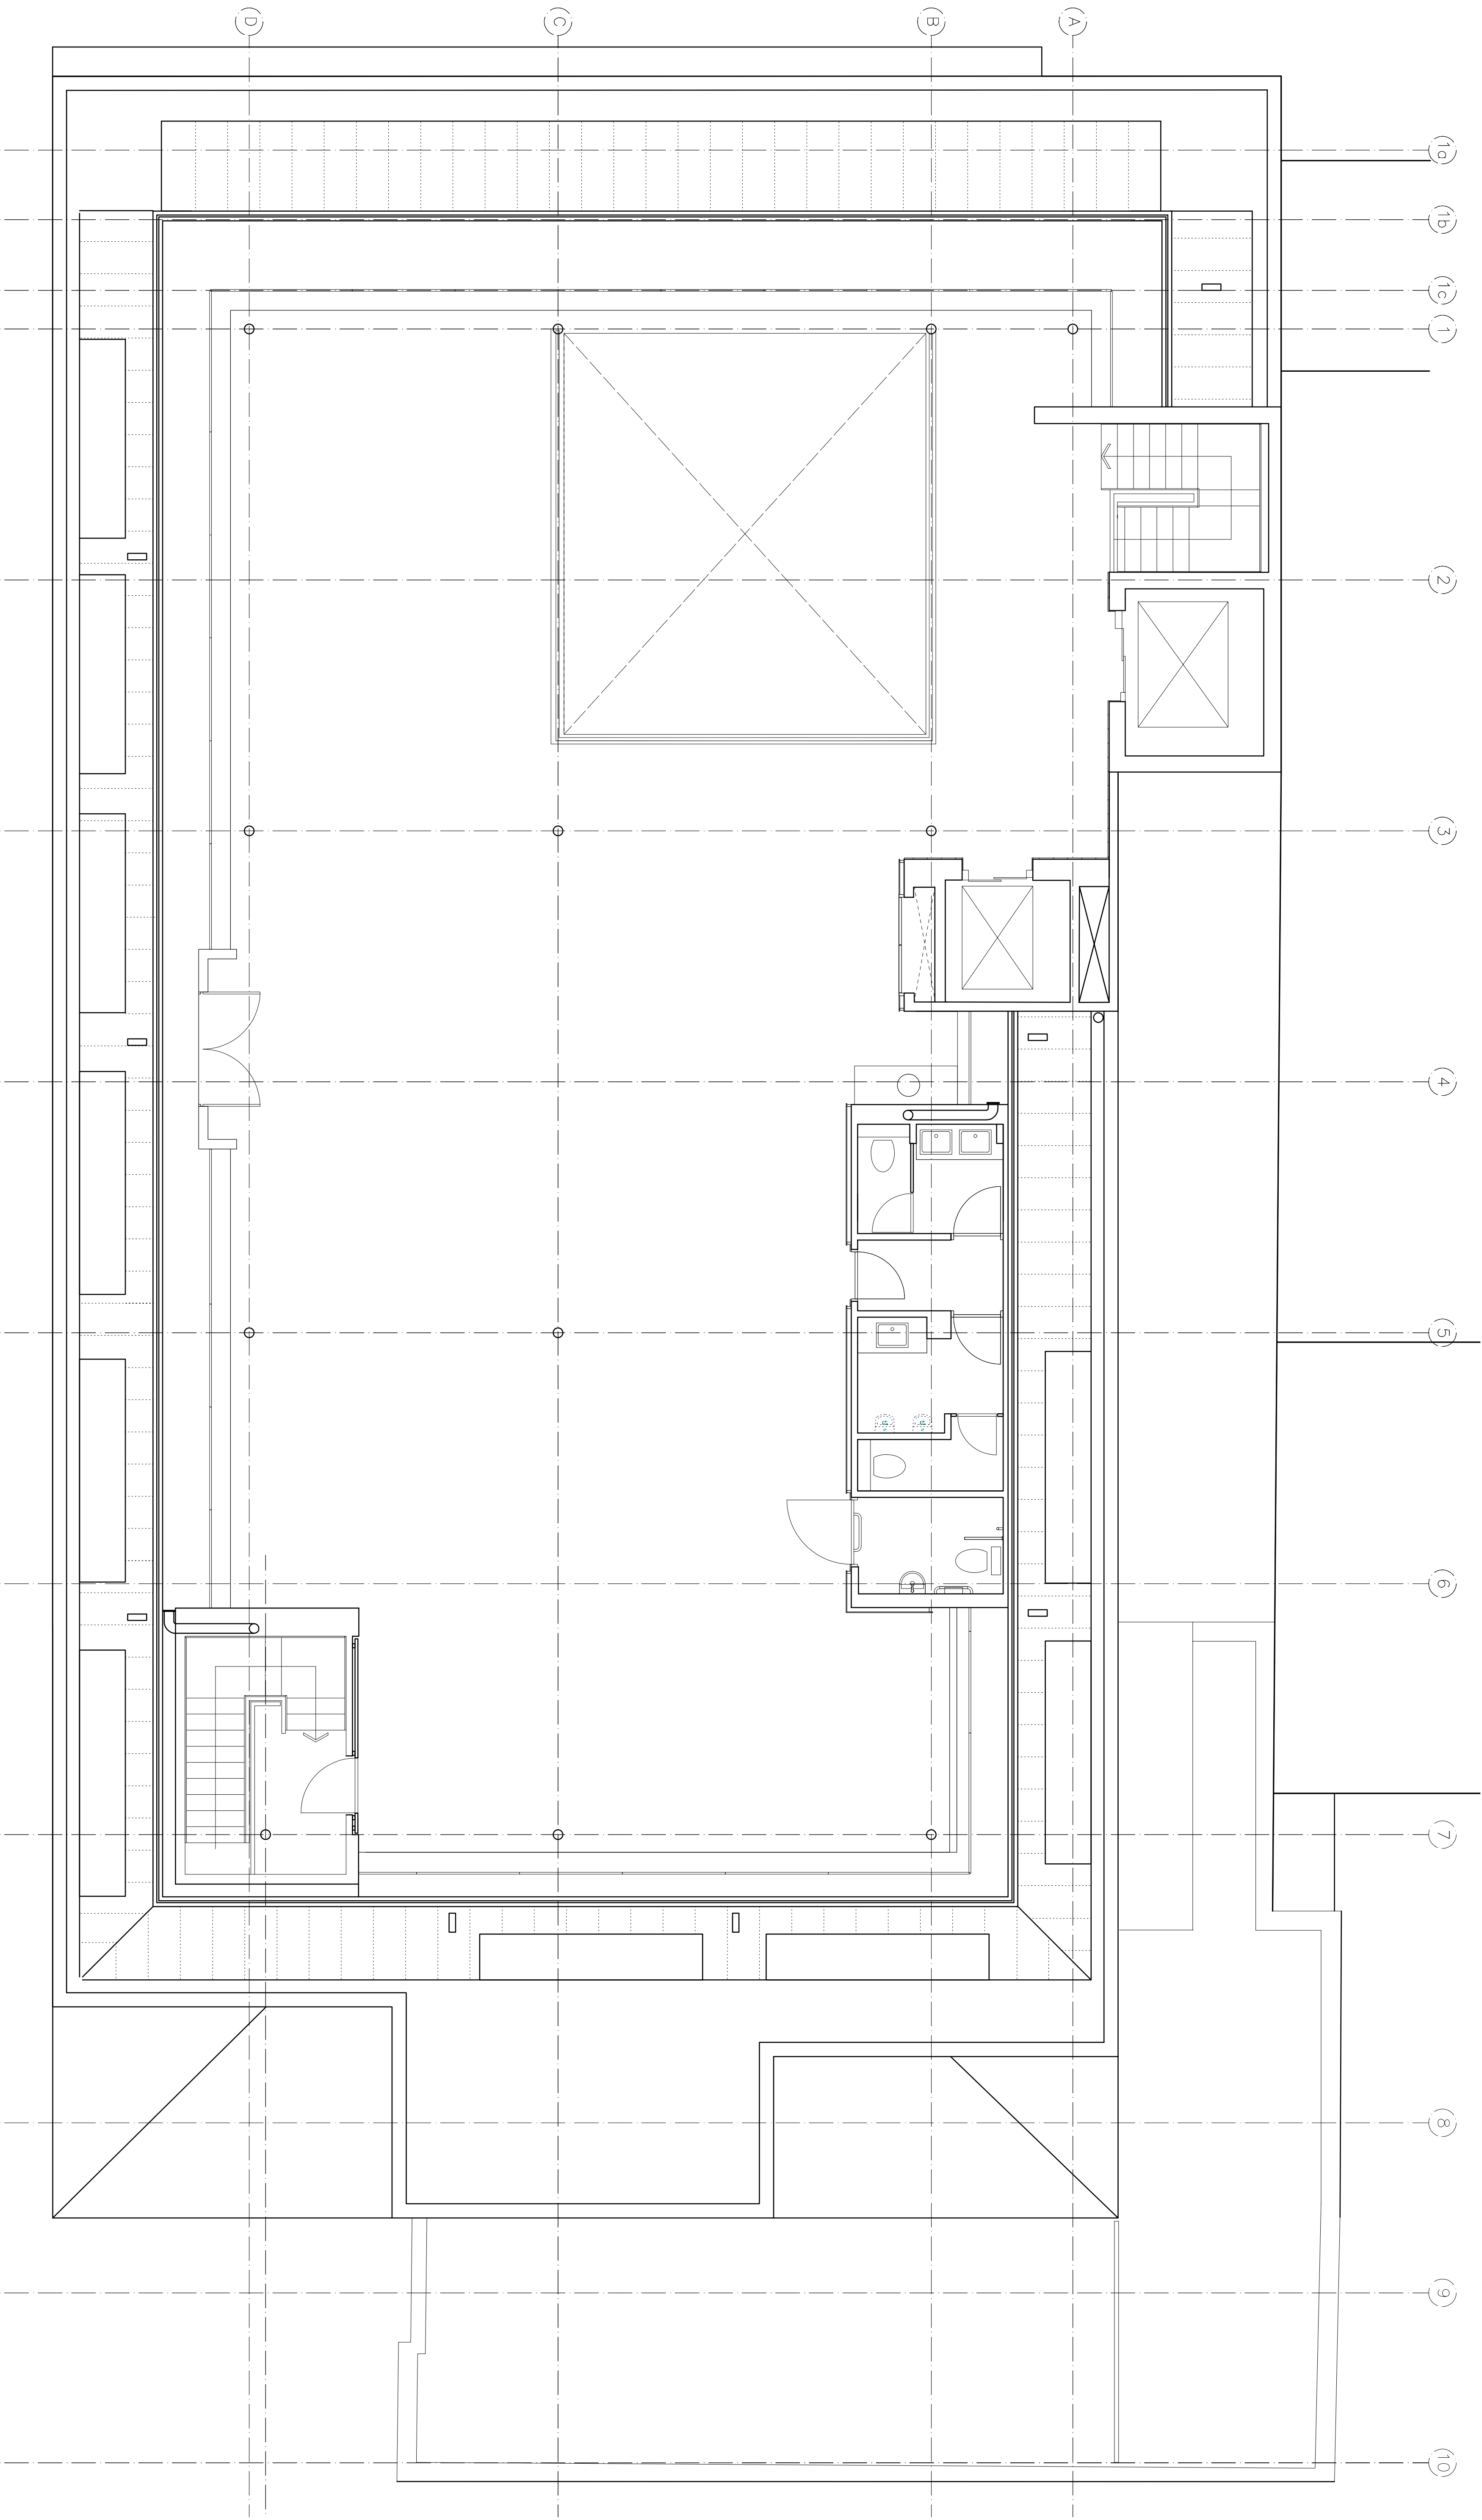

DRAWING NOTES:

DRAWING NOTES:

DRAWING NOTES:	DRAWING NOTES:	DRAWING			
		AS BUILT – Fifth Floor			
		SCALE	1:50 @ A1 (1:100 @ A3)	DRAWING FILE REF 889 East One	
		DATE	FEB 2015	DRAWN BY	MLR
		DWG No.	889 GA 05 – AB	REVISION	
		DRAWING STATUS AS BUILT		CLIENT	AITCH GROUP
				PROJECT	EAST ONE, E1
		STATUS		REVISION	
		DATE			