


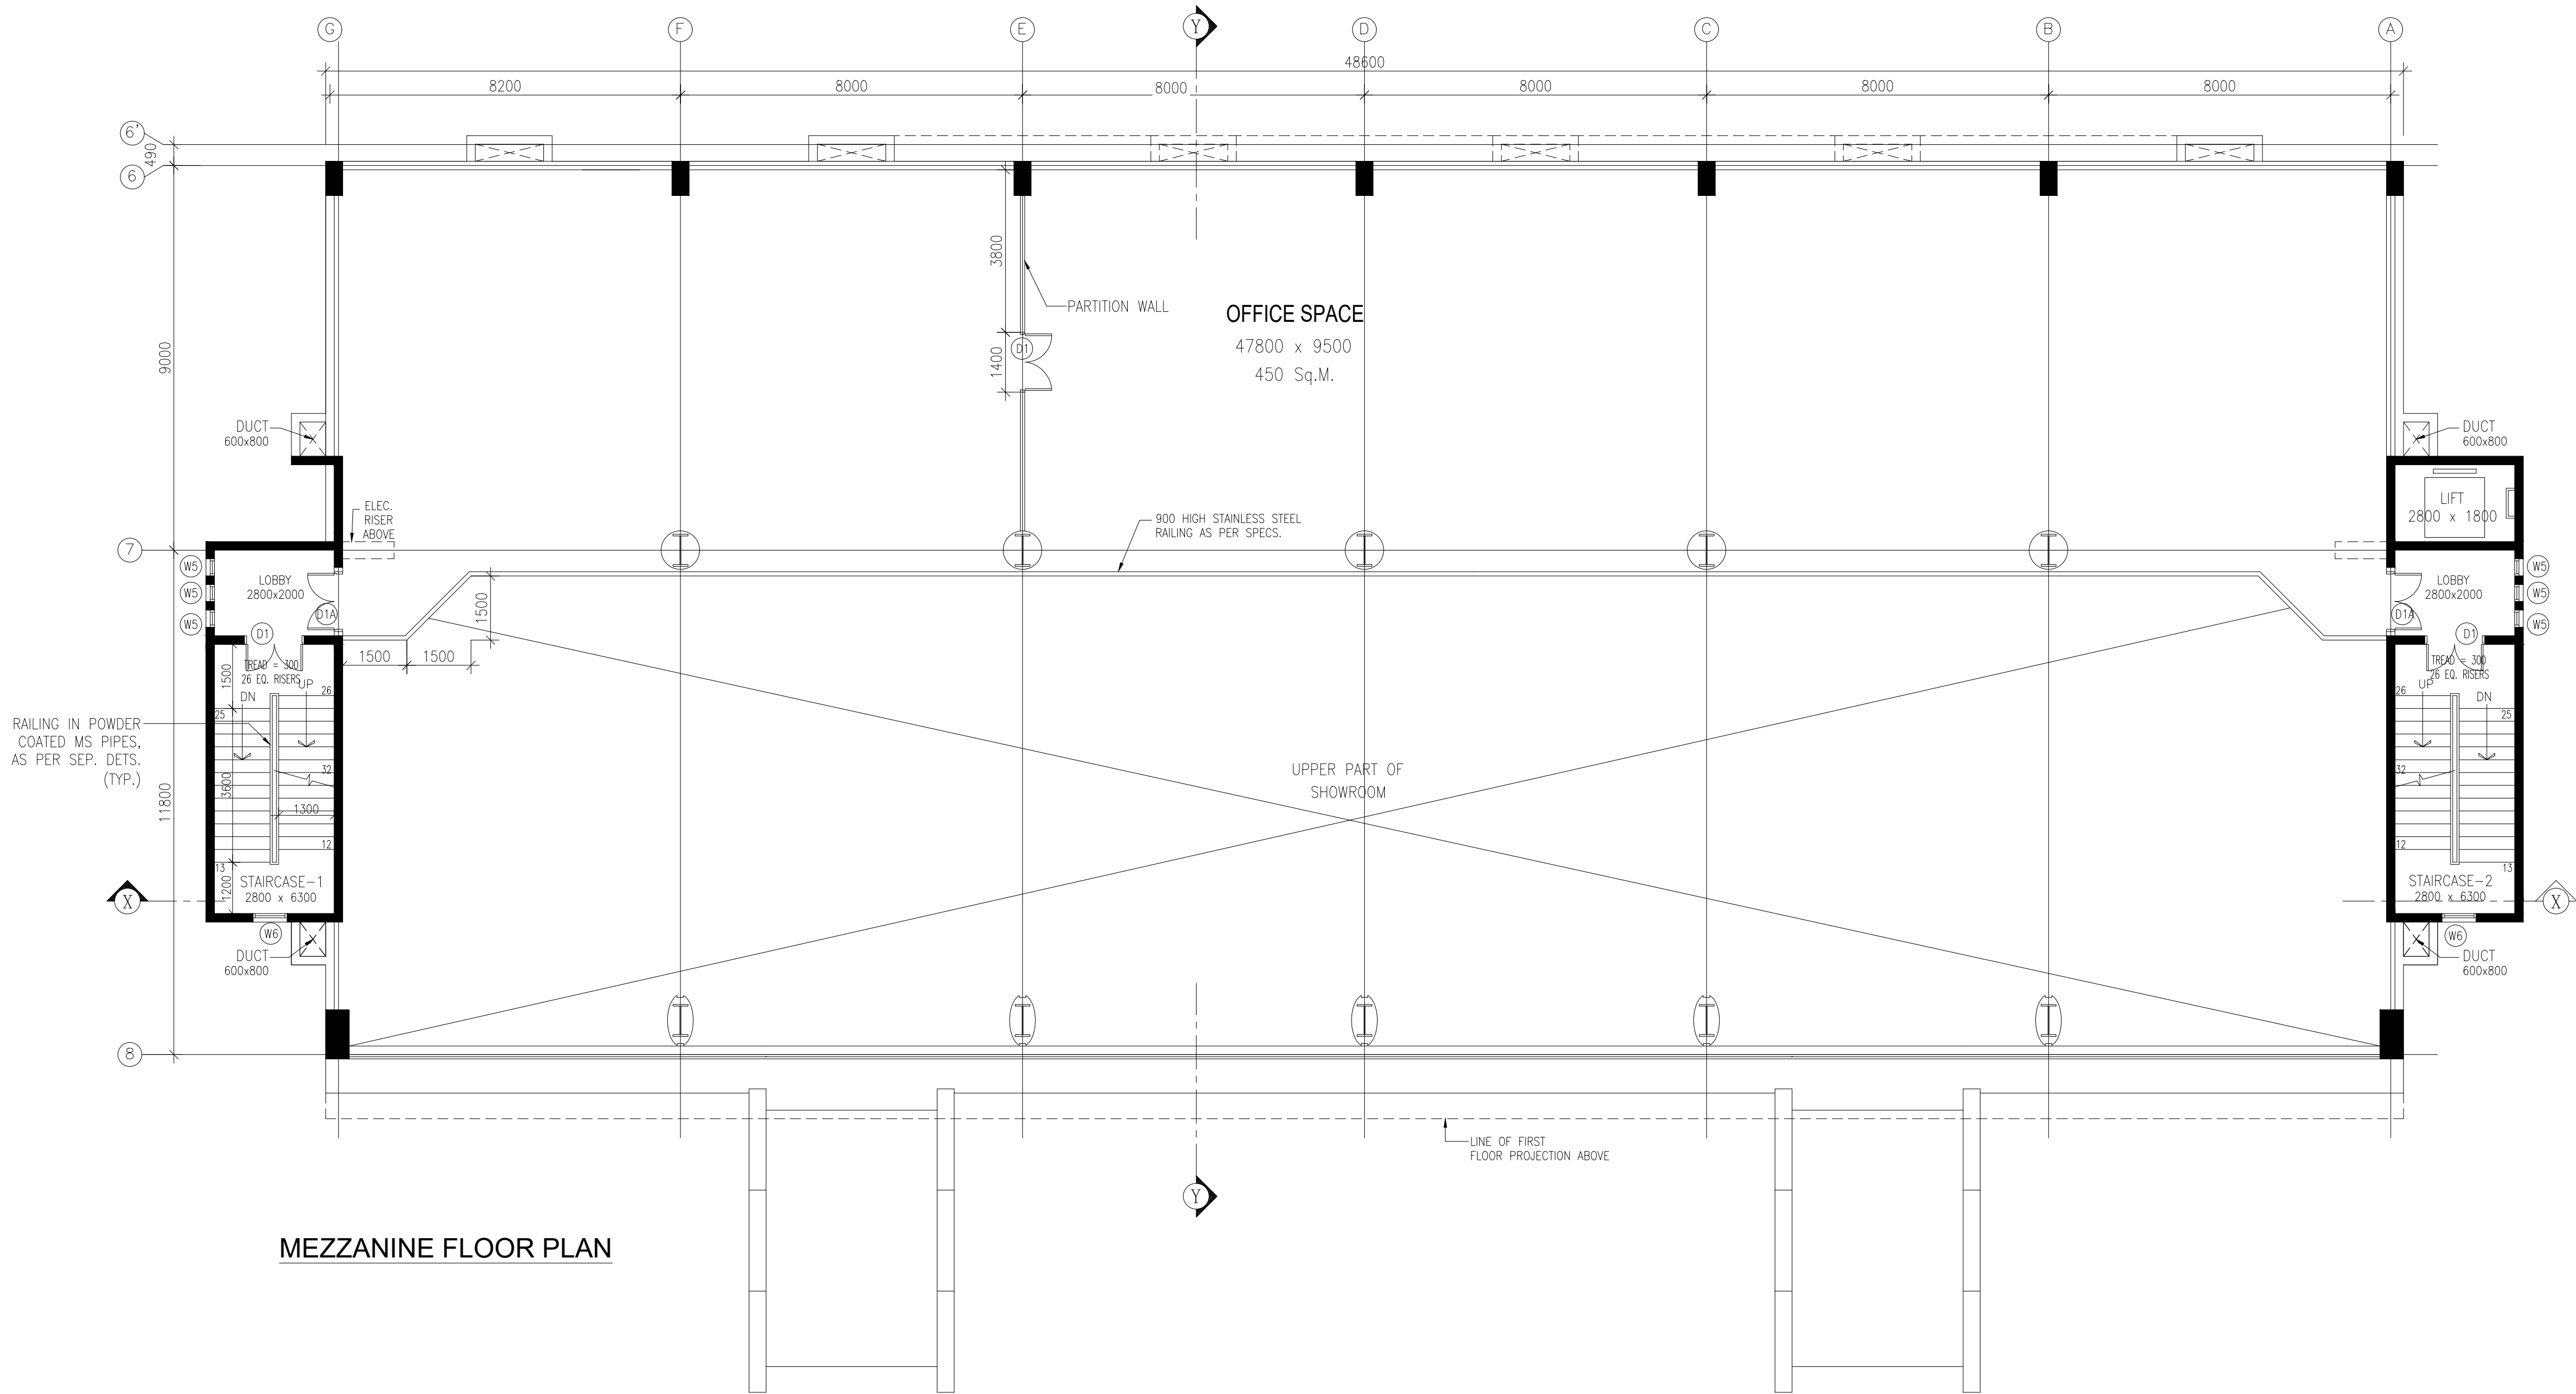

MEZZANINE FLOOR PLAN

NOTE:-
ALL DIMENSIONS ARE IN MILLIMETRES UNLESS OTHERWISE SPECIFIED.

MAY'05	R1	PARTITION WALL ADDED.	ANI
DATE	NO.	REVISION	SIGN

FOR MUNICIPALITY USE
MUSCAT MUNICIPALITY REGISTRATION NO.

AS BUILT DRAWING

استشارات قادري

KADRI CONSULTANTS

P.O. BOX 1604, JIBROO, POSTAL CODE 114, SULTANATE OF OMAN, TEL:795632 FAX:796091
FLAT NO. 301, BLDG. NO. 701, WAY NO. 2911, AL FARISAN STREET, RUWI

CLIENT	SUHAIL BIN SALEM ABDULLAH BAHWAN AL-MUKHEINY				
PROJECT	PROPOSED SHOWROOM PARTS STORE / WORKSHOP / ACCOMMODATION				LOCATION
					PLOT NO.1233 &1398 BURAIMI HAMASSA
TITLE	MEZZANINE FLOOR PLAN (SHOWROOM/ ACCOMMODATION BUILDING)				
SCALE	DATE	DRAWN	APPROVED	CHECKED	PROJECT NO.
1:100	MAR'04	VINOD	M.B	R.B	P-0303
ALL THE DRAWINGS ARE THE PROPERTY OF KADRI CONSULTANTS L.L.C. AND CANNOT BE USED WITHOUT THEIR WRITTEN PERMISSION. ALL THE PRINTS, SPECIFICATIONS AND THEIR COPY RIGHTS ARE THE PROPERTY OF KADRI CONSULTANTS L.L.C. & SHALL BE RETURNED AFTER THE COMPLETION OF WORK. CAD DWG No:-					DRG.NO. 10.03

