
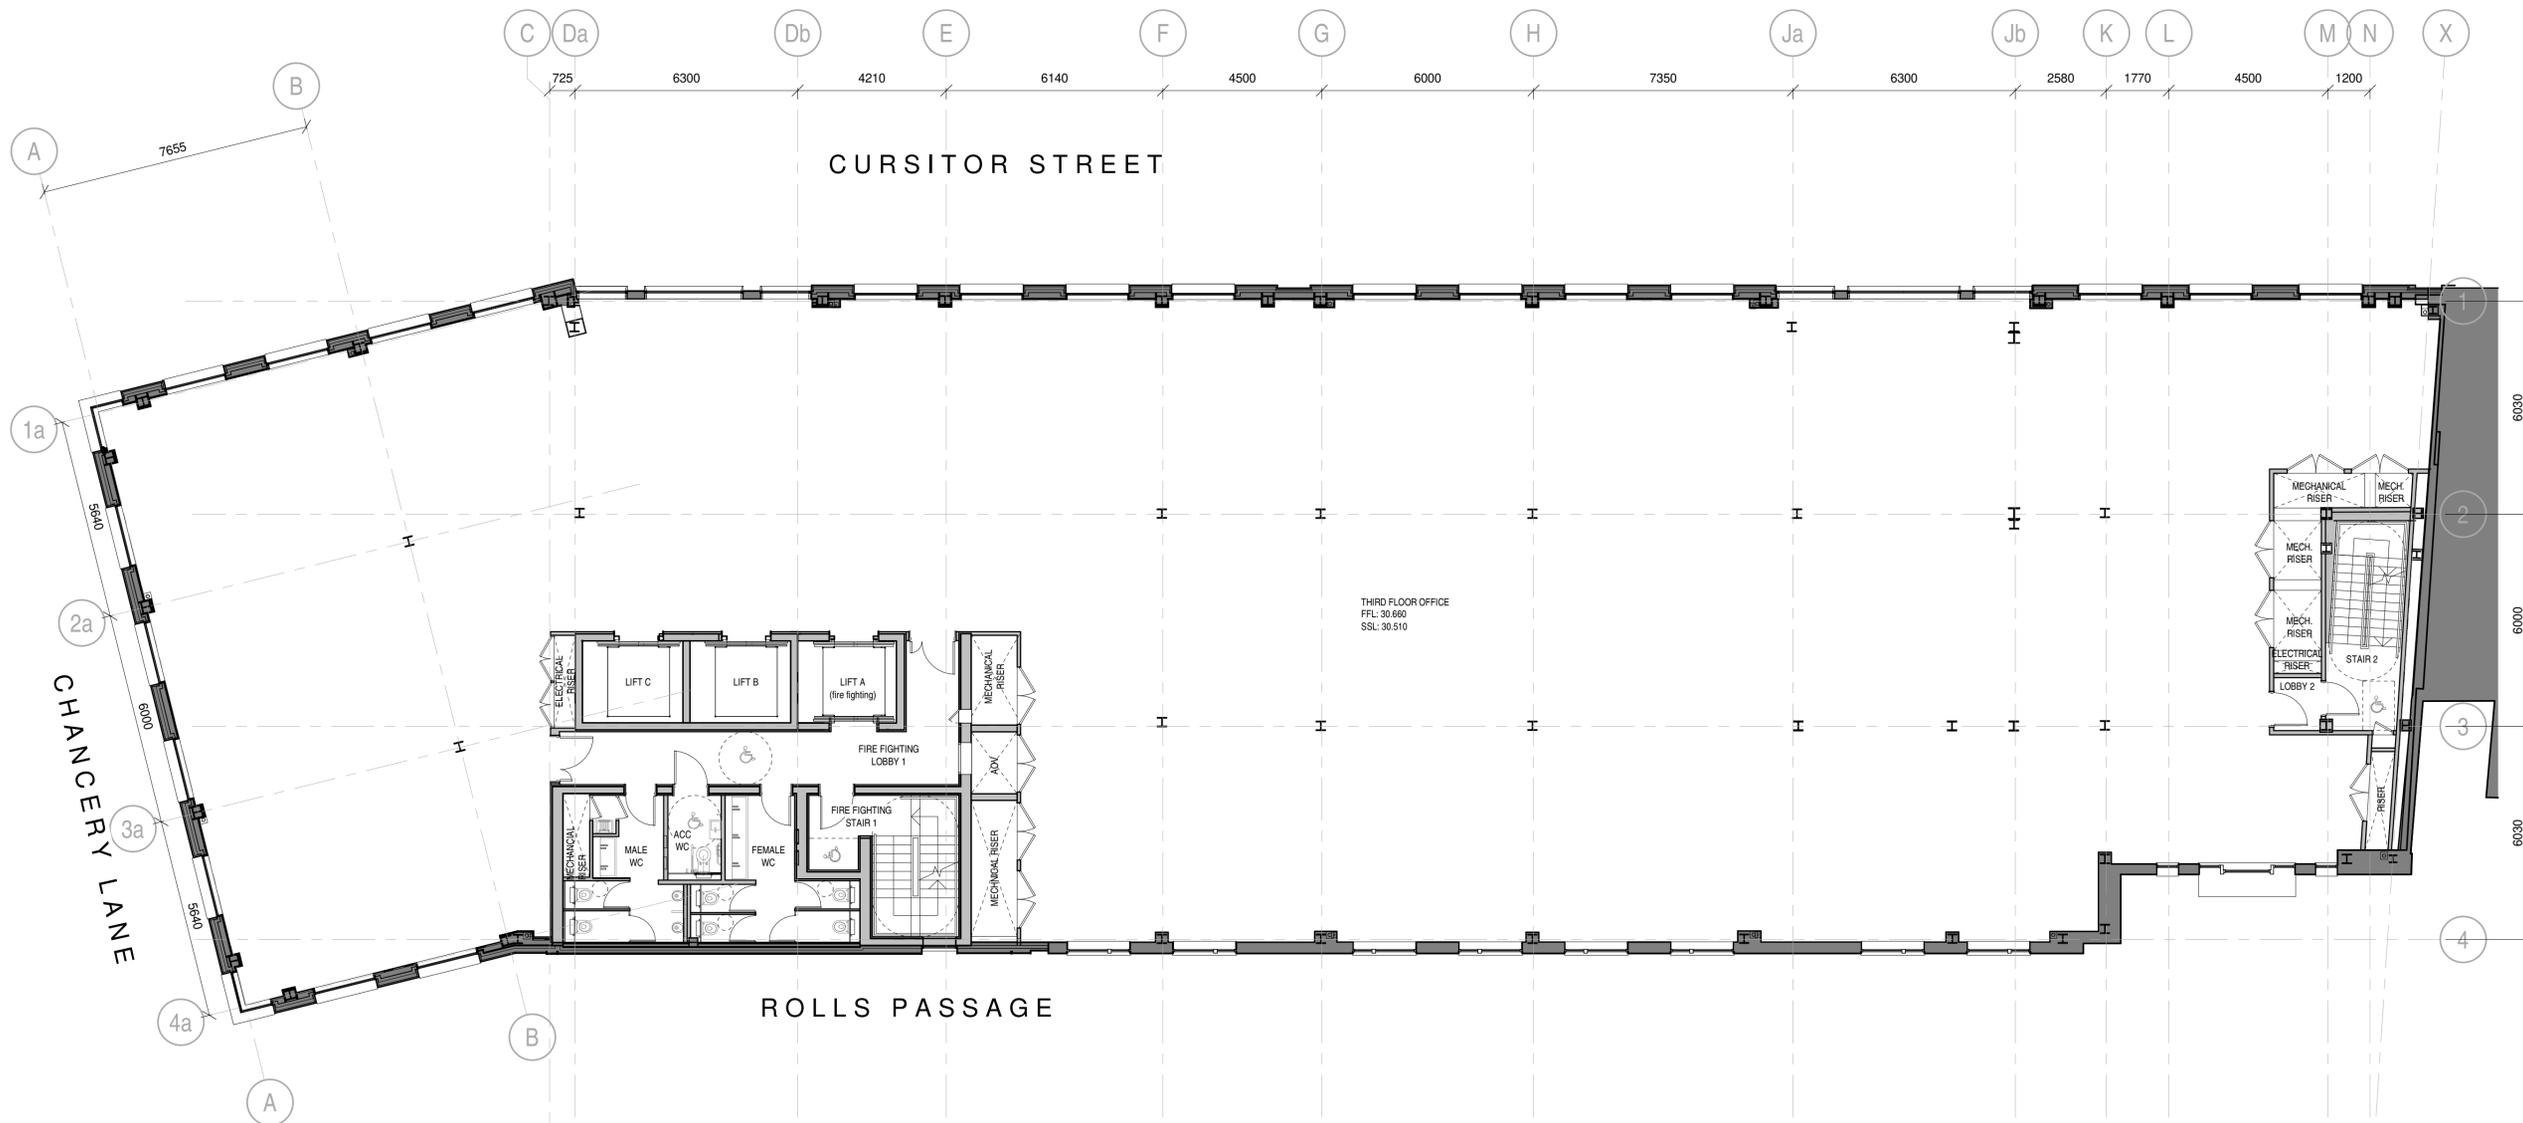


DO NOT SCALE THIS DRAWING

Contractors are to check all dimensions prior to commencement on site and notify the architect of any errors, omissions, or discrepancies.

TateHindle Limited retain copyright of this drawing. It may not be copied, altered or reproduced in any way without their written authority.

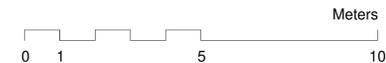

| 01 | As Built | 05/07/24 | JS | SB |
|-----|-------------|----------|-------|---------|
| Rev | Description | Date | Drawn | Checked |

Status
As Built

Client
DEKA IMMOBILIEN INVESTMENT GMBH

Project
THE CURSOR BUILDING

Drawing
POST SOFT STRIP THIRD FLOOR PLAN

| Scale at A1 | Date | Drn | Project no. | Suitability |
|-------------|------|-----|-------------|-------------|
| 1 : 100 | | VS | 15683 | |

| Drn | Revision |
|---|----------|
| 15683 - THA - BA - 01 - DM - A - S03203 | 01 |

TateHindle
168 Shoreditch High Street
London E1 6HU

T 020 7332 4850
mail@tatehindle.co.uk
www.tatehindle.co.uk

1 POST SOFT STRIP THIRD FLOOR PLAN
1 : 100