


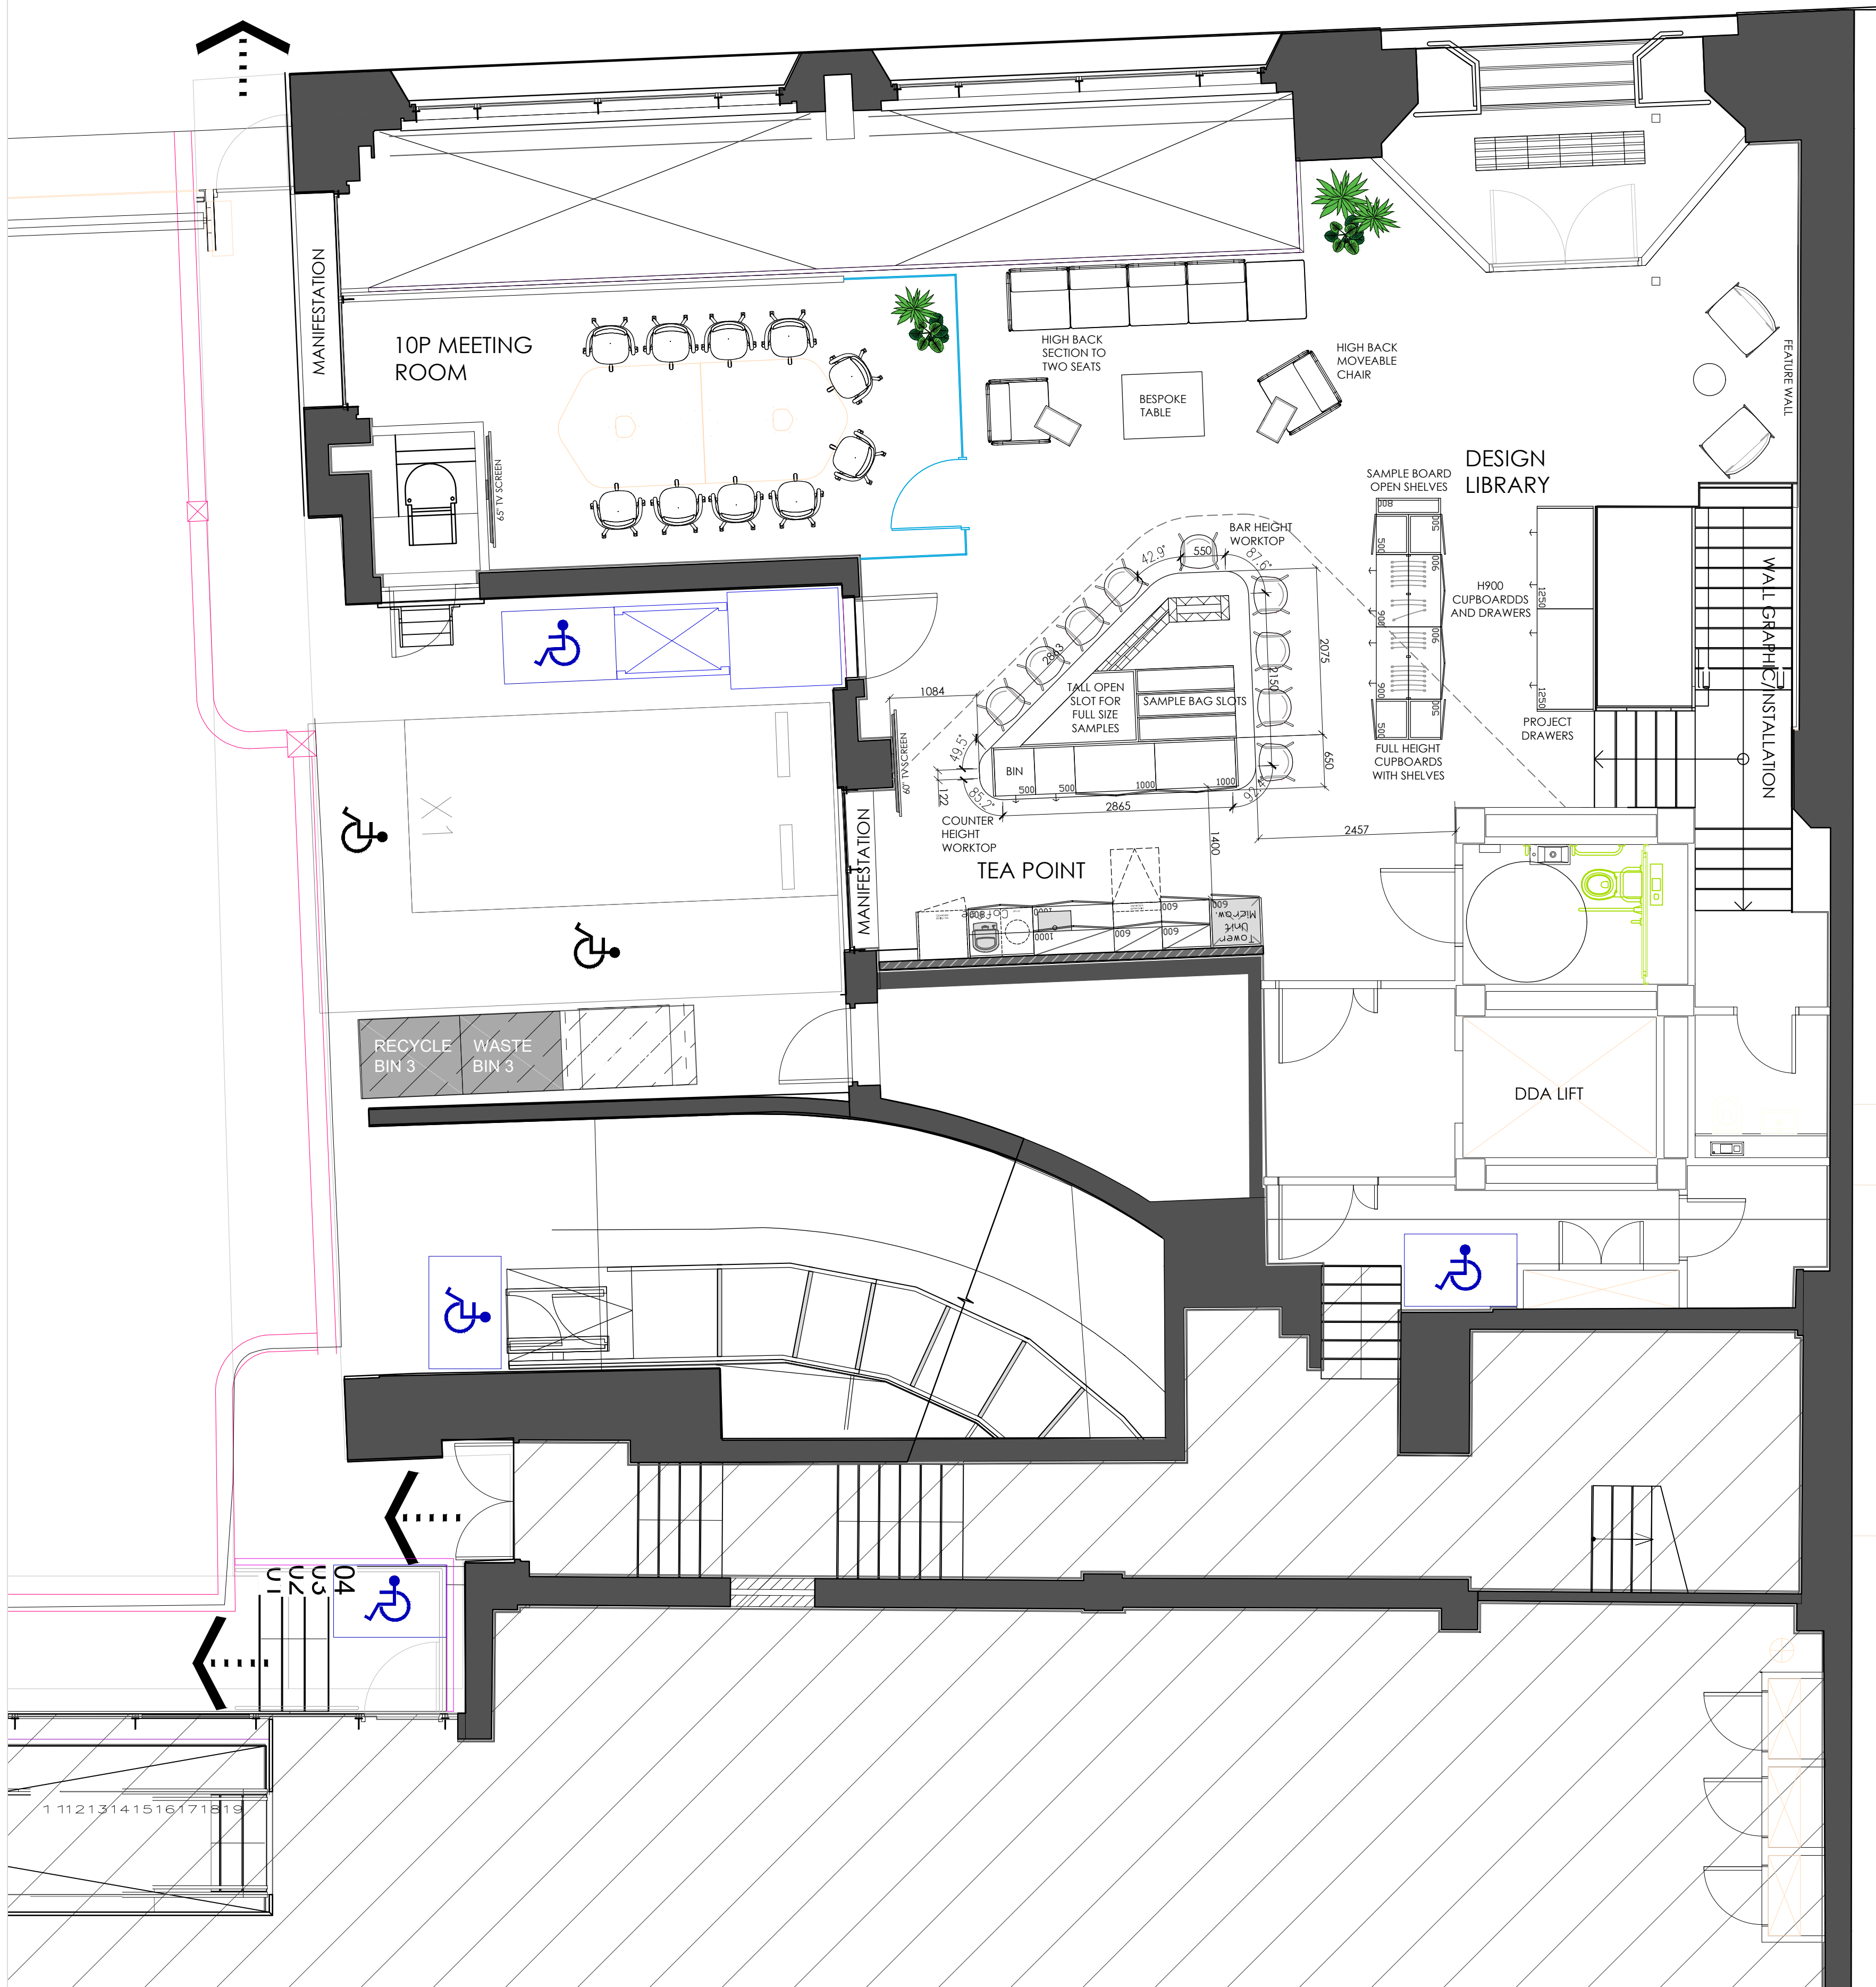

GENERAL ARRANGEMENT LEGEND

EXISTING PARTITIONS	NEW PARTITIONS	GLAZING	WINDOW MODULE
DOOR	GLASS DOOR	DOUBLE DOOR	SINGLE GLASS DOOR
HOSPITAL DOOR	SLIDING SOLID DOOR	SLIDING GLASS DOOR	
JOINERY ITEM	STOREWALL	COATS CUPBOARD	
NEW FURNITURE	EXISTING FURNITURE	RELOCATED FURNITURE	EXPANSION FURNITURE
CUPBOARD DESK HEIGHT STORAGE	TAMBOUR MID HEIGHT STORAGE	OPEN SHELVING TALL STORAGE	

FLOOR NUMBER: 01-05
ROOM NAME: XX
ROOM NUMBER: XX
OCCUPANCY: XX

D	AS BUILT	SF	26/04/24
C	ISLAND DIMS/SETTING OUT ADDED	SF	11/03/24
B	UPDATED FOLLOWING DM/SB COMMENTS	SF	22/02/24
A	CONTRACT ISSUE	SF	16/02/24
-	LTA ISSUE	SF	08/02/24
REV	DESCRIPTION	DRWN	DATE

DRAWING STAGE: AS BUILT

CLIENT: ECHOSPACE

SITE ADDRESS: 50 WORSHIP STREET, SHOREDITCH, LONDON

PROJECT DIRECTOR: DAVID MURRAY

PROJECT DESIGNER: SAMANTHA FEENEY

DRAWING TITLE: GROUND FLOOR GENERAL ARRANGEMENT PLAN

SCALE: 1:50	PAPER SIZE: A1	DRAWN BY: SF	DATE: 25.01.24
PROJECT NO.: ES23258	BLD. NO.: 01	FLOOR: 00	DETAIL: GA
		STATUS: AB	REV.: AB

GENERAL ARRANGEMENT GROUND FLOOR

0 500 1000 2000 3000 4000 5000mm

ECHOSPACE

79-81 PAUL STREET, LONDON EC2A 4HQ
www.echospace.co.uk