



© copyright reserved;this drawing remains the property of Workspace Interiors Limited and must not be copied or shown to a third party without prior consent.

While the utmost is taken to ensure the accuracy of the data and design detail shown on this drawing, the company is in no circumstances to be liable for any injuries, expense or loss which may in any degree be attributed to the use or adoption of such data and design details.

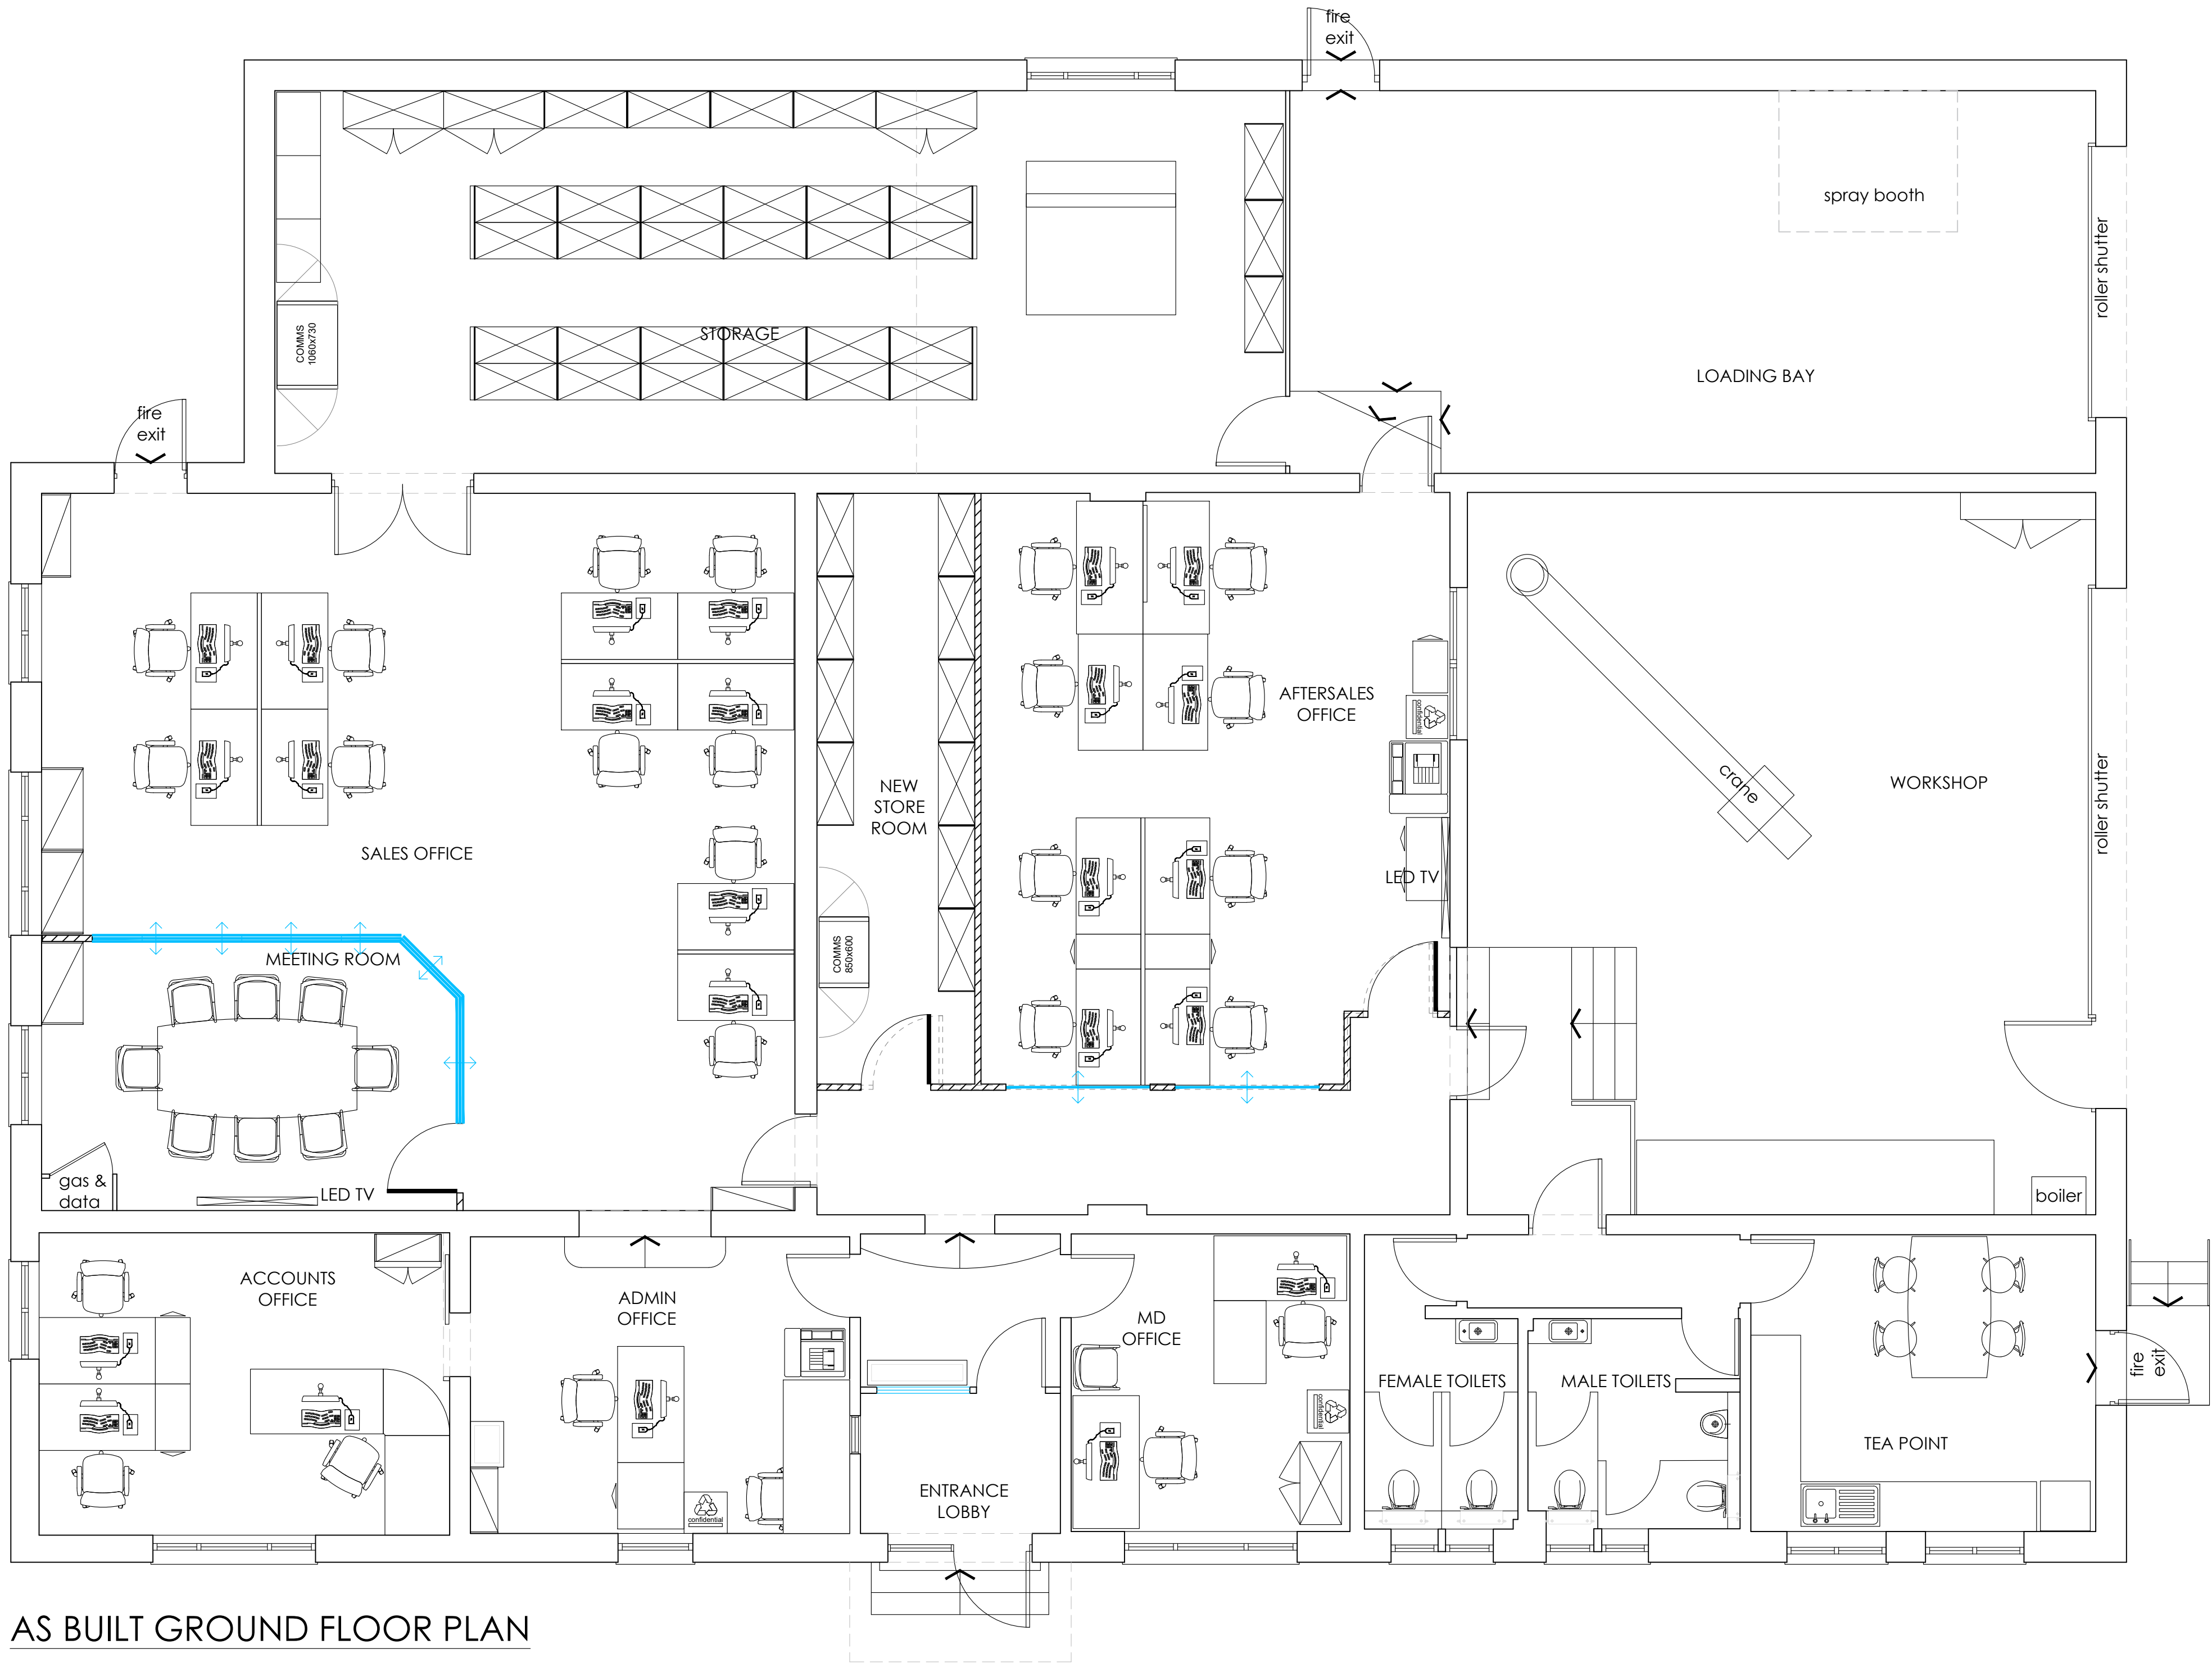

AS BUILT GROUND FLOOR PLAN

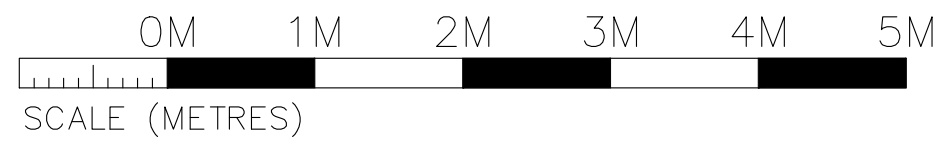

Date:	Revision Note:	Rev No:
		
Workspace Interiors Limited 7 The Gavel Centre, Porters Wood, St Albans, Hertfordshire, AL3 6PU T: +44(0)1727 839750; E: info@workspace-interiors.co.uk		
Client: Kinder-Janes Engineers Limited		
Site Address: Porters Wood St Albans AL3 6HU		
Drawing: Ground Floor General Layout AS BUILT		
Drawn by: BM	Date: November '22	Scale: 1:50 @ A1
Project No: 221415	Revision: AB	Drawing No: 221415/G/GL/AB