

- Eaves 5.3'2m


- 3 phase
- Educt

12.58

3.64

GROUND FLOOR SITE WORKS PLAN

21.59

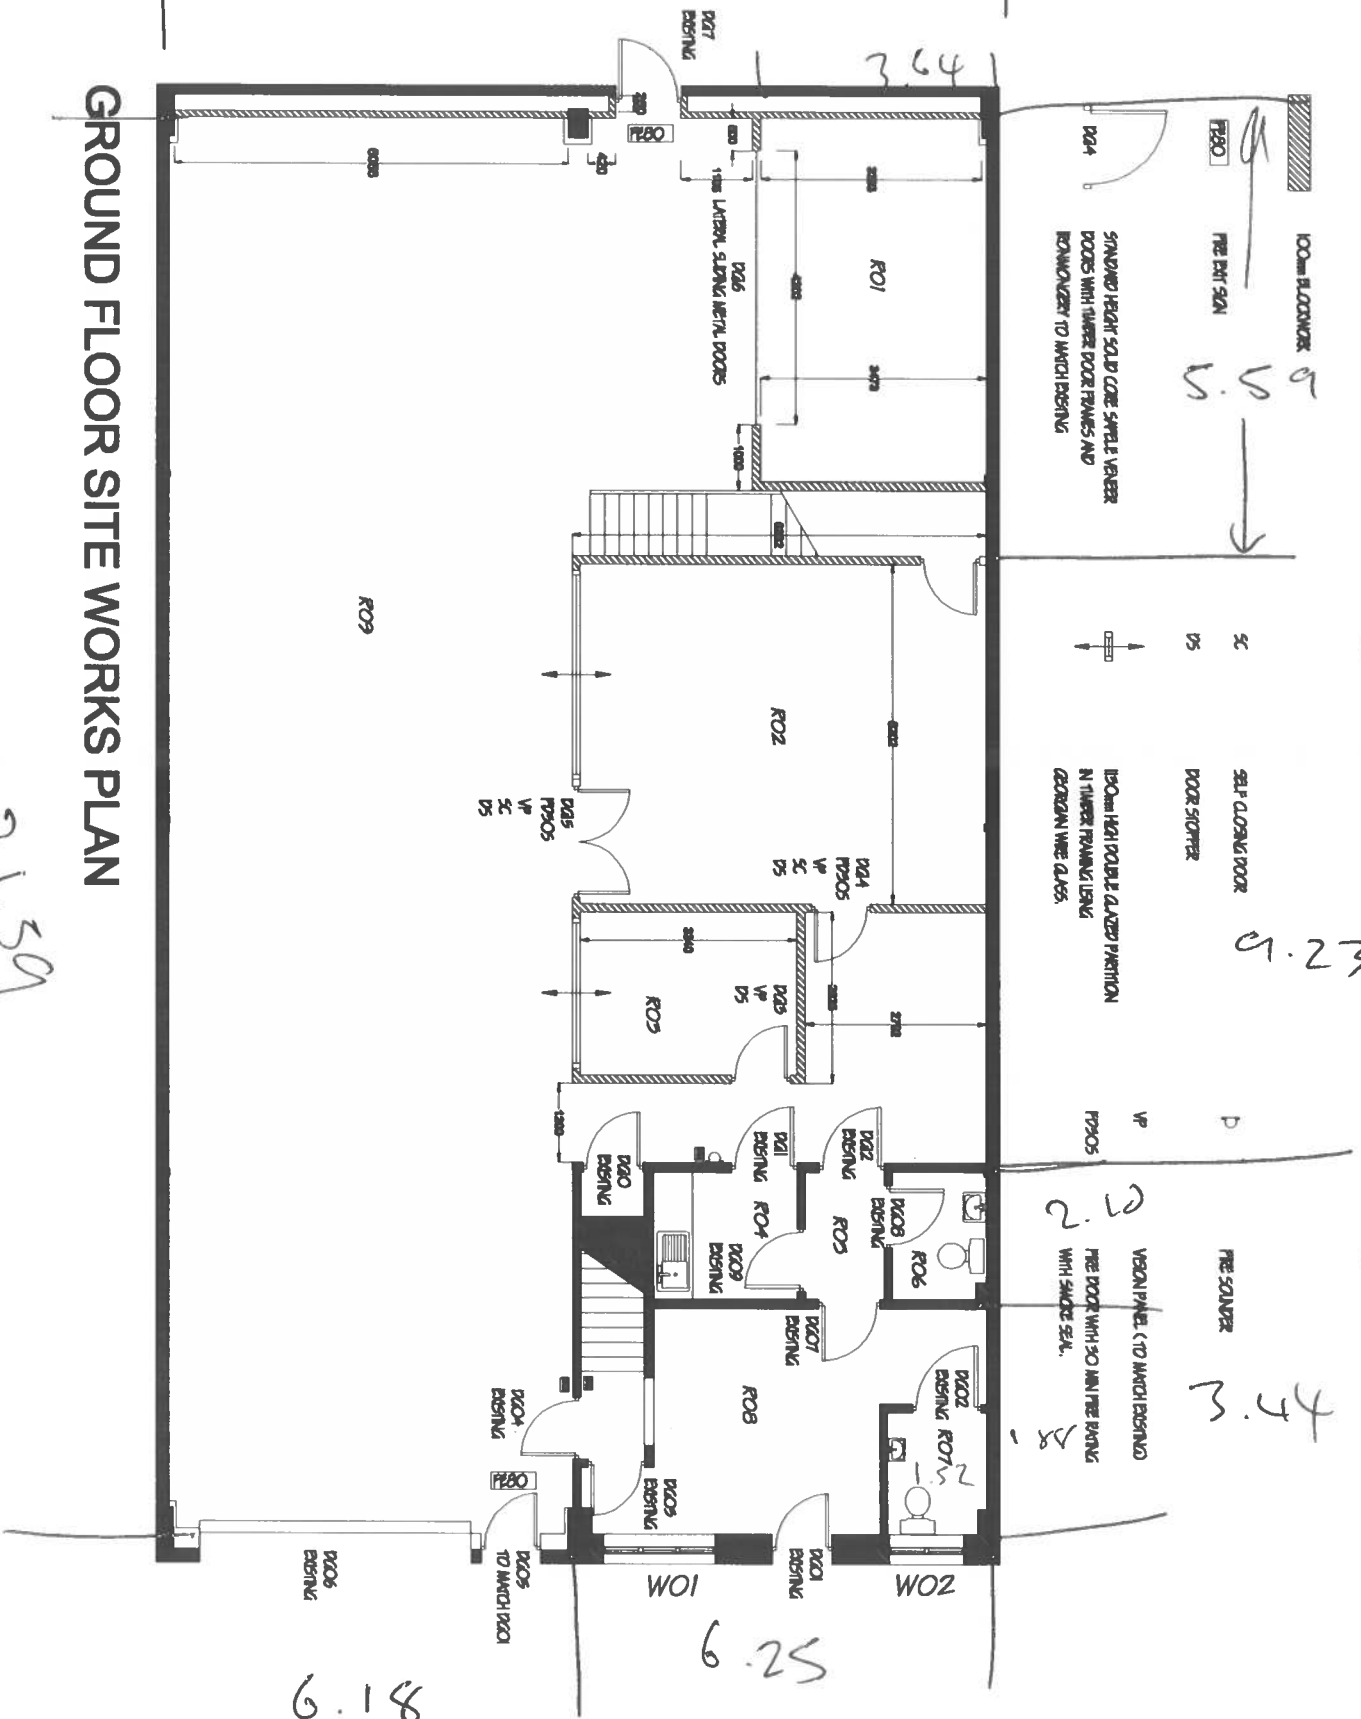

100mm BLOORWORK

NET BIT SEAL

STANDARD HEIGHT SOLID CORE SWELL VANEER DOORS WITH THINER DOOR FRAMES AND BOUNDMANZEE TO MATCH DESIGN

6.5.5

SC DS

SELF CLOSING DOOR DOOR STOPPER

150mm HIGH SOLID GLASS PARTITION IN THINER FRAMING USING GEORGIAN WIRE GLASS

9.23

NET SOLVER

VIBRA PANEL (TO MATCH DESIGN) THE DOOR WITH 30 MM NET DESIGN WITH SWAGE SEAL.

3.74

6.25

6.18

<p>AS BUILT</p> <p>R. Konstantinidis</p>		<p>LAMB SIGNS</p> <p>UNIT 101, RHODESIA PARK DIAMOND ROAD HOWICK, NORFOLK WARE 800</p> <p>GROUND FLOOR SITE WORKS PLAN</p>		<p>REVISIONS</p> <table border="1"> <tr> <th>NO.</th> <th>DESCRIPTION</th> <th>DATE</th> </tr> <tr> <td> </td> <td> </td> <td> </td> </tr> </table>		NO.	DESCRIPTION	DATE				<p>GENERAL NOTES</p> <ol style="list-style-type: none"> 1. All work to be done in accordance with the contract documents. 2. All materials to be of standard quality and to be approved by the architect. 3. All work to be done in accordance with the relevant building codes and regulations. 4. All work to be done in accordance with the relevant safety regulations. 	
NO.	DESCRIPTION	DATE											

