

## NOTES

ZERO WORKSPACE LIMITED DO NOT ACCEPT LIABILITY FOR ANY ERRORS AND OMISSIONS ARISING FROM THE PREPARATION OF BASE BUILD DRAWINGS WHICH ARE DERIVED FROM ORIGINAL MATERIAL PROVIDED BY OTHERS.


ALL DISCREPANCIES ARE TO BE REPORTED TO ZERO WORKSPACE.

GRID LINES ARE FOR REFERENCE PURPOSES ONLY.

ALL DIMENSIONS TO BE VERIFIED BY CONTRACTOR ON SITE PRIOR TO ANY WORKS COMMENCING.

DO NOT SCALE FROM THIS DRAWING. PROPOSALS ARE SUBJECT TO APPROVALS BY STATUTORY AUTHORITIES.

THIS DOCUMENT IS THE PROPERTY OF ZERO WORKSPACE LIMITED. COPYRIGHT IS RESERVED BY THEM, AND THE DRAWING IS ISSUED ON THE CONDITION THAT IT IS NOT COPIED, REPRODUCED OR RETAINED BY, NOR DISCLOSED TO ANY UNAUTHORIZED PERSON, EITHER WHOLLY OR IN PART, WITHOUT THE CONSENT IN WRITING FROM ZERO WORKSPACE LIMITED.

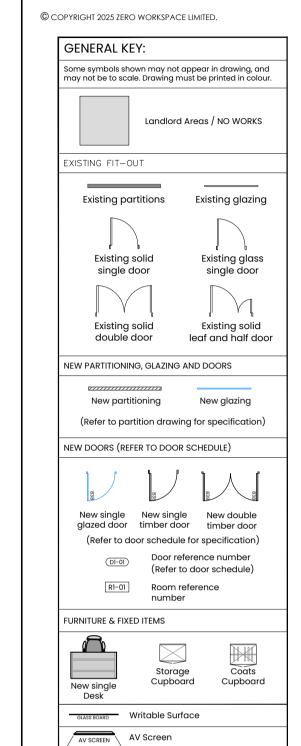

	REVISION DETAIL							
ĺ	REV	DETAIL	ВҮ	DATE				
	A	ISSUE FOR AS BUILT	EM	21.07.25				

)	T	Α	T	US	

Preliminary Contract

Construction Asbuilt

CLIENT

MONITOR CAPITAL INVESTORS

PROJECT ADDRESS 100 CANNON ST

LONDON

EC4N 6EU

4TH FLOOR GA

DRAWING TITLE

SCALE @A1: 1:50 SCALE @A3: 1:100 18.06.25

DRAWN BY: EM CHECKED BY: TM

009 DWG NO:

PROJECT NO: 195

FLOOR: 04 DETAIL: GA REVISION: A STATUS: AB

## zero workspace

ZERO WORKSPACE LIMITED.

30 Gresse Street, London W1T 1QR

Tel. 0207 046 6290 Email. hello@zero-workspace.com Web. zero-workspace.com