


Fourth Floor
1 : 300

ACCOMODATION SCHEDULE
169.6 sq m - 1,800 sq ft

AMENITIES	QTY
Meeting Rooms (10+)	1
Meeting Rooms (4+)	0
Meeting Rooms (2+)	1
Booth	0
Collaboration	1
Lounge	1
Open Plan Desking	14
Teapoint/ Breakout	1
Comms	0
Print Point	1

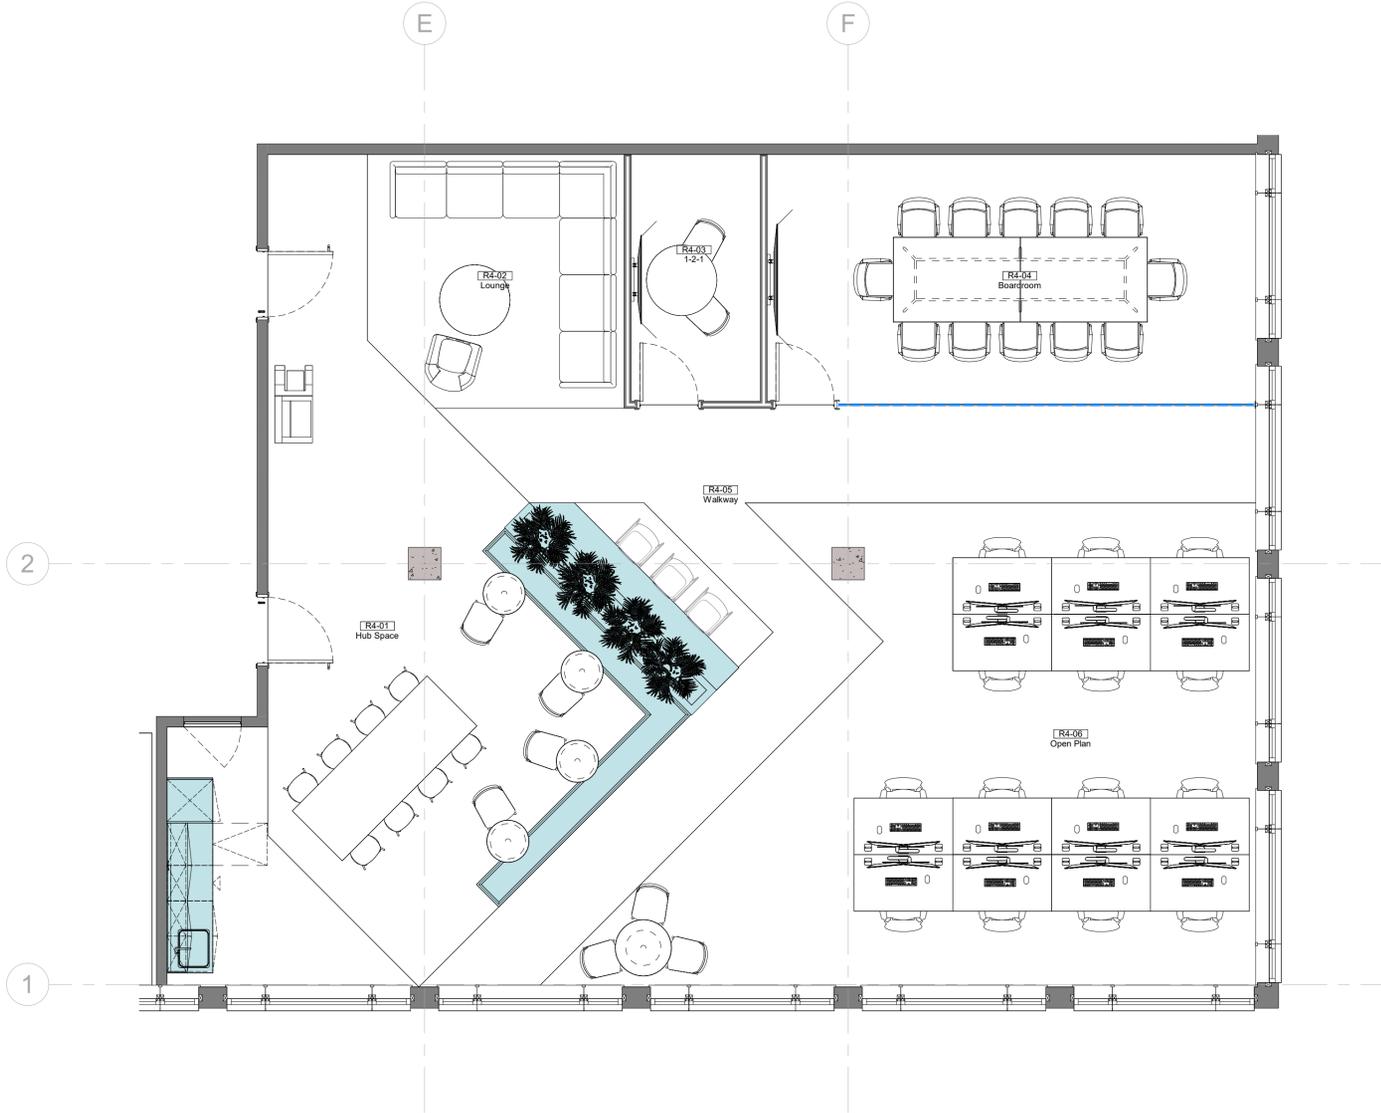

Fourth Floor - General Arrangement
1 : 50

GENERAL ARRANGEMENT LEGEND

Symbols shown are not to scale - some symbols may not appear on the layout plan

COMPONENT TAGS

R1-01 Name = ROOM - 1ST FLOOR
01 = ROOM NUMBER
Name = ROOM NAME

PARTITION REFERENCES

EXISTING WALLS
NEW SOLID PARTITIONS
NEW GLAZED PARTITIONS

DOOR REFERENCES

NEW SOLID DOOR
NEW SLIDING GLASS DOOR

FURNITURE DETAILS

NEW FURNITURE
EXISTING FURNITURE
JOINERY ITEMS
DAY 2 FURNITURE

P05	AS BUILT	FW	22-09-2023
P04	Construction Issue	FW	21-07-2023
P03	GA Updated Following Client Meeting	DEH	06-07-2023
P02	Contract Issue	DH	26-06-2023
P01	GA Amended	DH	30-05-2023
ISSUE	DESCRIPTION	DRWN	CHKD DATE

DRAWING STAGE

AS BUILT

CLIENT

CANADA LIFE

SITE ADDRESS

**ONE FORBURY SQUARE
READING
RG1 3EB**

PROJECT DIRECTOR: **SB** PROJECT MANAGER: --

PROJECT DESIGNER: **JS** TECHNICAL DESIGNER: **DH**

DRAWING TITLE

GENERAL ARRANGEMENT - FOURTH FLOOR

PROJECT NO. **1647** SCALE **As indicated @ A1** REVISION **P05**

DRAWING NO. **1647—OKT—V1—04—DR—I—0101**

Oktra Regions - Guildford
Friary Court
13-21 High Street
Guildford
GU1 3DG
+44 (0)1483 947520
oktra.co.uk



© COPYRIGHT OKTRA LTD
THIS DRAWING REMAINS THE COPYRIGHT OF OKTRA LTD, TO BE USED SOLELY FOR THE PROJECT AND INFORMATION AS TITLED. THIS DRAWING MUST NOT BE COPIED WITHOUT PRIOR WRITTEN CONSENT. CONTRACTORS ARE RESPONSIBLE FOR ENSURING ALL WORKS COMPLY WITH ALL RELEVANT STATUTORY REQUIREMENTS AND BRITISH STANDARDS. DO NOT SCALE FROM DRAWING. CONTRACTORS MUST CHECK ALL DIMENSIONS, LEVELS AND SERVICES PRIOR TO COMMENCEMENT OF ANY WORKS. OKTRA LTD MUST BE NOTIFIED OF ANY DISCREPANCIES.