
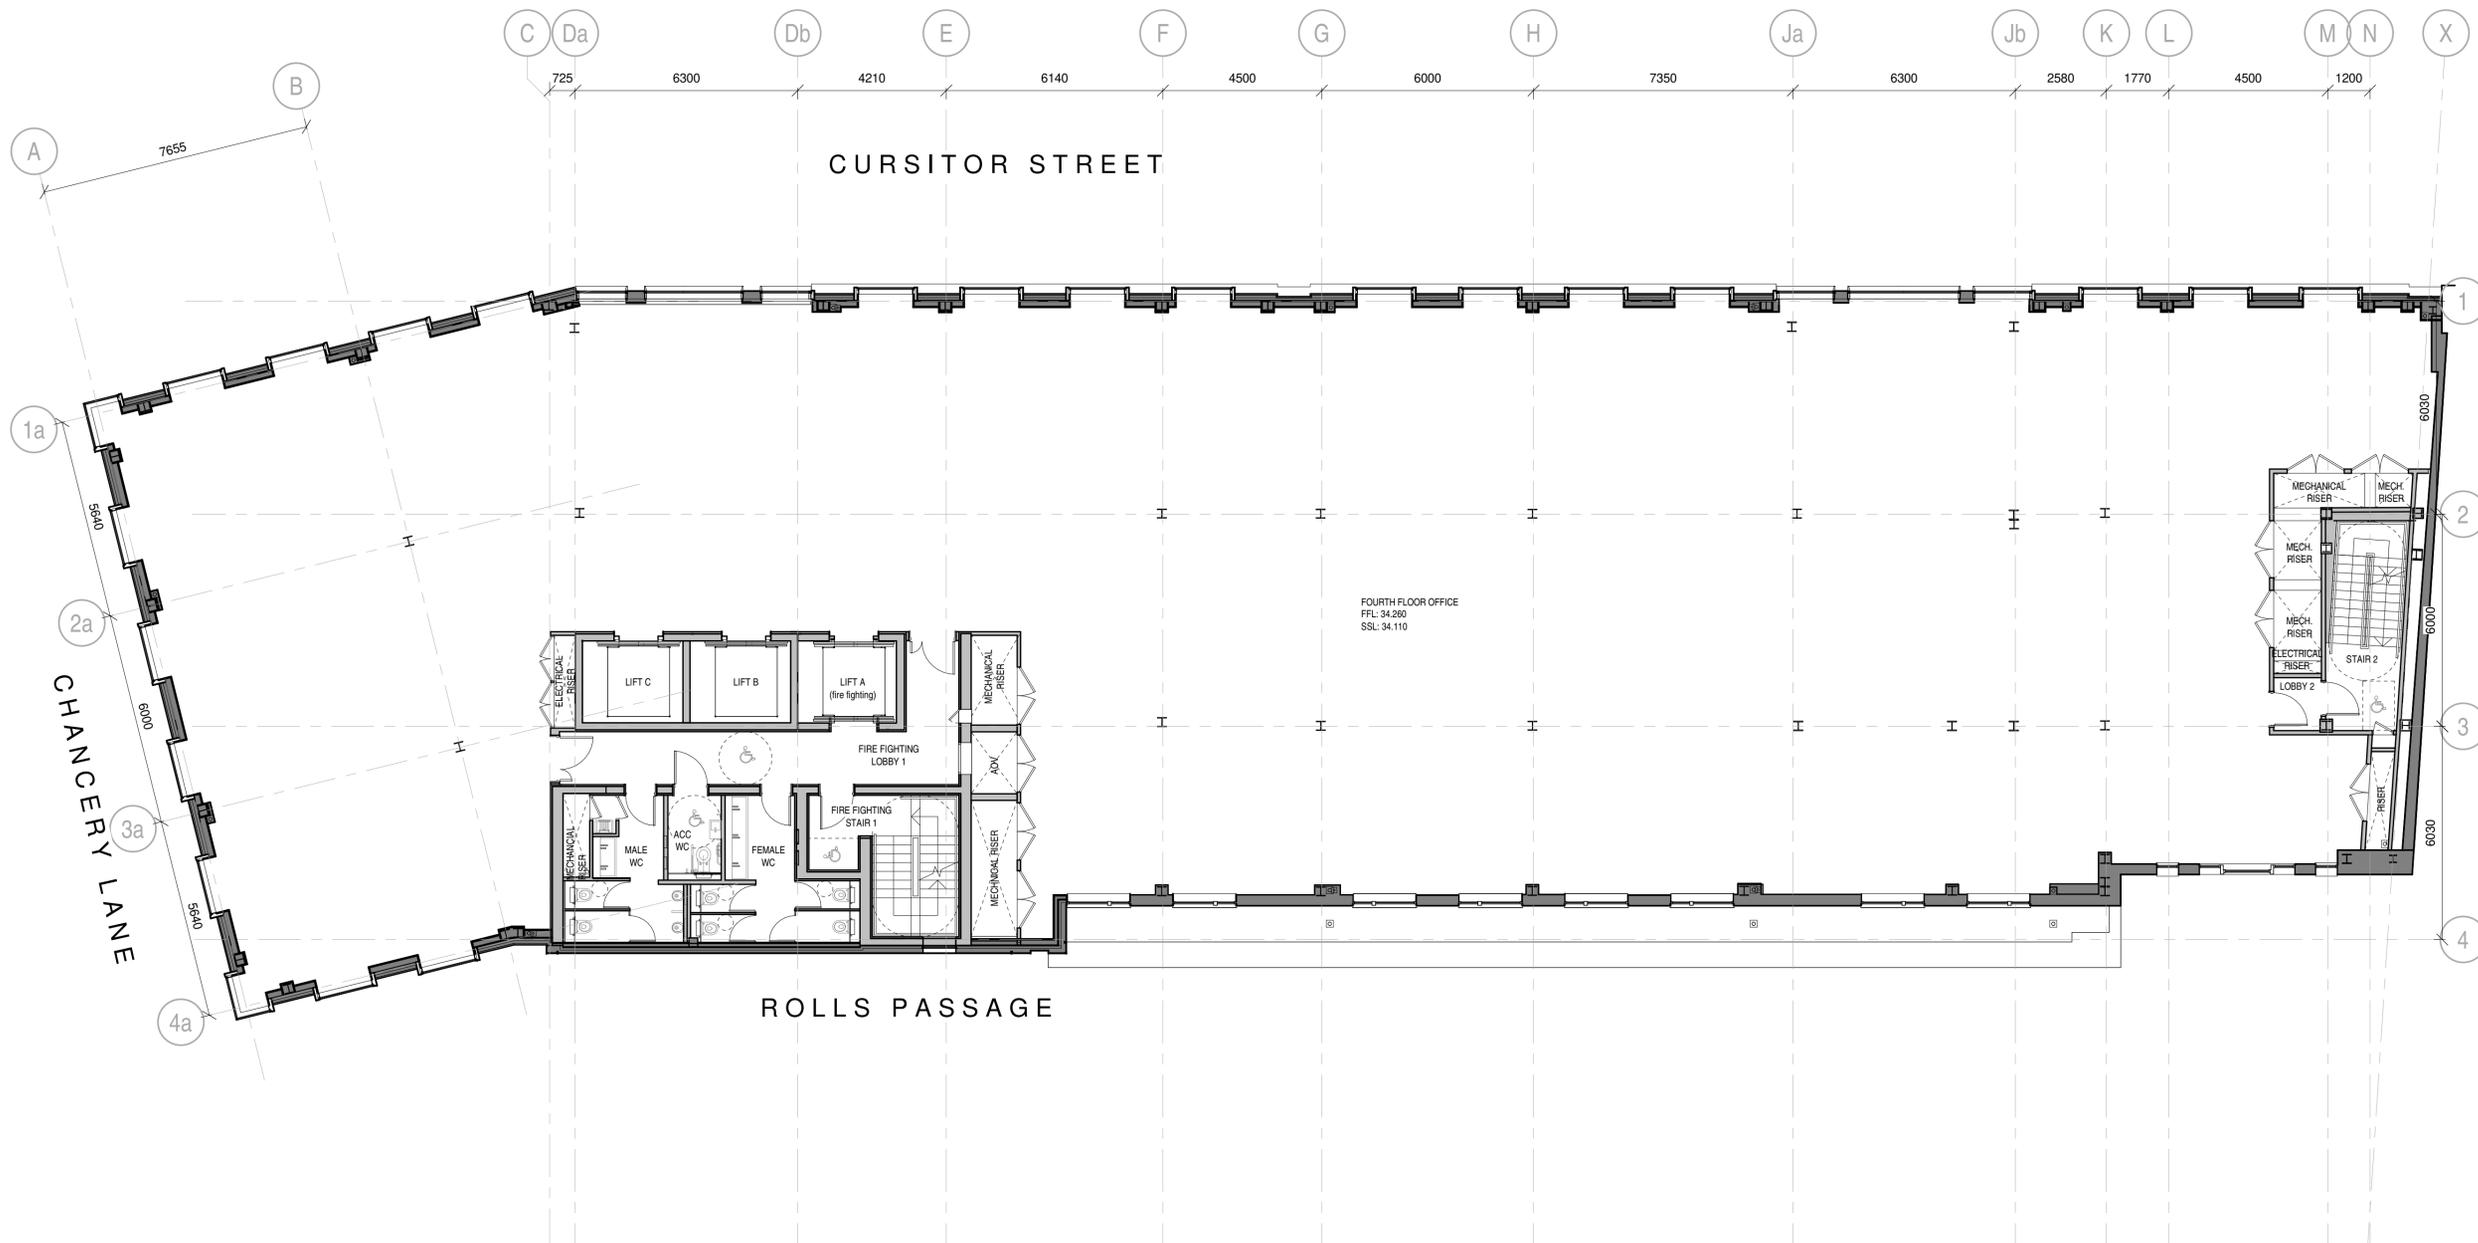


Contractors are to check all dimensions prior to commencement on site and notify the architect of any errors, omissions, or discrepancies.

TateHindle Limited retain copyright of this drawing. It may not be copied, altered or reproduced in any way without their written authority.

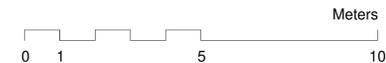

1 POST SOFT STRIP FOURTH FLOOR PLAN
1 : 100

Rev	Description	Date	Drawn	Checked
01	As Built	05/07/24	JS	SB

Status
As Built

Client
DEKA IMMOBILIEN INVESTMENT GMBH

Project
THE CURSOR BUILDING

Drawing
POST SOFT STRIP FOURTH FLOOR PLAN

Scale at A1	Date	Drn	Project no.	Suitability
1 : 100		VS	15683	

Drn	Revision
15683 - THA - BA - 01 - DM - A - S03204	01

TateHindle
168 Shoreditch High Street
London E1 6HU

T 020 7332 4850
mail@tatehindle.co.uk
www.tatehindle.co.uk