
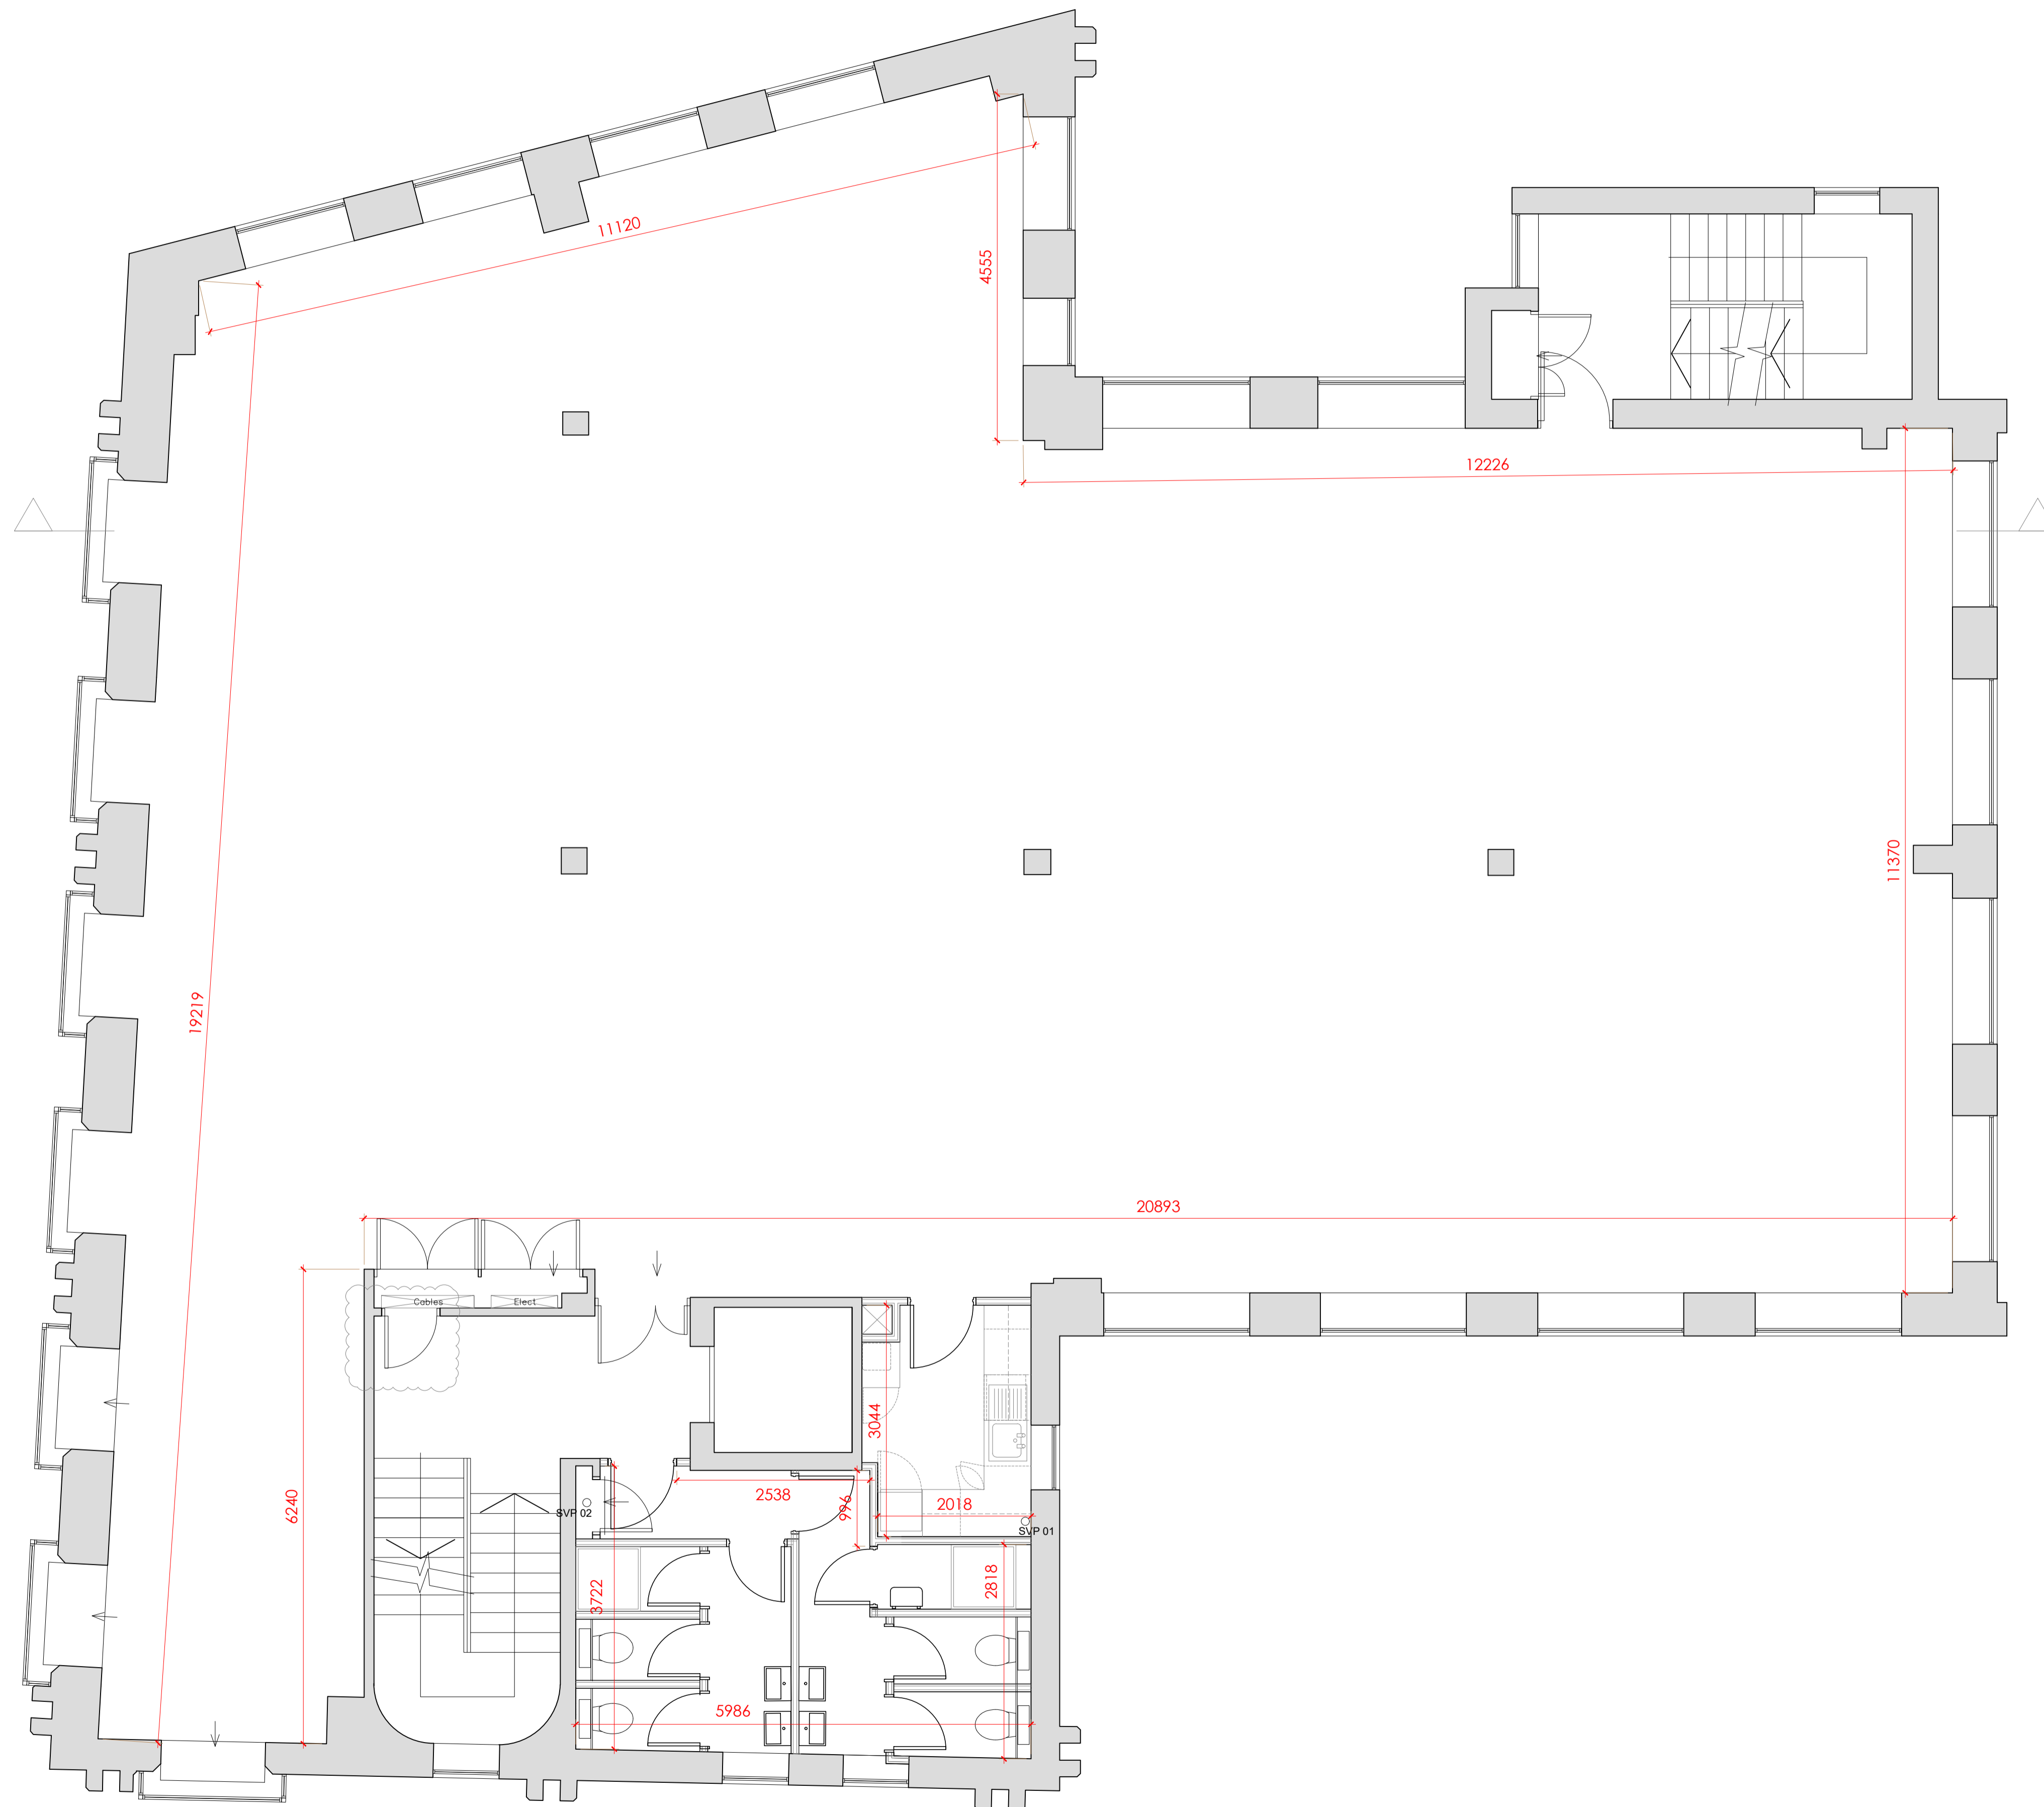
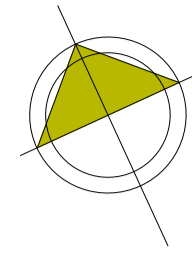


scale in metres

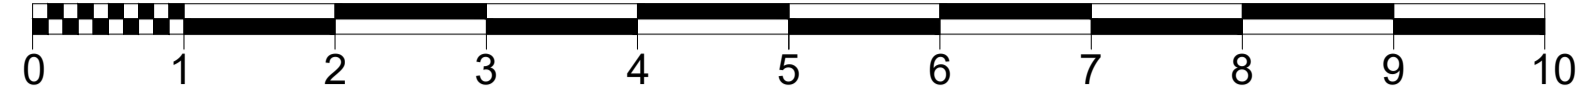

AS BUILT

title
BOSTON HOUSE, LITTLE GREEN, RICHMOND, TW9 1QE

client
CARLFORD DEVELOPMENTS LTD

description
FIRST FLOOR PLAN

date:	scale	project	drawing	revision
FEB 2021	1:50 @ A1	200102		

SILVERLINE ARCHITECTS

email: info@silverlinearchitects.com

© Silverline Architects Ltd 2021. All rights reserved. This drawing is the property of Silverline Architects Ltd. It is not to be used for any other purpose without the written consent of Silverline Architects Ltd.