


**NOTES:**  
 ALL DIMENSIONS TO BE CHECKED ONSITE.  
 ANY DIMENSIONAL DISCREPANCIES FOUND  
 ONSITE MUST BE REPORTED TO  
 DESIGNER / PROJECT MANAGER.  
 DRAWING TO BE READ IN CONJUNCTION WITH  
 ANY SPECIFICATIONS, SCHEDULES,  
 CONSULTANTS DRAWINGS AND DETAILS.  
 FULL SITE SURVEYS RECOMMENDED BEFORE  
 COMMENCEMENT OF ANY SITE WORKS.  
 LAYOUTS ARE SUBJECT TO BUILDING  
 CONTROL APPROVAL.

**REVISIONS:**


Rev	Comments	Drawn	Chk'd	Date
ASBULT		aps	ifs	11/12/17

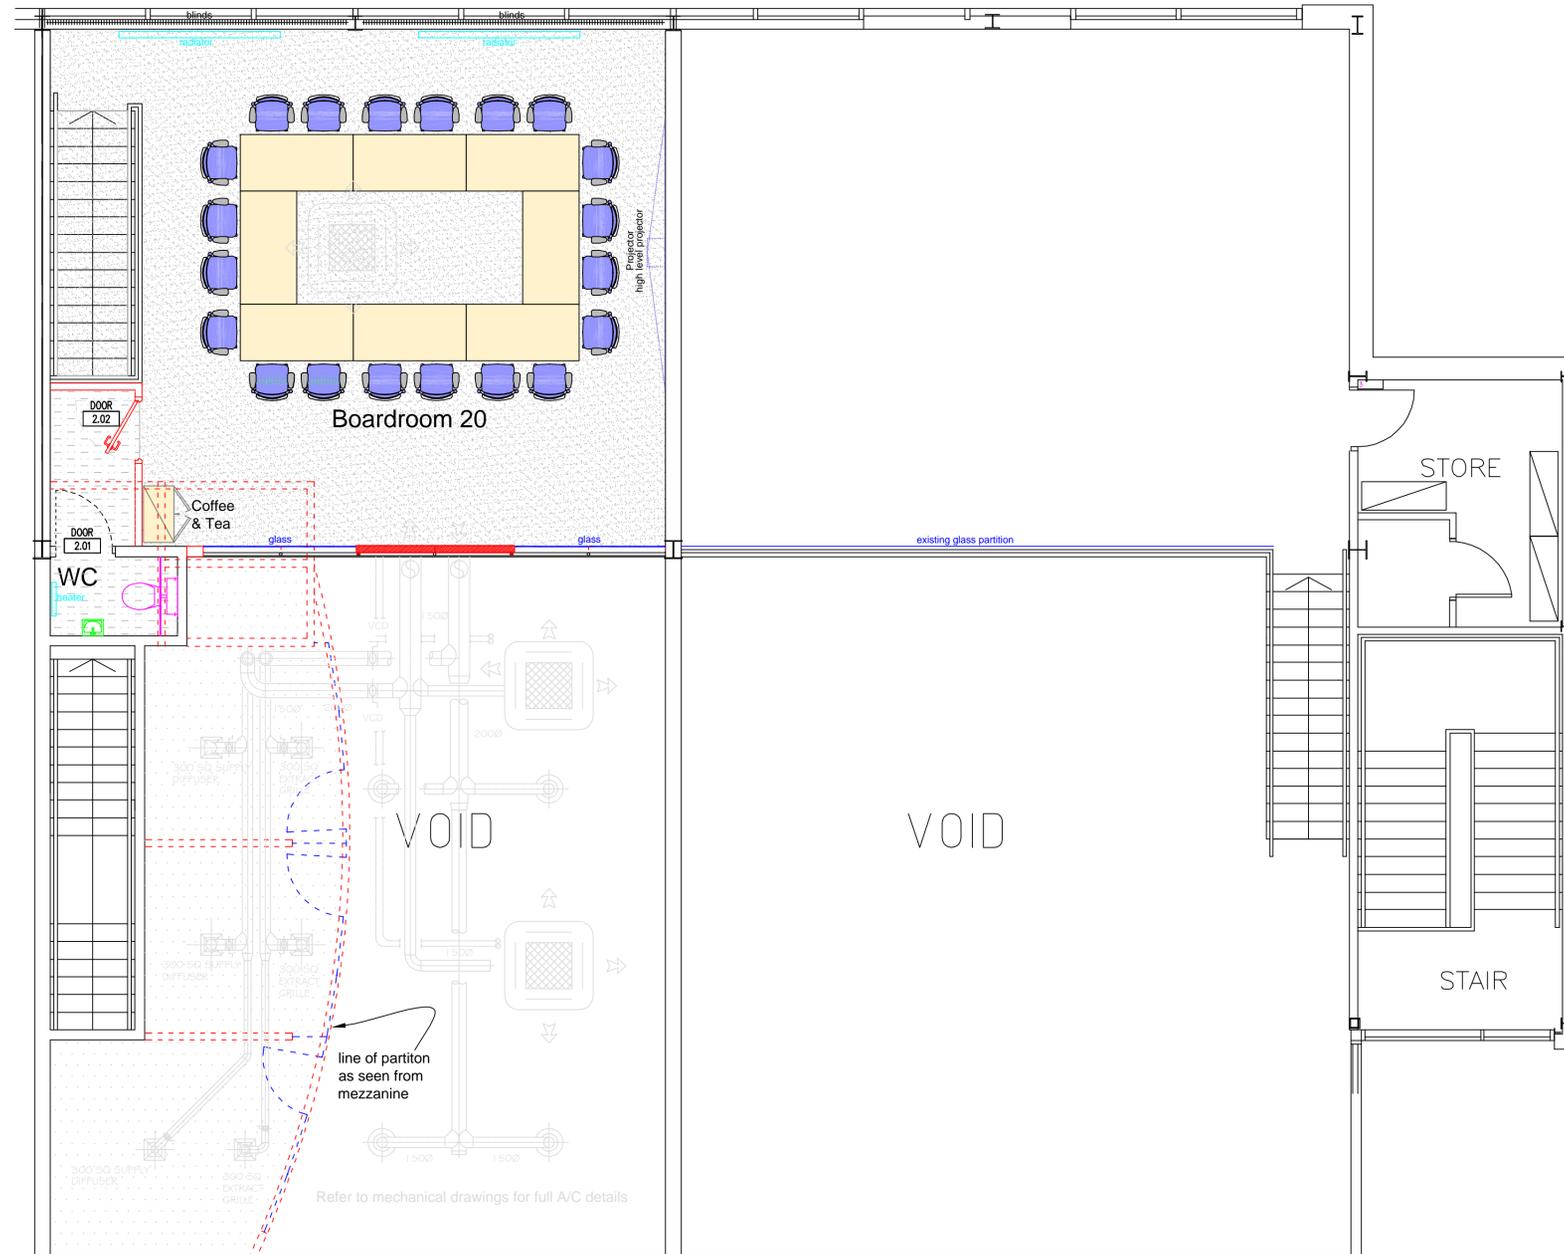

**MEZZANINE**



Loose lay rolls of artificial grass on roof of offices and toilet cubical

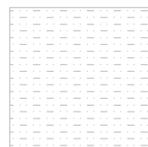

Woven vinyl tiles on plywood backing



Carpet tiles

**ASBUILT DRAWING**

SCALE 1:50@A1

CLIENT:  
PureCircle

PROJECT:  
Unit 140

DRAWING TITLE:  
General Arrangement

LEVEL:  
Mezzanine Floor



T R Project Management Construct Limited  
 Unit 1, The Old Tannery,  
 Oakdene Road,  
 Redhill, Surrey, RH1 6BT  
 (T) 01737 336 415  
 (W) www.trpmc.co.uk

DESIGN STATUS  
ASBUILT

DESIGNED BY	
DATE	19/05/2017
SCALE	1:50 @A1
CAD BY	
SIGN OFF	Martin Roberts
DWG No:	P153 -02 -GA

02