


15 JOCKEY'S FIELDS, LONDON

This drawing is the property of Haywards LLP and must not be copied or reproduced without express written permission. Use figured dimensions only. All dimensions to be verified on site prior to commencing construction. Do not scale.

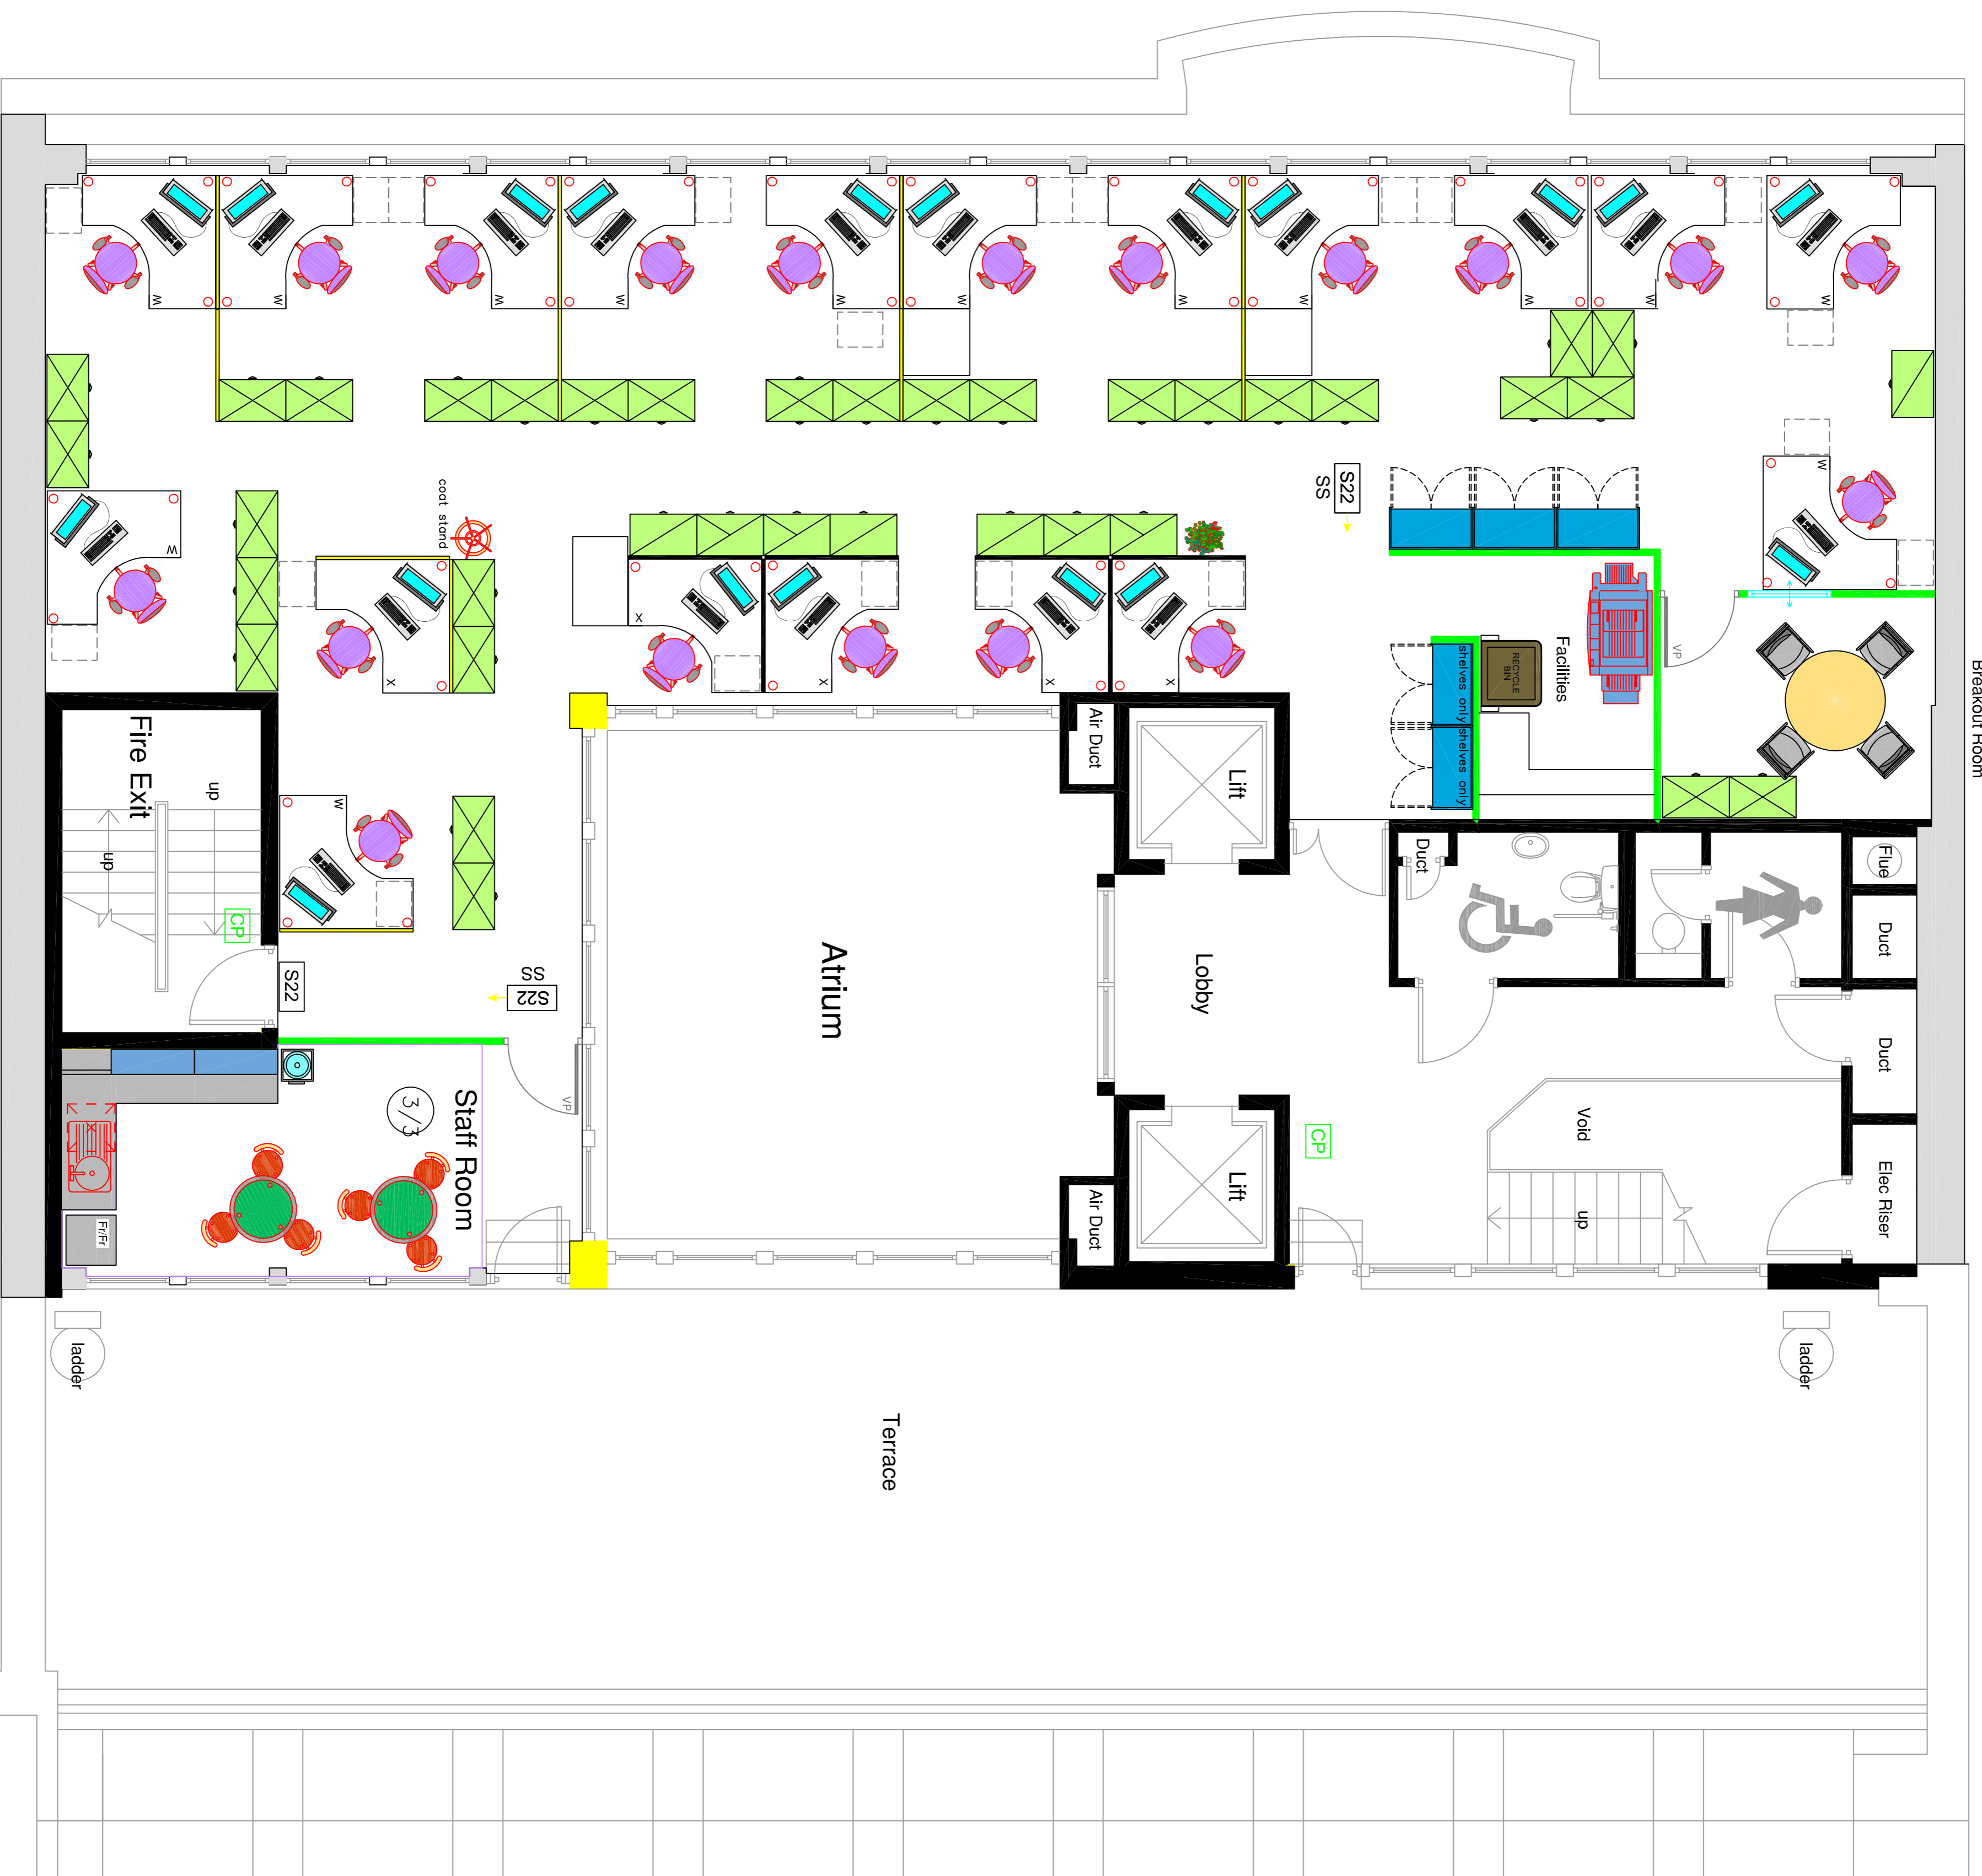

DESKCOUNT
TOTAL: 19 no

Furniture

- 1600 x 1600 desk, c/w pedestal
- Screen, 1800 high
- Screen 1200 high, to extend to floor.
- Full height built in storage wall cupboard
To have 4 levels lat roll out filing, shelves above, unless stated on plan
Final file size to be determined
All shelves to be adjustable
- 800 x 500 x 2000 high storage unit,
To have 4 levels lat roll out filing, shelves above
Final file size to be determined
All shelves to be adjustable
- 800 x 500 x 1200 high storage unit,
To have 2 shelves unless stated on plan
All shelves to be adjustable
- 800 x 500 x 750 high storage unit,
To have 1 shelf
All shelves to be adjustable

REV	DESCRIPTION	DATE
-	Record Drawing	19/04/10

Approval

HAYWARDS
PROPERTY | BUSINESS | PEOPLE

Approved subject to alterations outlined/indicated in red.
 Client:
 Clients Representatives:
 Haywards Ltd
 Date: Contact Ref:
 Approved subject to alterations outlined/indicated in red.

Hampden Chase, Little Hampton, Great Missenden, Bucks, HP16 9PT
 Tel: +44 (0)1494 488 493 - Fax: +44 (0)1494 488 793
 www.haywardsllp.co.uk

Client: CUMBERLAND ELLIS

Project Title: 15 JOCKEY'S FIELDS LONDON WC1R 4QR

Dwg Title: EXISTING LAYOUT PLAN THIRD FLOOR

Scale: 1:100@A1 Date: 19/04/10 Rev:

Dwg No: Drawn by: AR
 CUM1325/03/EX Checked by: SH

THIRD FLOOR: Existing Layout

© Haywards LLP 2010
 All rights reserved. No part of this document may be reproduced, stored in a retrieval system, or transmitted in any form, or by any means, electronic, mechanical, photocopying, recording, or otherwise, without prior permission, in writing from Haywards LLP.