


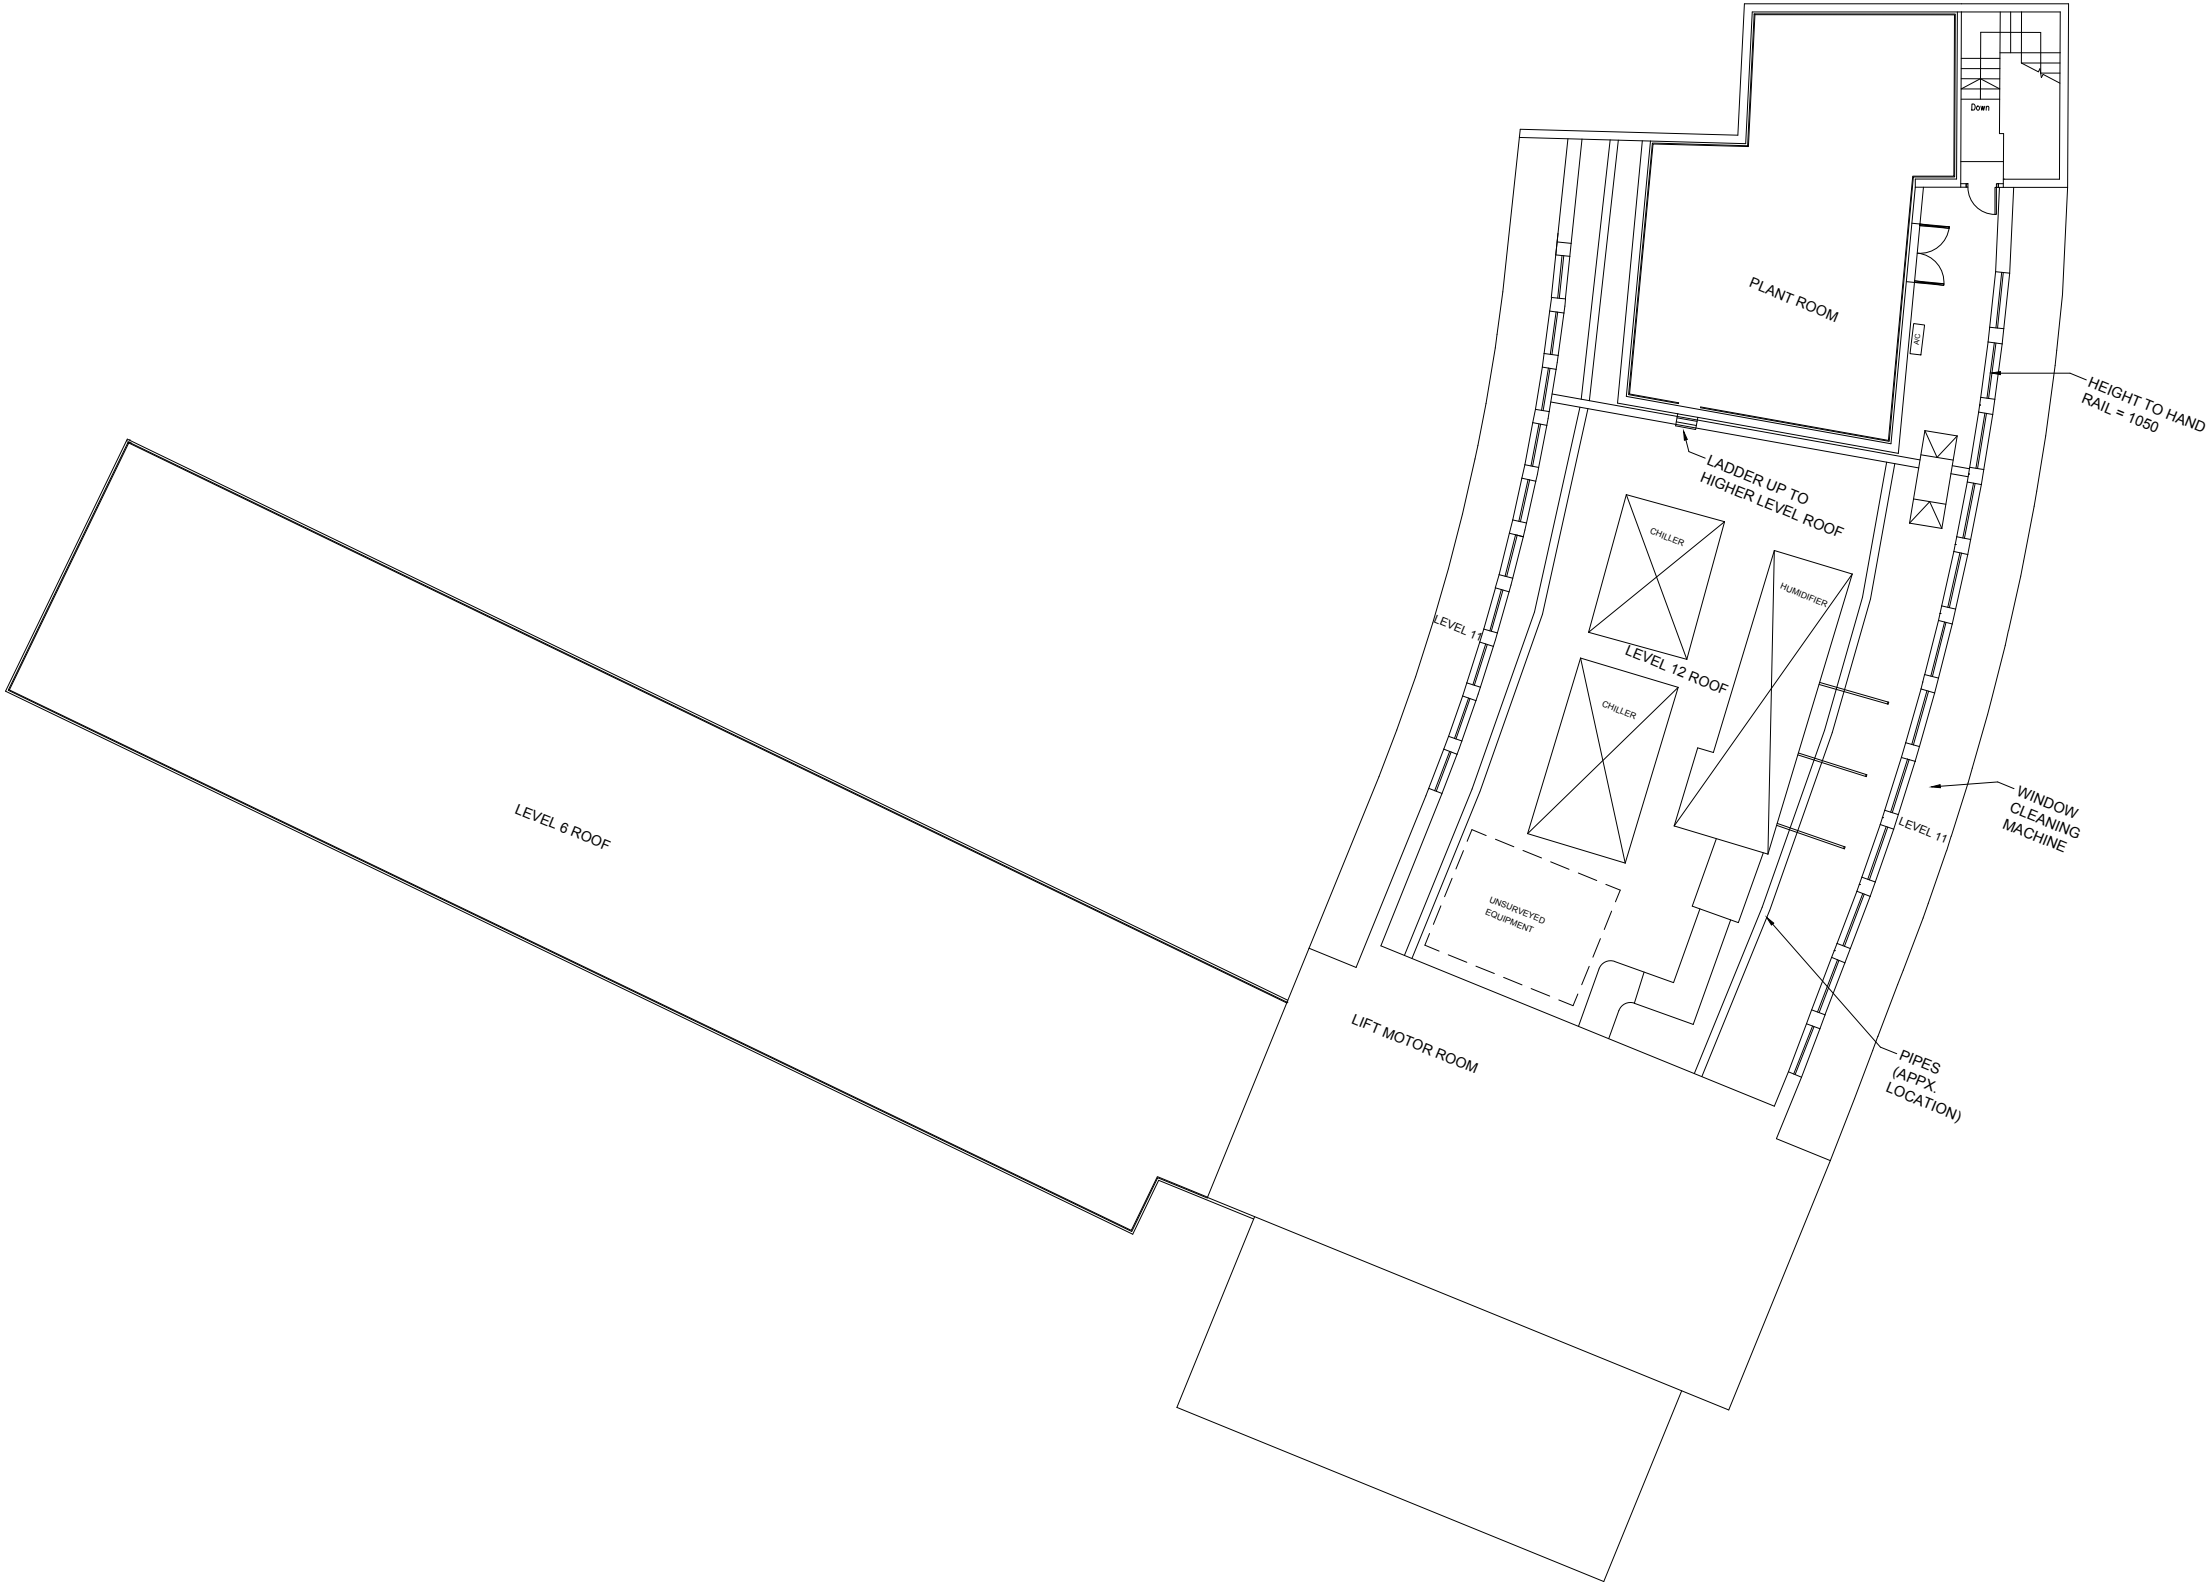

NOTE:
THIS LAYOUT IS PRODUCED ON THE BASIS OF
AN INTERNAL DIMENSION CHECK SURVEY.
ALL DIMENSIONS MUST BE CHECKED AND
VERIFIED ON SITE BY THE MAIN CONTRACTOR
PRIOR TO COMENCEMENT OF ANY WORK OR
SHOP DRAWINGS.

REVISIONS

Rev.	Details.	Date.
Rev	As Built layout	2018Aug12



Transport for London
COMMERCIAL DEVELOPMENT
PROJECTS & ACCOMMODATION
PALESTRA
197 BLACKFRIARS ROAD LONDON SE1 8NJ

Drawing Title:
ALBANY HOUSE

Layout:
**ROOF
AS BUILT LAYOUT**

Survey Date:	Surveyed By:	Date of Occu Survey:
Drawn By: --	Date: --	Scale: NTS
Checked By:		Date:
Approved By:		Date:

Drg. No. AB_0R TRIRIGA	Rev. 0
----------------------------------	------------------