




D				
C				
B	04/11/21	WORKSHOP FEEDBACK		EN
A		INITIAL CONCEPT		EN
REV	DATE	ISSUE	BY	CH

AS BUILT	
STATUS	DESCRIPTION

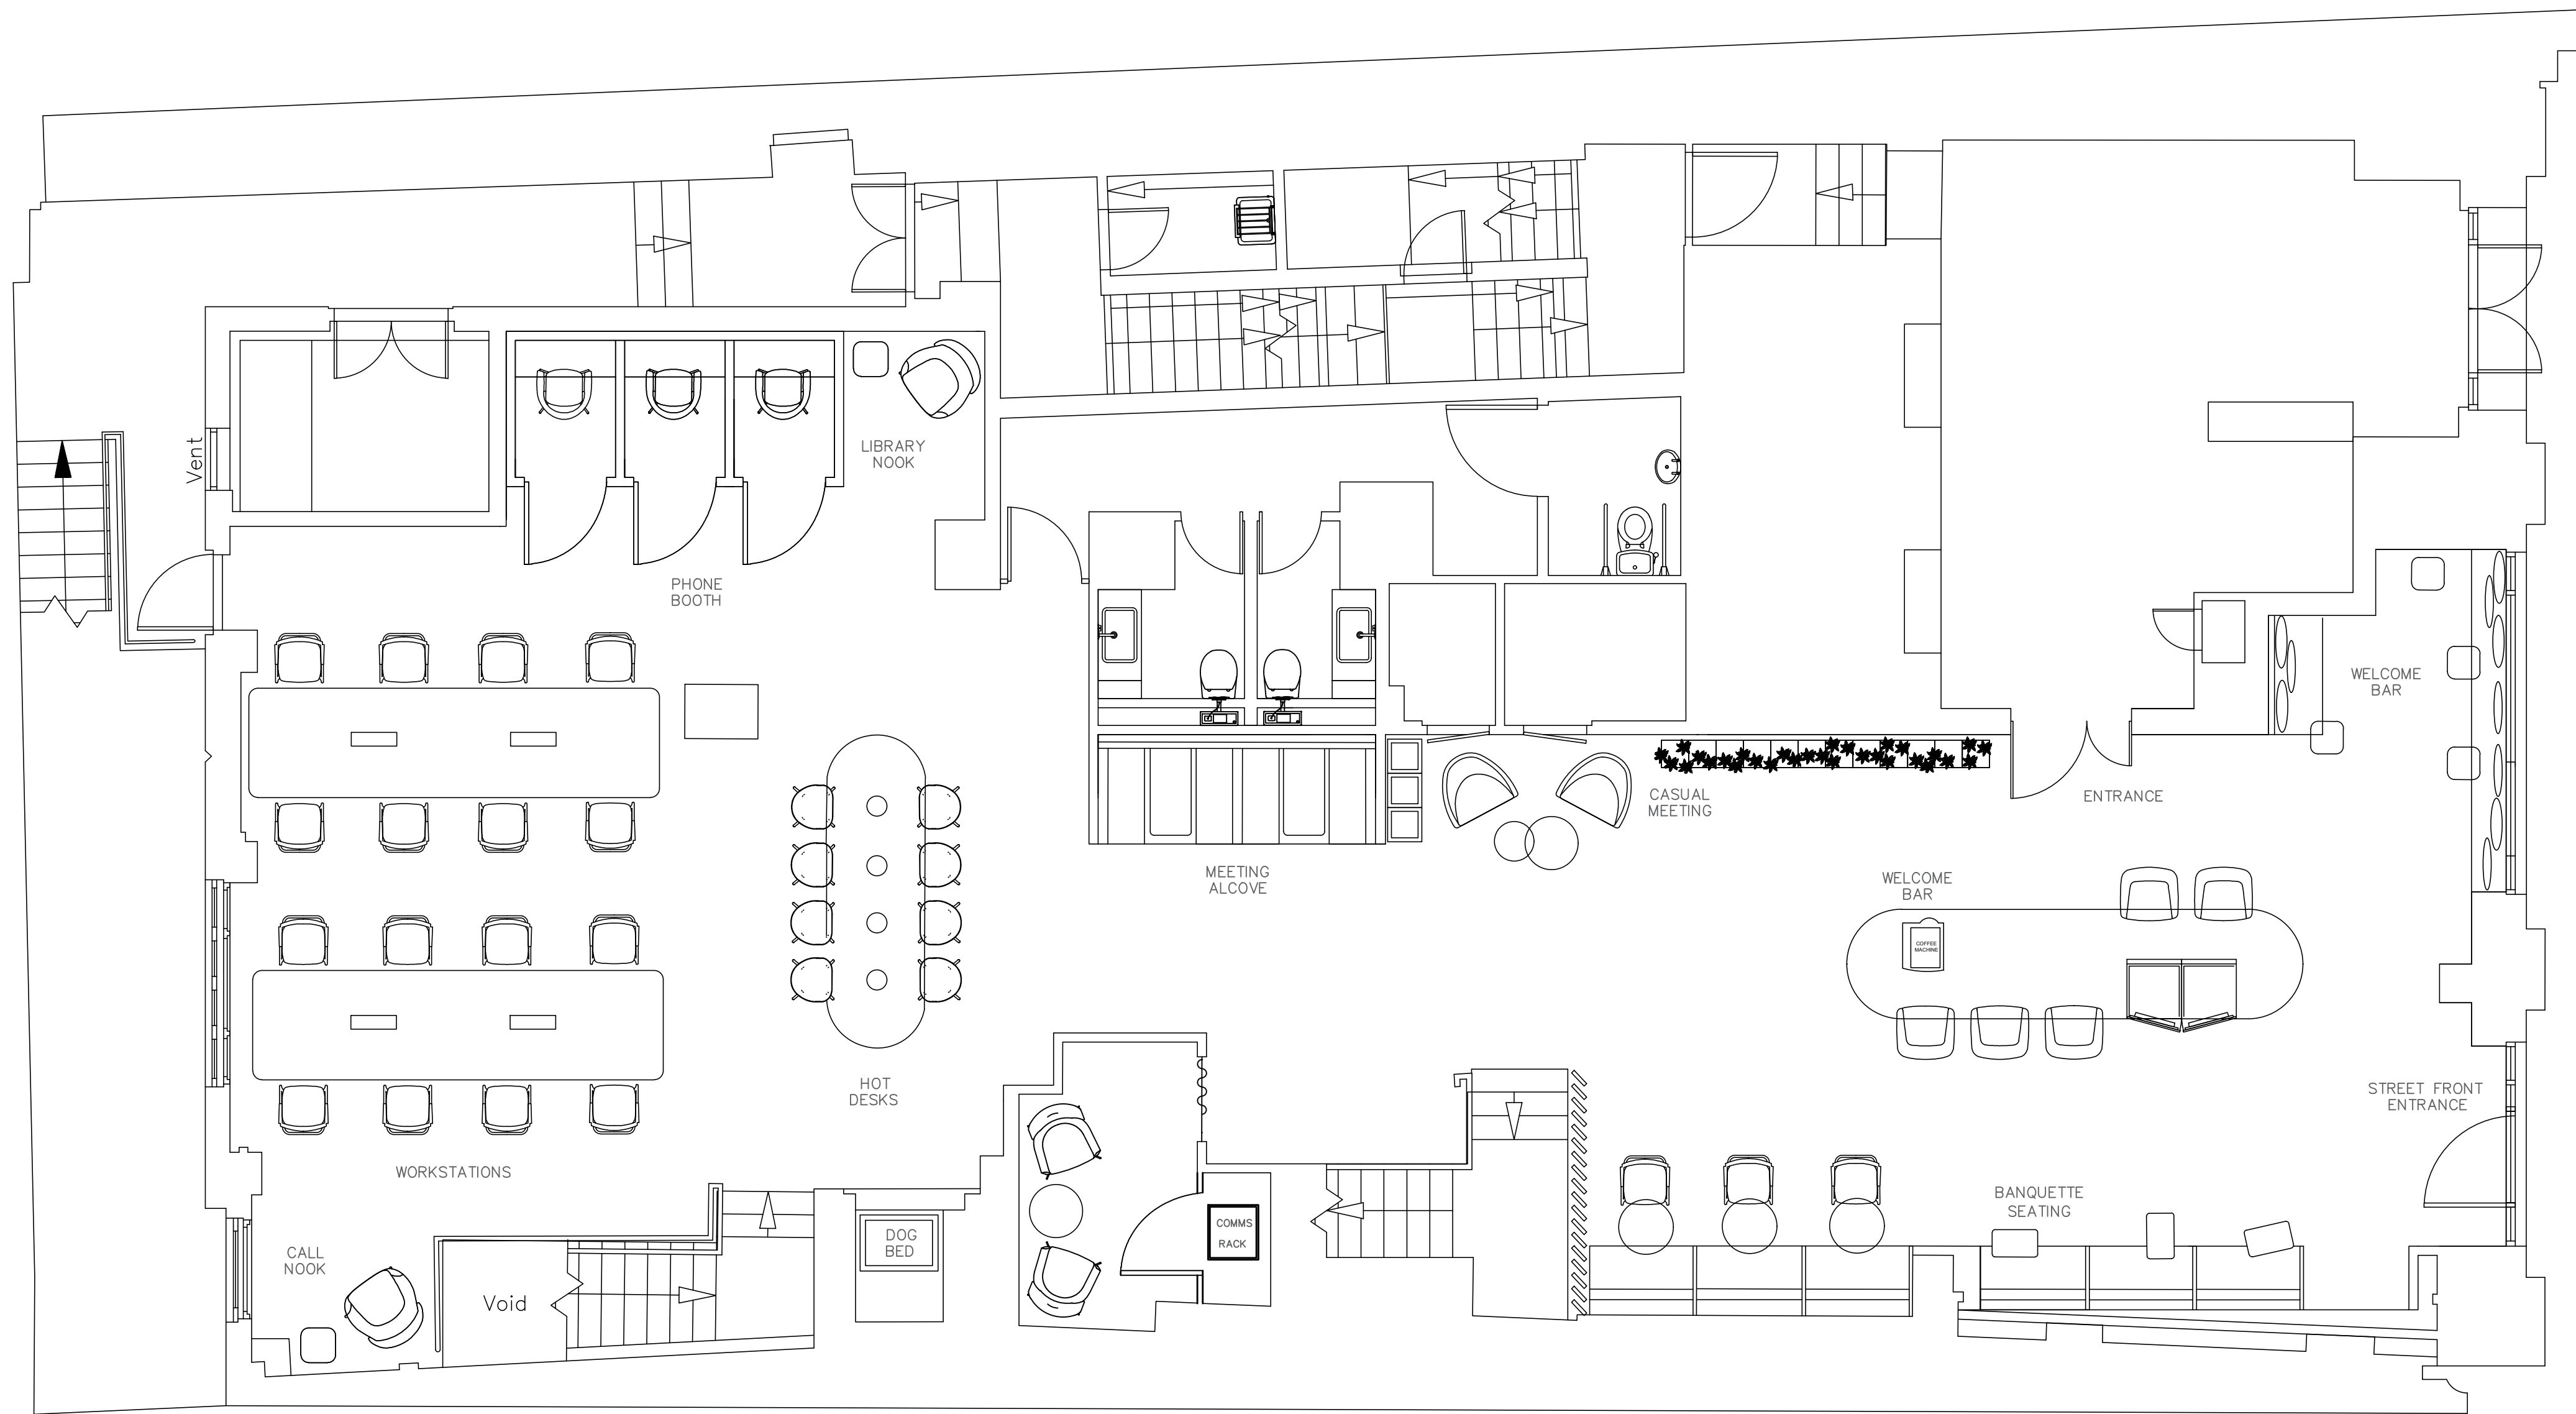

PROJECT :210 High Holborn Basement, Ground, 1st	
CLIENT :	L&G
PROJECT NO :	T196
DESCRIPTION :	GROUND FLOOR GENERAL ARRANGEMENT
SCALE :	1:75 @ A1
DRAWING No :	T196_GA_GF
REVISION	B