


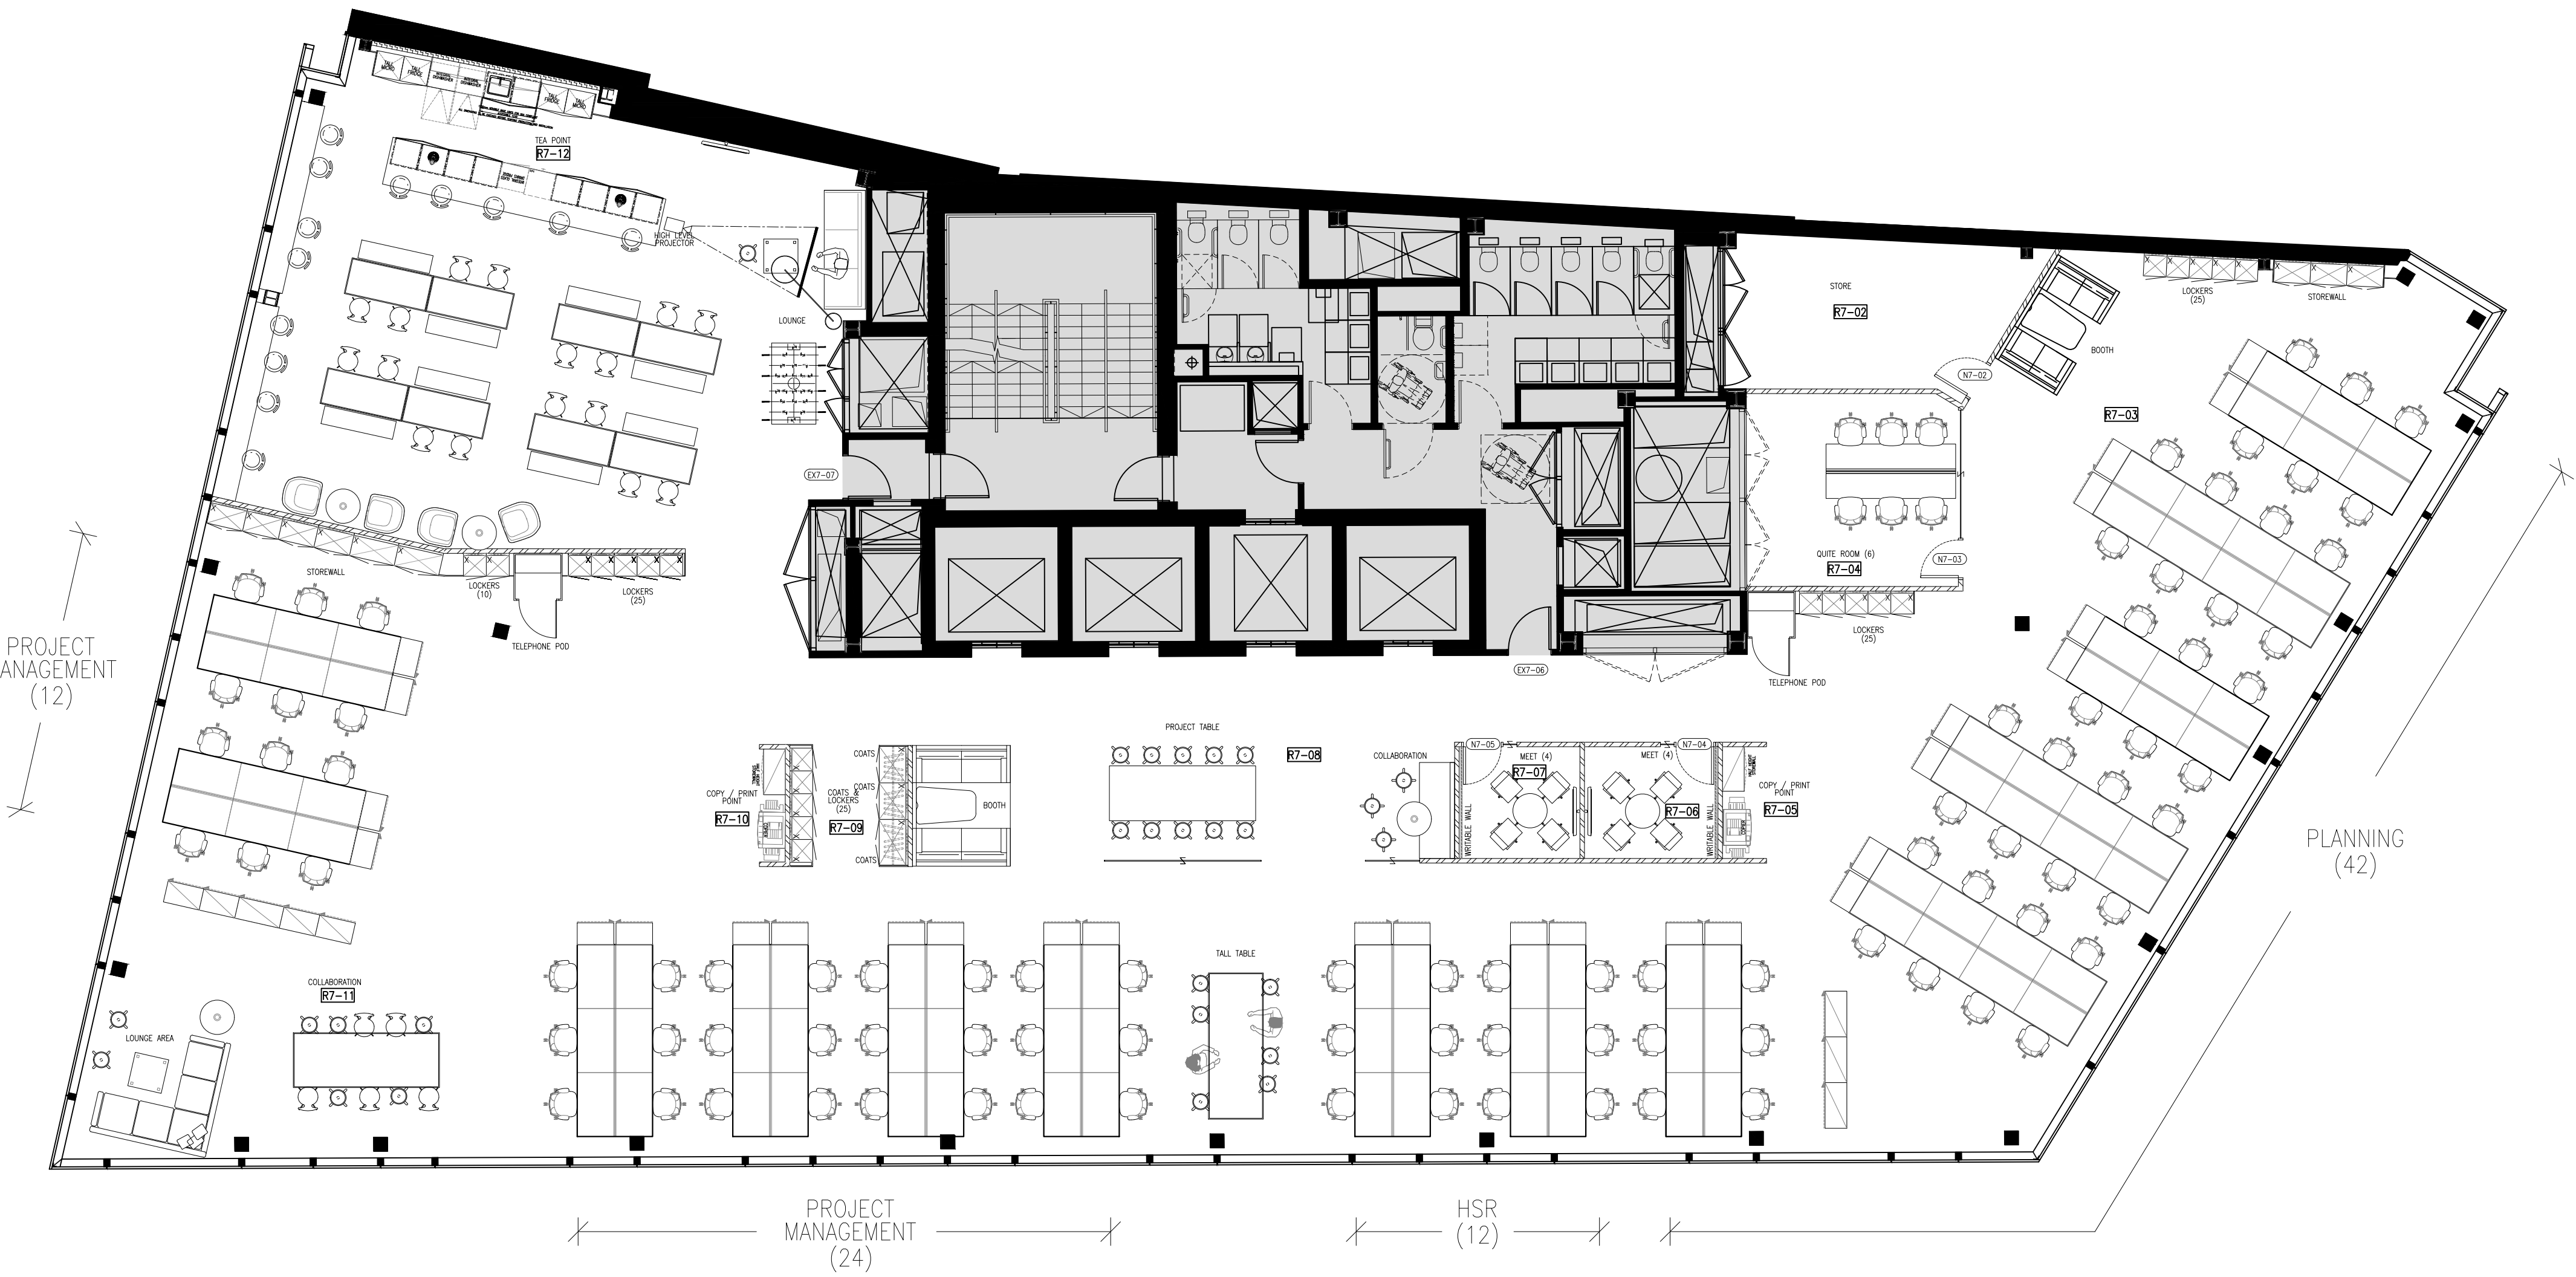

Floor

07

KEY TO GENERAL ARRANGEMENT DETAILS

Keys not to scale - Some symbols shown might not appear on the drawing

Existing structural basebuild wall

Existing partition

New 75mm solid stud partition (Single skin)

New 100mm solid stud partition (Single skin)

New 100mm solid stud partition (Double skin)

New half height partition

New partition(Detail t.b.c.)

Notes:- All partitions to be 'raised floor to underside of suspended ceiling' - Unless otherwise noted (See below)

GLAZING DETAILS

Existing silicon glass

Existing glazed module

New single glazed silicon glass

New double glazed silicon glass

New single glazed module

New double glazed module

DOOR DETAILS

Existing door

New solid framed door

New glass door

EX1=Existing 1st floor

EX1=Relocated 1st floor

N1 = New 1st floor

VP= Vision Panel

SEC= Security door

F120S= Fire door rated with smoke seal 20min

F130S= 30min

F160S= 60min

All doors to be full height unless otherwise stated

R1=01 R1 = 1st floor room 01 = Room no.

W1 = 1st floor window 01 = Window no.

Ex

Existing furniture

Low height (Tambour unit)

General Storage wall

New furniture

Medium height (Drawer unit)

Cloaks Storage wall

Expansion furniture

High height (Door unit)

Hiring Cabinet

Landlord Area - No works