

Disclaimer

This drawing should not be scaled.

The contractor is to check all dimensions on site and inform the contract administrator/project manager of any discrepancies.


All work is to comply in every aspect with the Building Regulations, Codes of Practice and British Standards.

This drawing is to be read in conjunction with all other contract drawings and specifications.


This drawing is copyrighted and must not be reproduced in any format or disclosed to any third party without the written consent of Tuffin Ferraby Taylor LLP.

rev date details
A 06.11.2020 DRAWING ISSUED 'AS BUILT'


by
RD

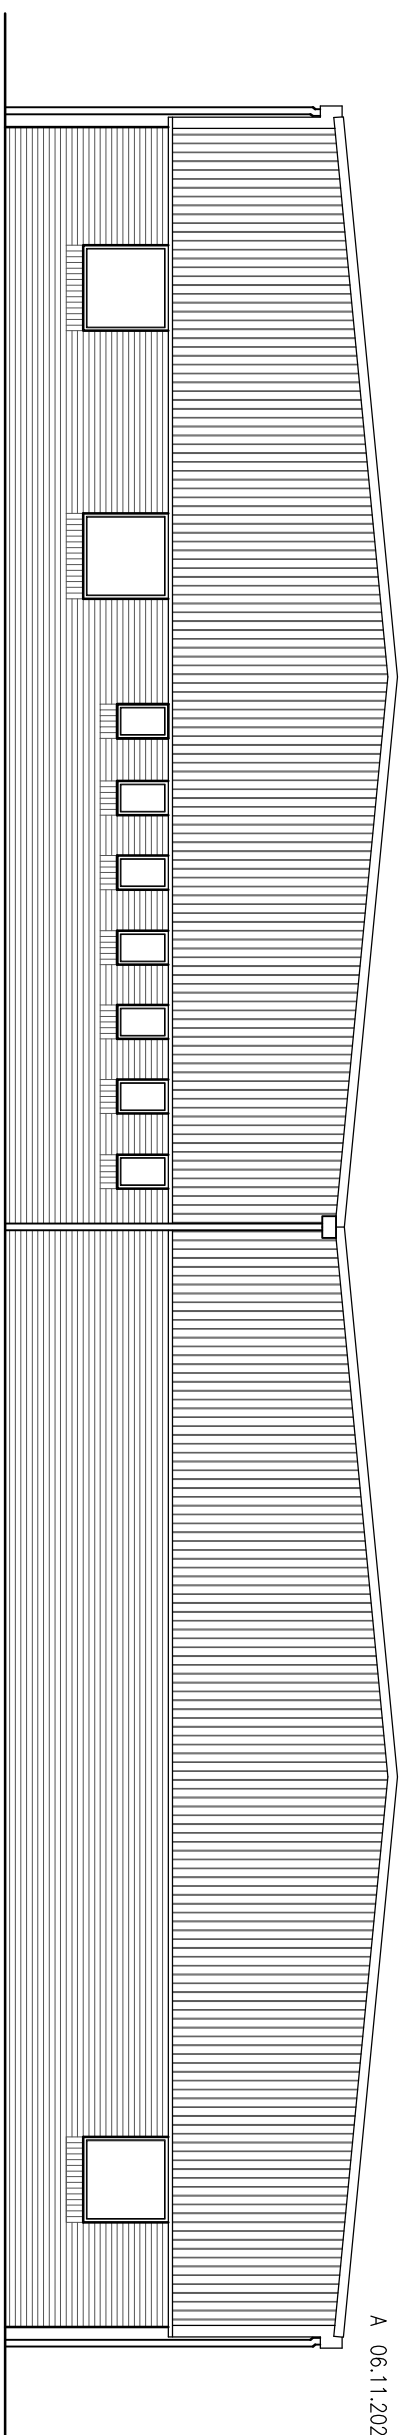


SIDE ELEVATION

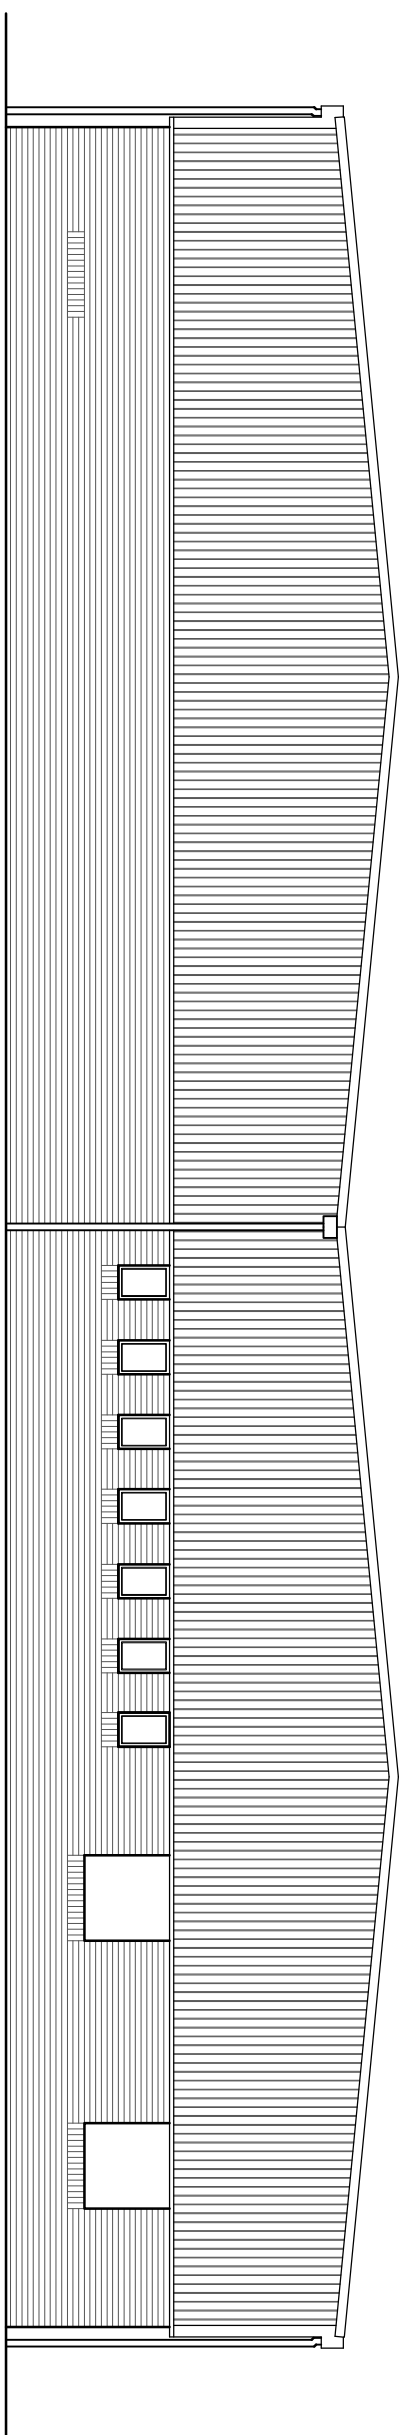

SIDE ELEVATION

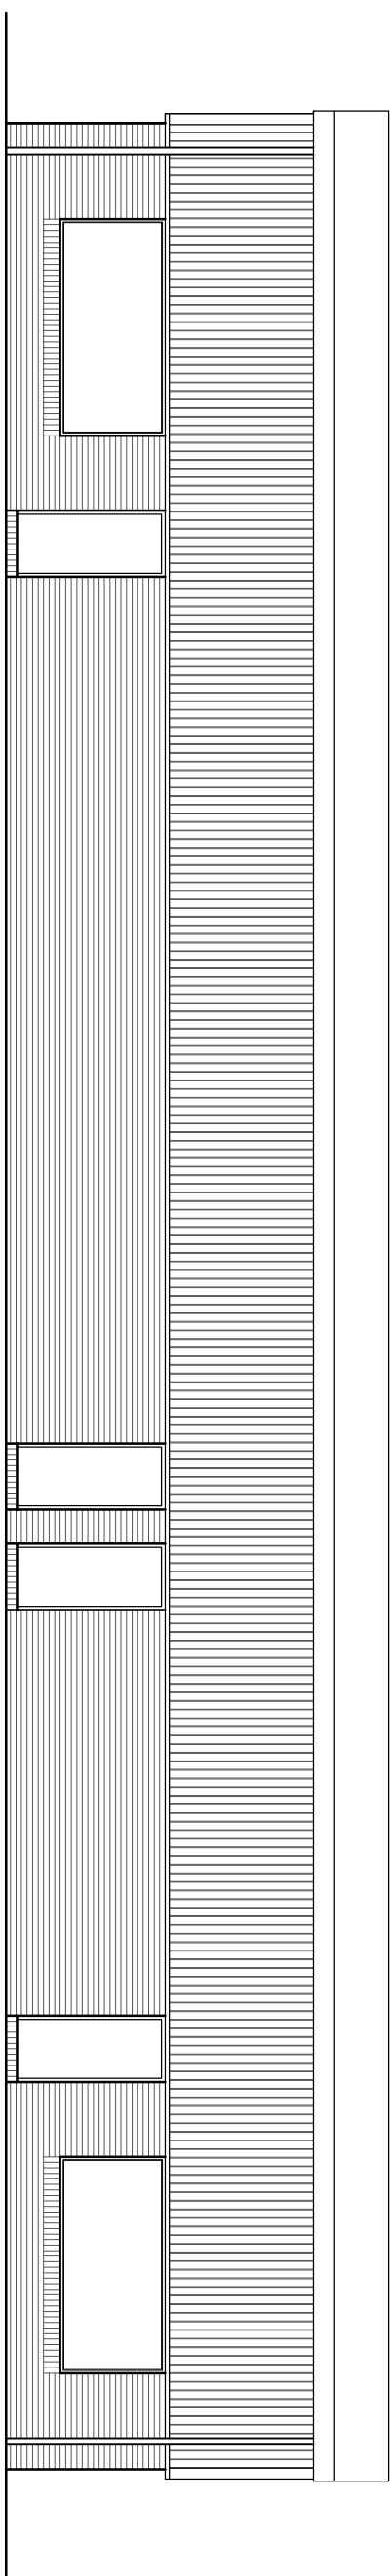


FRONT ELEVATION

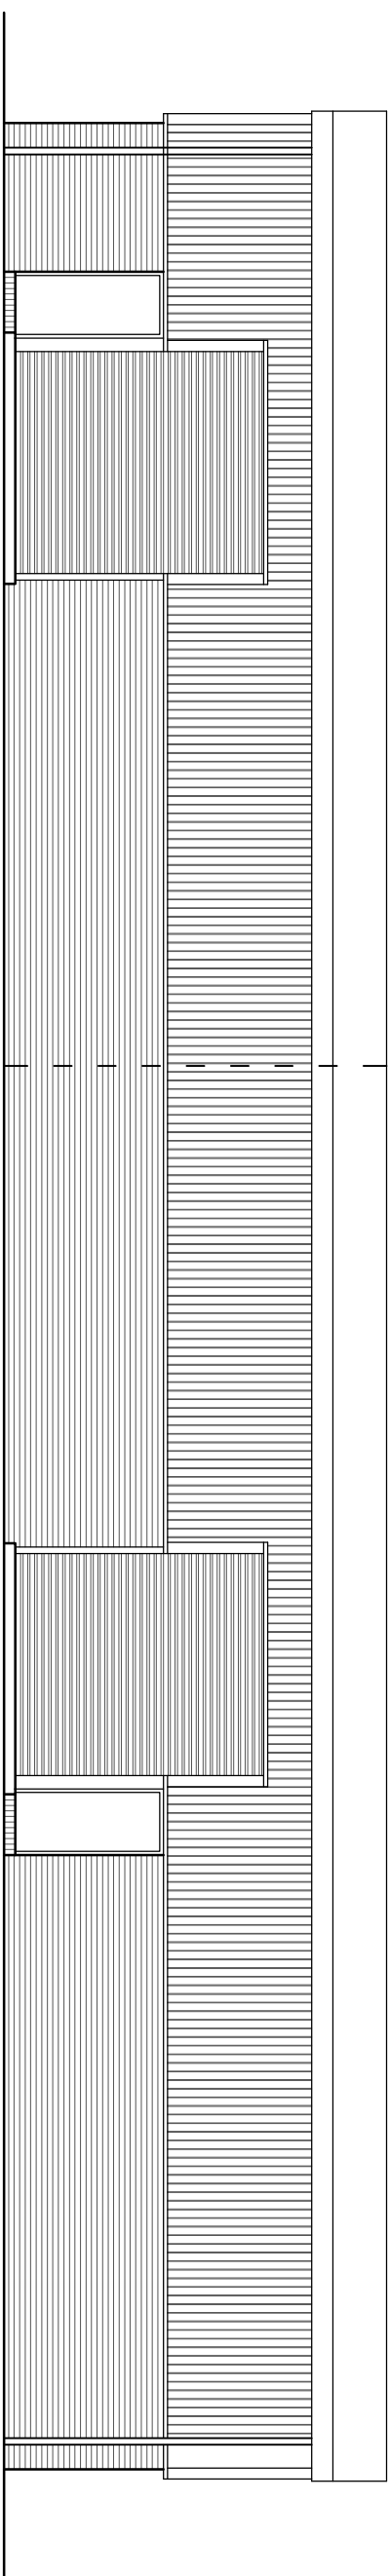


REAR ELEVATION

PROPOSED ELEVATIONS
UNIT 38 & 39, ALBION INDUSTRIAL ESTATE, PONTYPRIDD, CF37 4NX

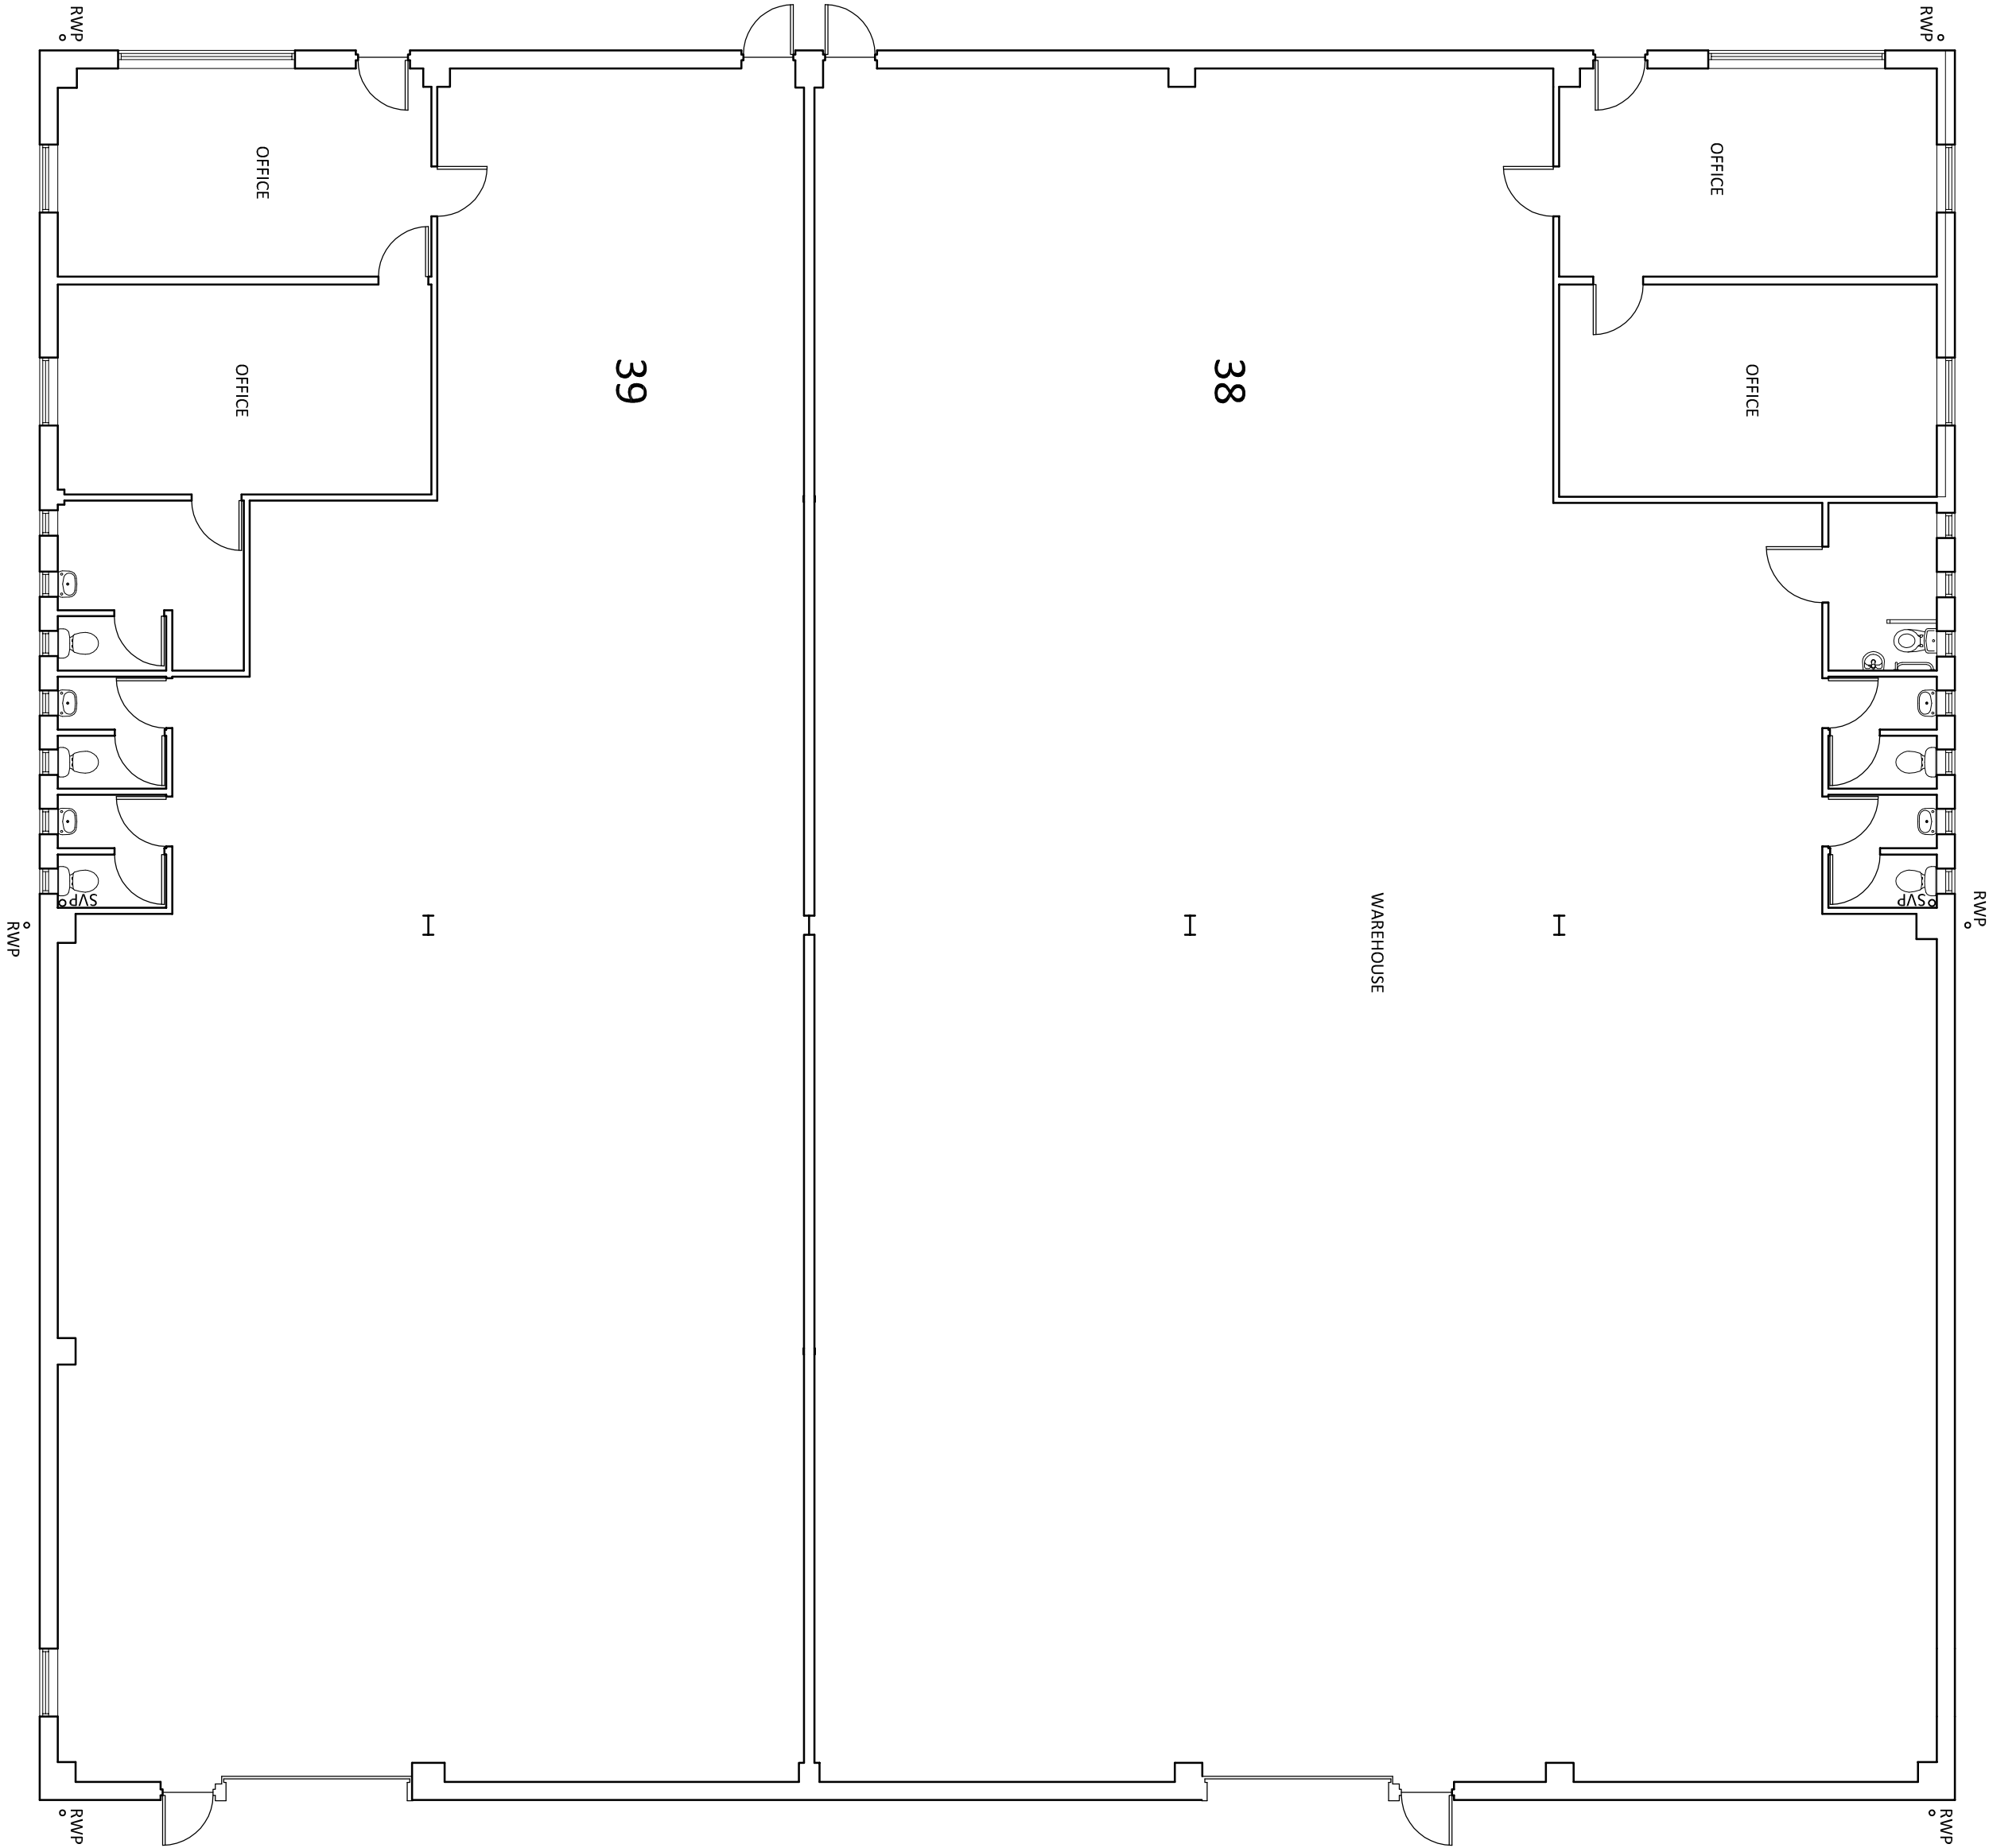

PROPOSED GROUND FLOOR PLAN
UNIT 38 & 39, ALBION INDUSTRIAL ESTATE, PONTYPRIDD, CF37 4NX

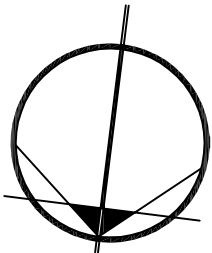

0 5M 10M
SCALE BAR
1:100 @ A1

AS BUILT

CLIENT MILEWAY REAL ESTATE UL LTD
PROJECT 38 & 39 ALBION IND. EST. PONTYPRIDD
DRAWING PROPOSED FLOOR PLANS & ELEVATIONS

DRAWN RD
SCALE @ A1 1:100
DATE JAN 20

PROJECT No. DRAWING No. REV
190274 P01(1) A

