


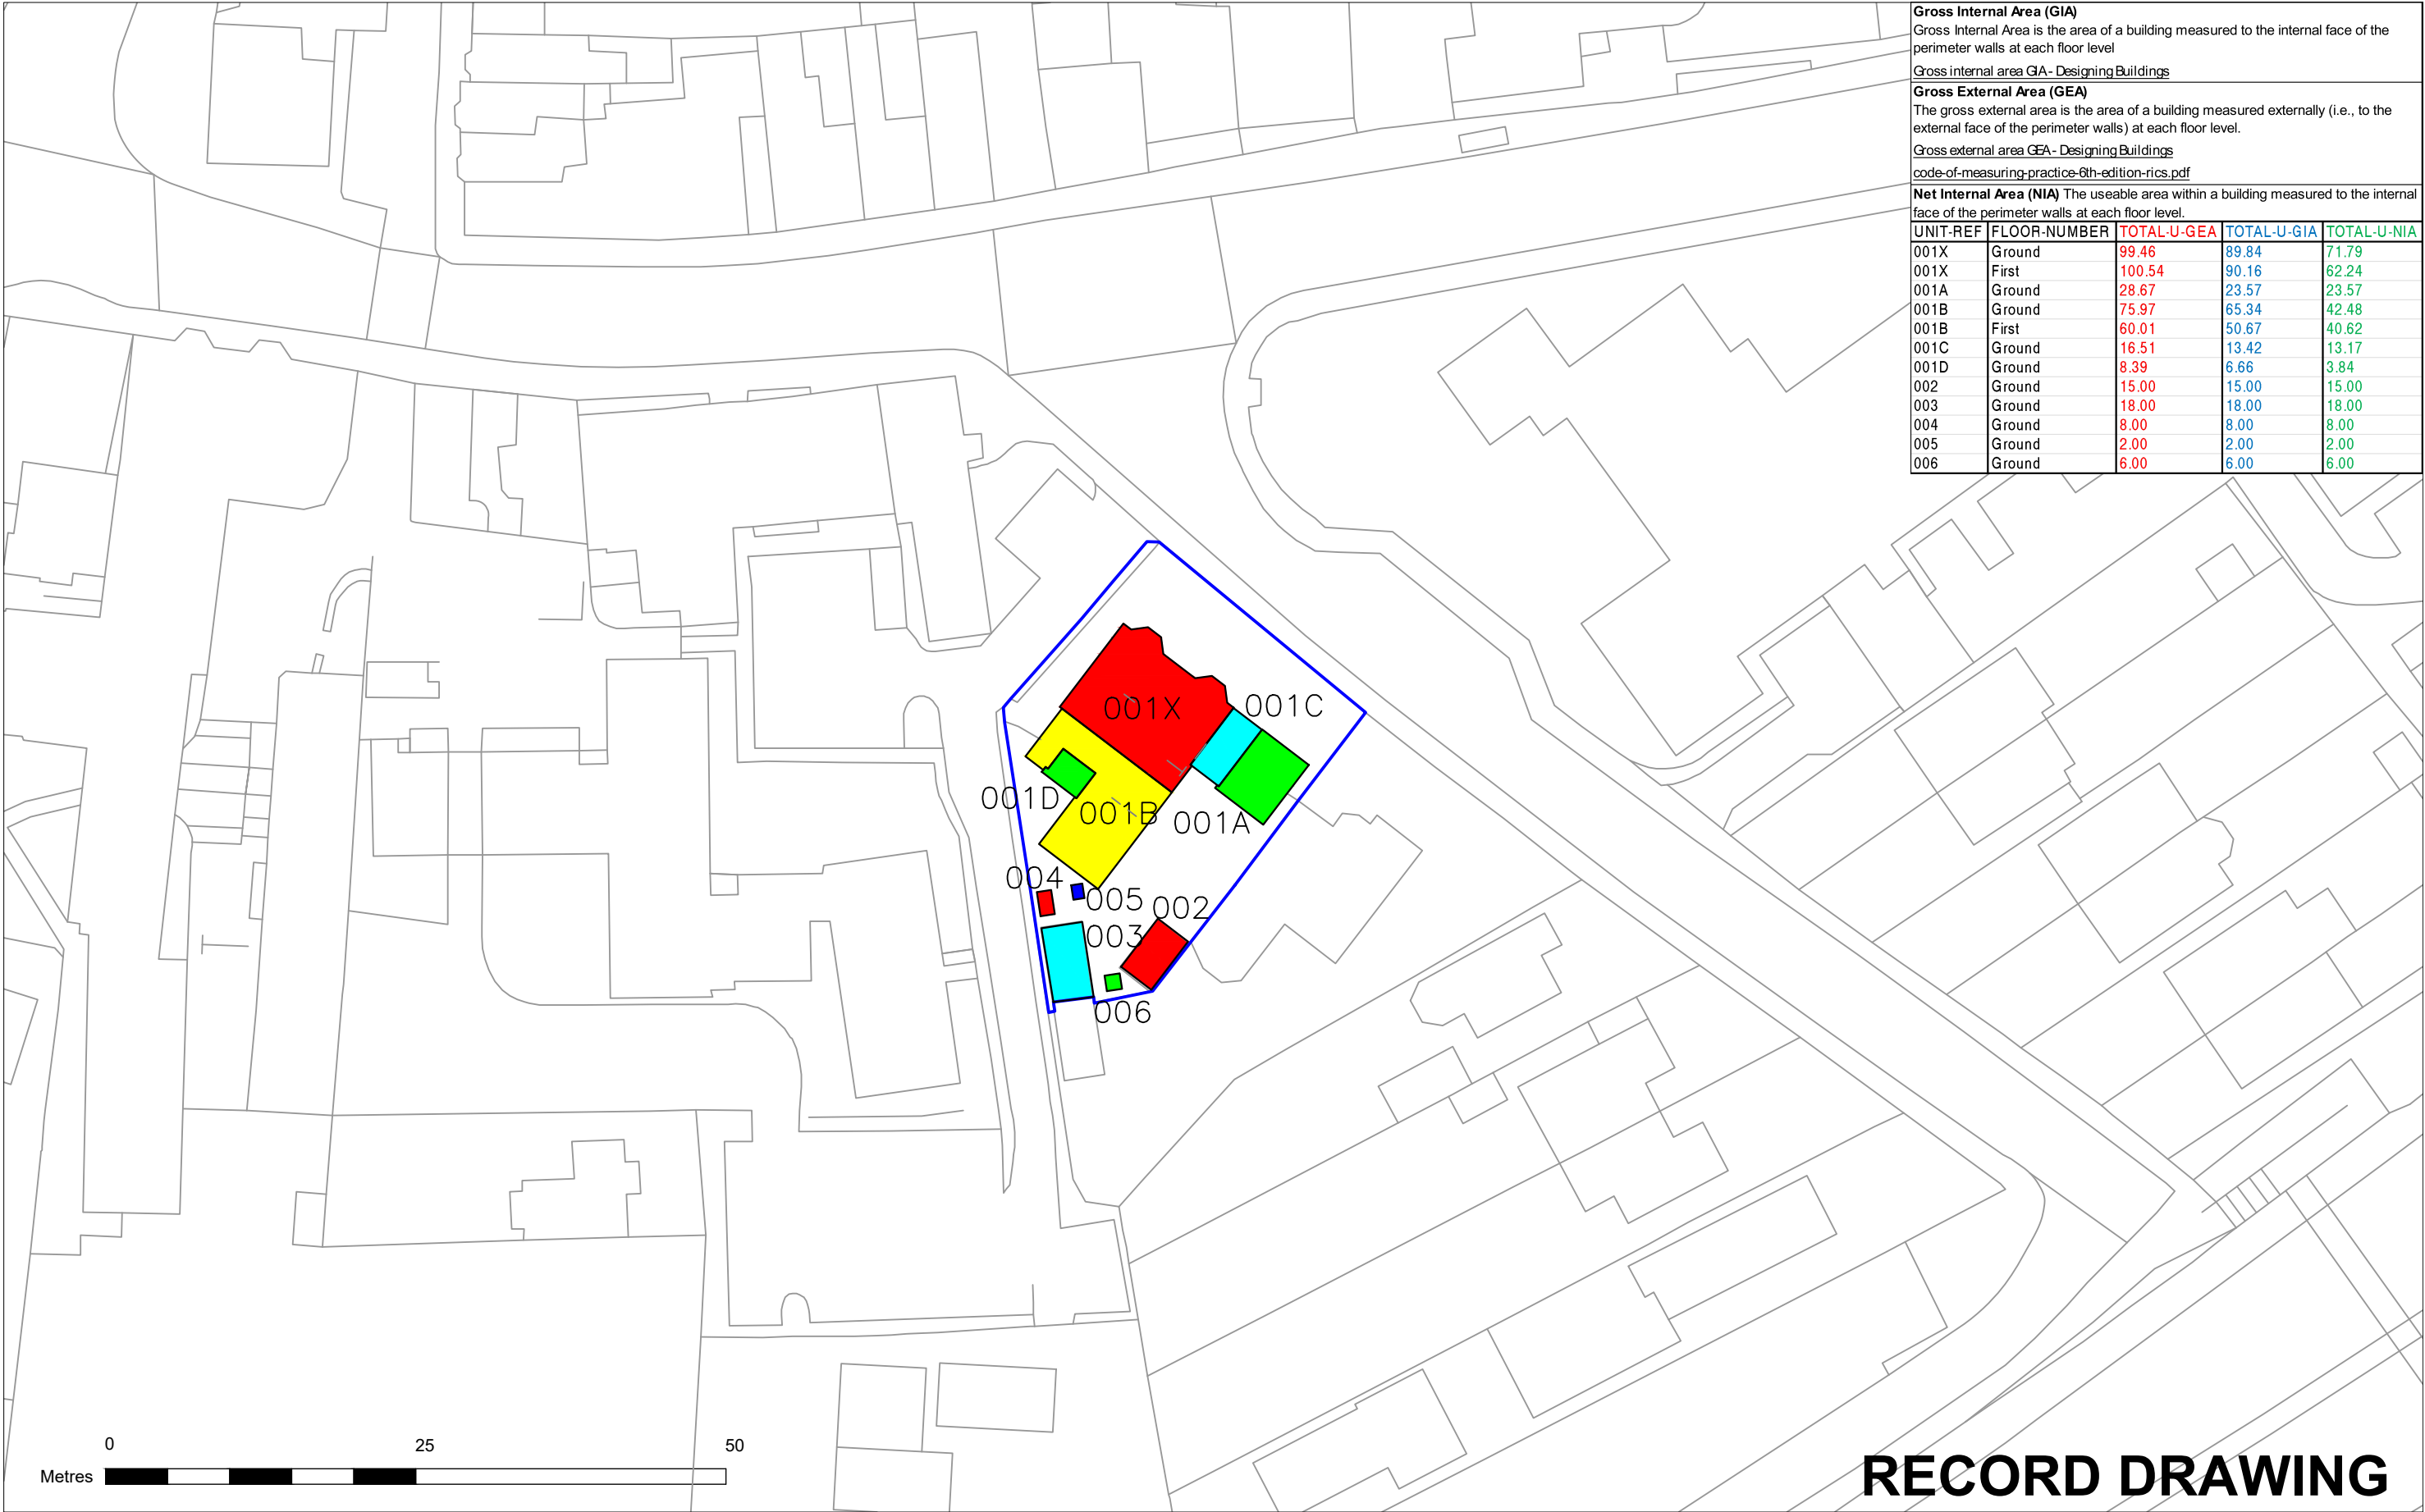

Gross Internal Area (GIA) Gross Internal Area is the area of a building measured to the internal face of the perimeter walls at each floor level. Gross internal area GIA- Designing Buildings				
Gross External Area (GEA) The gross external area is the area of a building measured externally (i.e., to the external face of the perimeter walls) at each floor level. Gross external area GEA- Designing Buildings code-of-measuring-practice-6th-edition-rics.pdf				
Net Internal Area (NIA) The useable area within a building measured to the internal face of the perimeter walls at each floor level.				
UNIT-REF	FLOOR-NUMBER	TOTAL-U-GEA	TOTAL-U-GIA	TOTAL-U-NIA
001X	Ground	99.46	89.84	71.79
001X	First	100.54	90.16	62.24
001A	Ground	28.67	23.57	23.57
001B	Ground	75.97	65.34	42.48
001B	First	60.01	50.67	40.62
001C	Ground	16.51	13.42	13.17
001D	Ground	8.39	6.66	3.84
002	Ground	15.00	15.00	15.00
003	Ground	18.00	18.00	18.00
004	Ground	8.00	8.00	8.00
005	Ground	2.00	2.00	2.00
006	Ground	6.00	6.00	6.00


 Hampshire
County Council

HCC Property Services,
Three Minsters House,
76 High Street, Winchester SO23 8UL.
tel: 03707 790555

Notes	
1 This drawing is © copyright Hampshire County Council 2025. No unauthorised reproduction permitted. All rights reserved.	3 © Crown copyright and database rights 2025 Ordnance Survey 100019180. Use of this data is subject to terms and conditions. You are granted a non-exclusive, royalty free, revocable licence solely to view the Licensed Data for non-commercial purposes for the period during which HCC makes it available. You are not permitted to copy, sub-license, distribute, sell or otherwise make available the Licensed Data to third parties in any form. Third party rights to enforce the terms of this licence shall be reserved to Ordnance Survey.
2 No dimensions are to be scaled from this drawing	

rev	description	date	by
A	Amended to show both sites	16/08/12	HJP
B	1st floor added to Bath Lane	21/08/12	HJP
C	Properties split	02/04/13	HJP
D	HSS amendments added.	04/09/19	HJP
E	Floor plan updated following two refurbishment projects.	03/03/20	clw
F	Floor plan updated to latest format.	20/03/25	HJP

PROJECT Fareham Day Services - Bath Lane Annex. Fareham, PO16 0DJ 10008001873				SHEET CONTENTS Property Records Site Plan Sheet 1 of 4 Property Services	
SCALE 1:250 @ A1 1:500 @ A3	DATE Unknown	DRAWN. Internal	CHKD. ---	DRAWING No. 01_Rec/001	REVISION F
FILE REF. 10008001873-FarehamDayServicesBathLaneAnnexe.dwg					

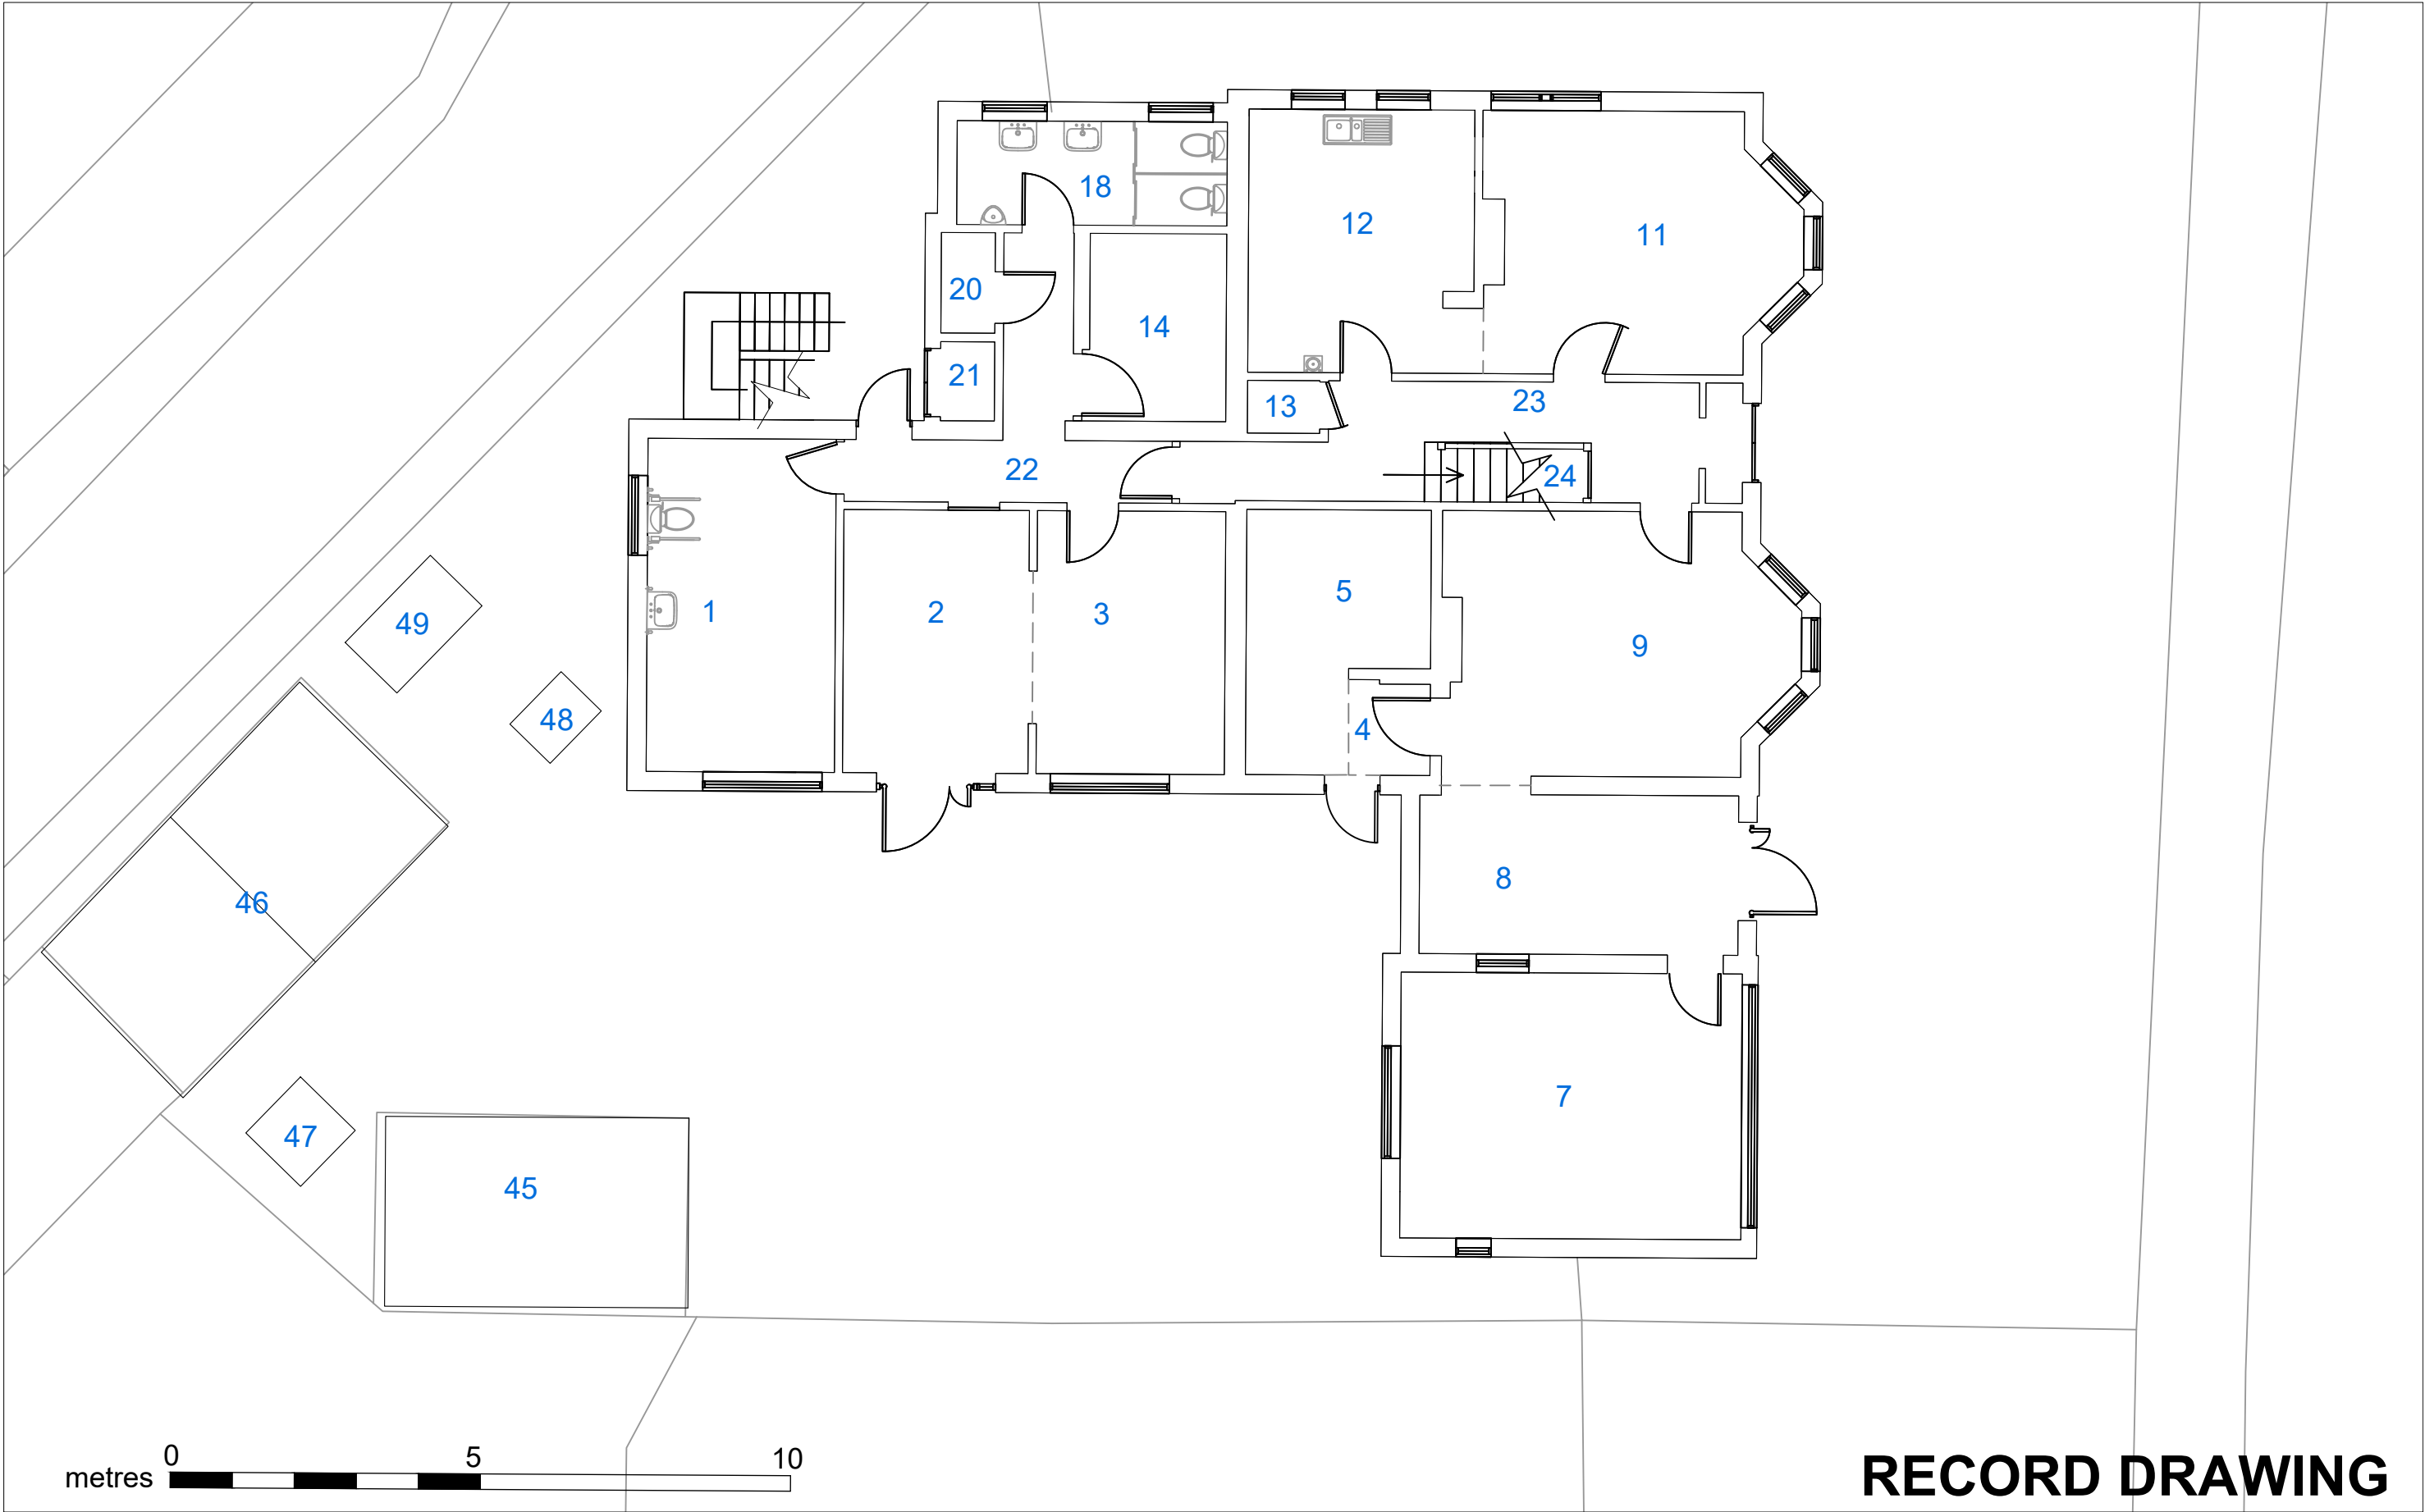


HCC Property Services,
Three Minsters House,
76 High Street, Winchester SO23 8UL.
tel: 03707 790555

Notes	
1 This drawing is © copyright Hampshire County Council 2025. No unauthorised reproduction permitted. All rights reserved.	3 © Crown copyright and database rights 2025 Ordnance Survey 100019180. Use of this data is subject to terms and conditions. You are granted a non-exclusive, royalty free, revocable licence solely to view the Licensed Data for non-commercial purposes for the period during which HCC makes it available. You are not permitted to copy, sub-license, distribute, sell or otherwise make available the Licensed Data to third parties in any form. Third party rights to enforce the terms of this licence shall be reserved to Ordnance Survey.
2 No dimensions are to be scaled from this drawing	

rev	description	date	by
A	Amended to show both sites	16/08/12	HJP
B	1st floor added to Bath Lane	21/08/12	HJP
C	Properties split	02/04/13	HJP
D	HSS amendments added.	04/09/19	HJP
E	Floor plan updated following two refurbishment projects.	03/03/20	clw
F	Floor plan updated to latest format.	20/03/25	HJP

PROJECT Fareham Day Services- Bath Lane Annexe, Fareham, PO16 0DJ 10008001873				SHEET CONTENTS Property Records Ground Floor Plan Sheet 2 of 4		 Property Services
SCALE 1:50 @ A1 1:100 @ A3	DATE Unknown	DRAWN. Internal	CHKD. ---	DRAWING No. 01_Rec/002 FILE REF.:10008001873-FarehamDayServicesBathLaneAnnexe.dwg	REVISION F	

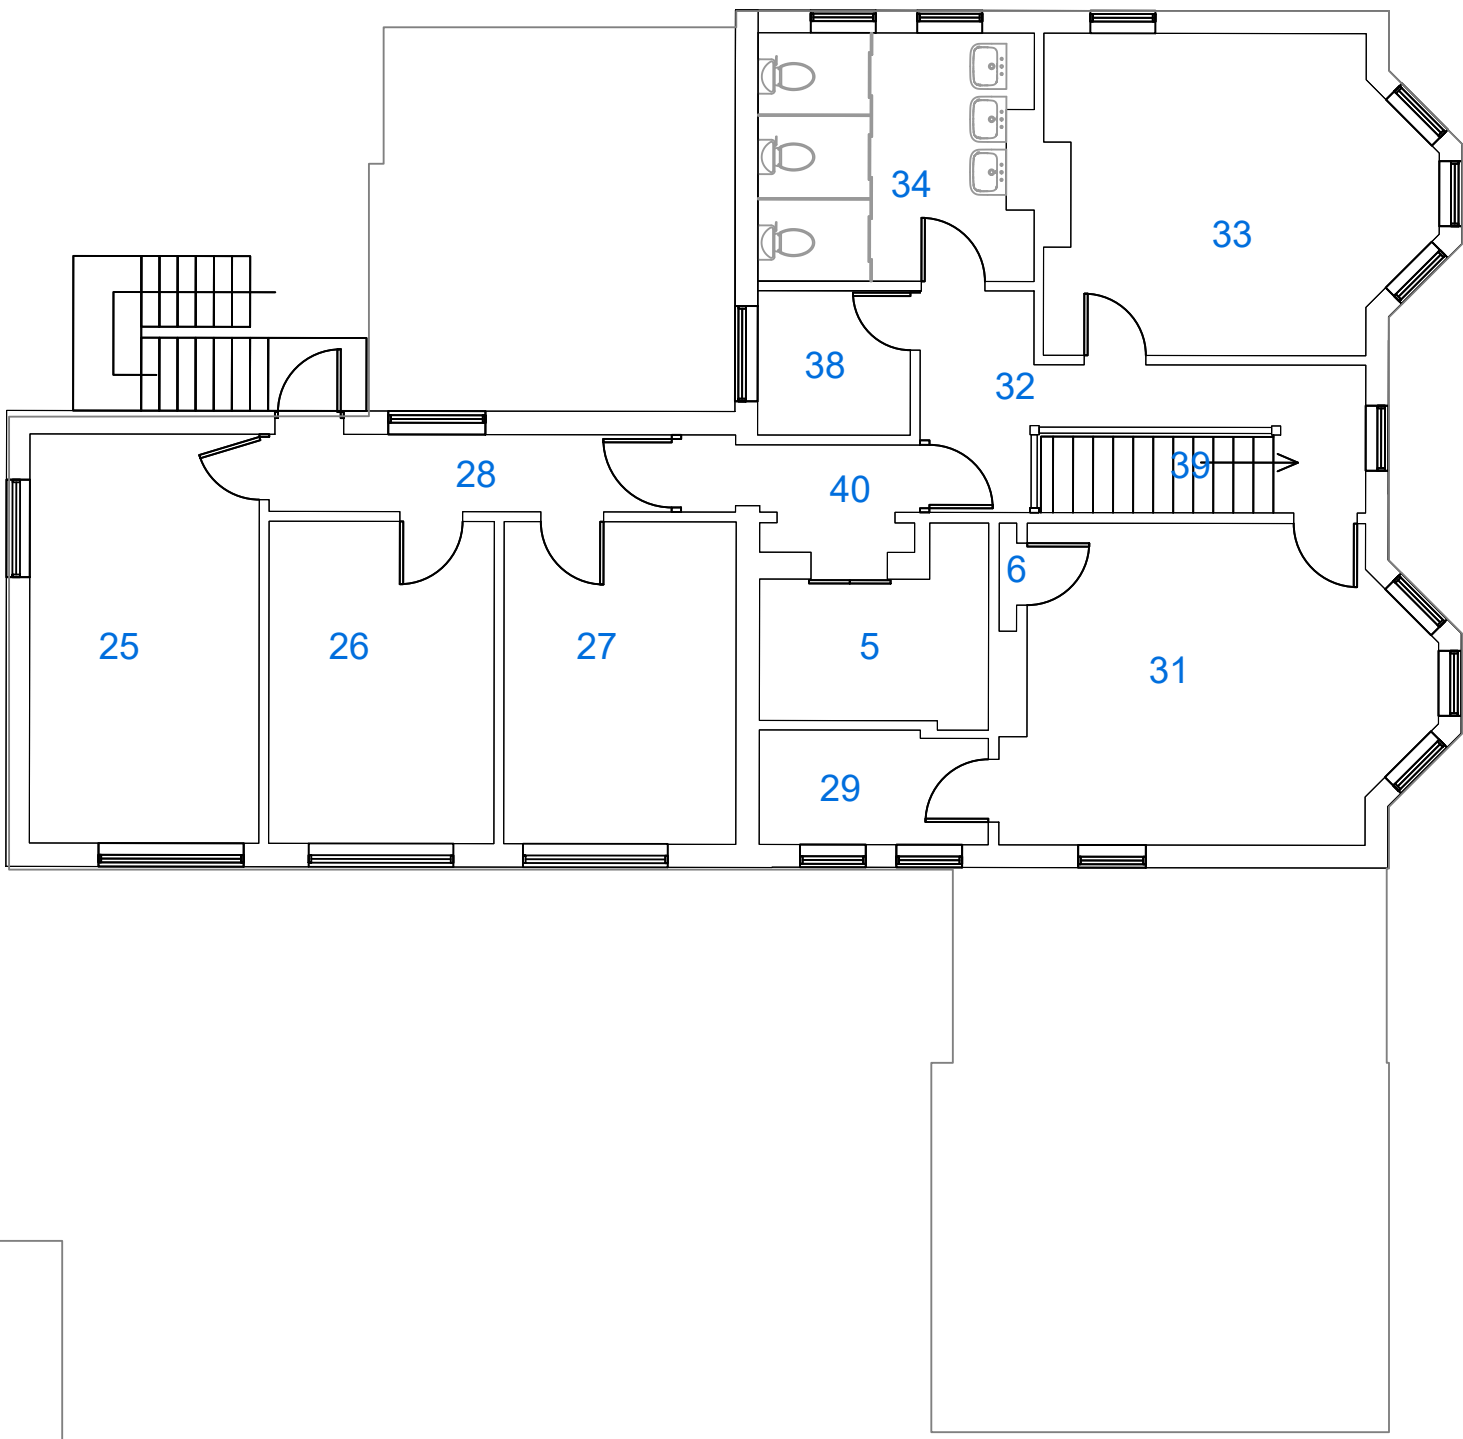

RECORD DRAWING




HCC Property Services,
Three Minsters House,
76 High Street, Winchester SO23 8UL.
tel: 03707 790555

Notes	
1 This drawing is © copyright Hampshire County Council 2025. No unauthorised reproduction permitted. All rights reserved.	3 © Crown copyright and database rights 2025 Ordnance Survey 100019180. Use of this data is subject to terms and conditions. You are granted a non-exclusive, royalty free, revocable licence solely to view the Licensed Data for non-commercial purposes for the period during which HCC makes it available. You are not permitted to copy, sub-license, distribute, sell or otherwise make available the Licensed Data to third parties in any form. Third party rights to enforce the terms of this licence shall be reserved to Ordnance Survey.
2 No dimensions are to be scaled from this drawing	

rev	description	date	by
A	Amended to show both sites	16/08/12	HJP
B	1st floor added to Bath Lane	21/08/12	HJP
C	Properties split	02/04/13	HJP
D	HSS amendments added.	04/09/19	HJP
E	Floor plan updated following two refurbishment projects.	03/03/20	clw
F	Floor plan updated to latest format.	20/03/25	HJP

PROJECT				SHEET CONTENTS		
Fareham Day Services- Bath Lane Annex, Fareham, PO16 0DJ 10008001873				Property Records First Floor Plan Sheet 3 of 4		
SCALE		DATE	DRAWN.	CHKD.	DRAWING No.	REVISION
1:50 @ A1 1:100 @ A3		Unknown	Internal	---	01_Rec/003	F
FILE REF.10008001873-FarehamDayServicesBathLaneAnnexe.dwg						



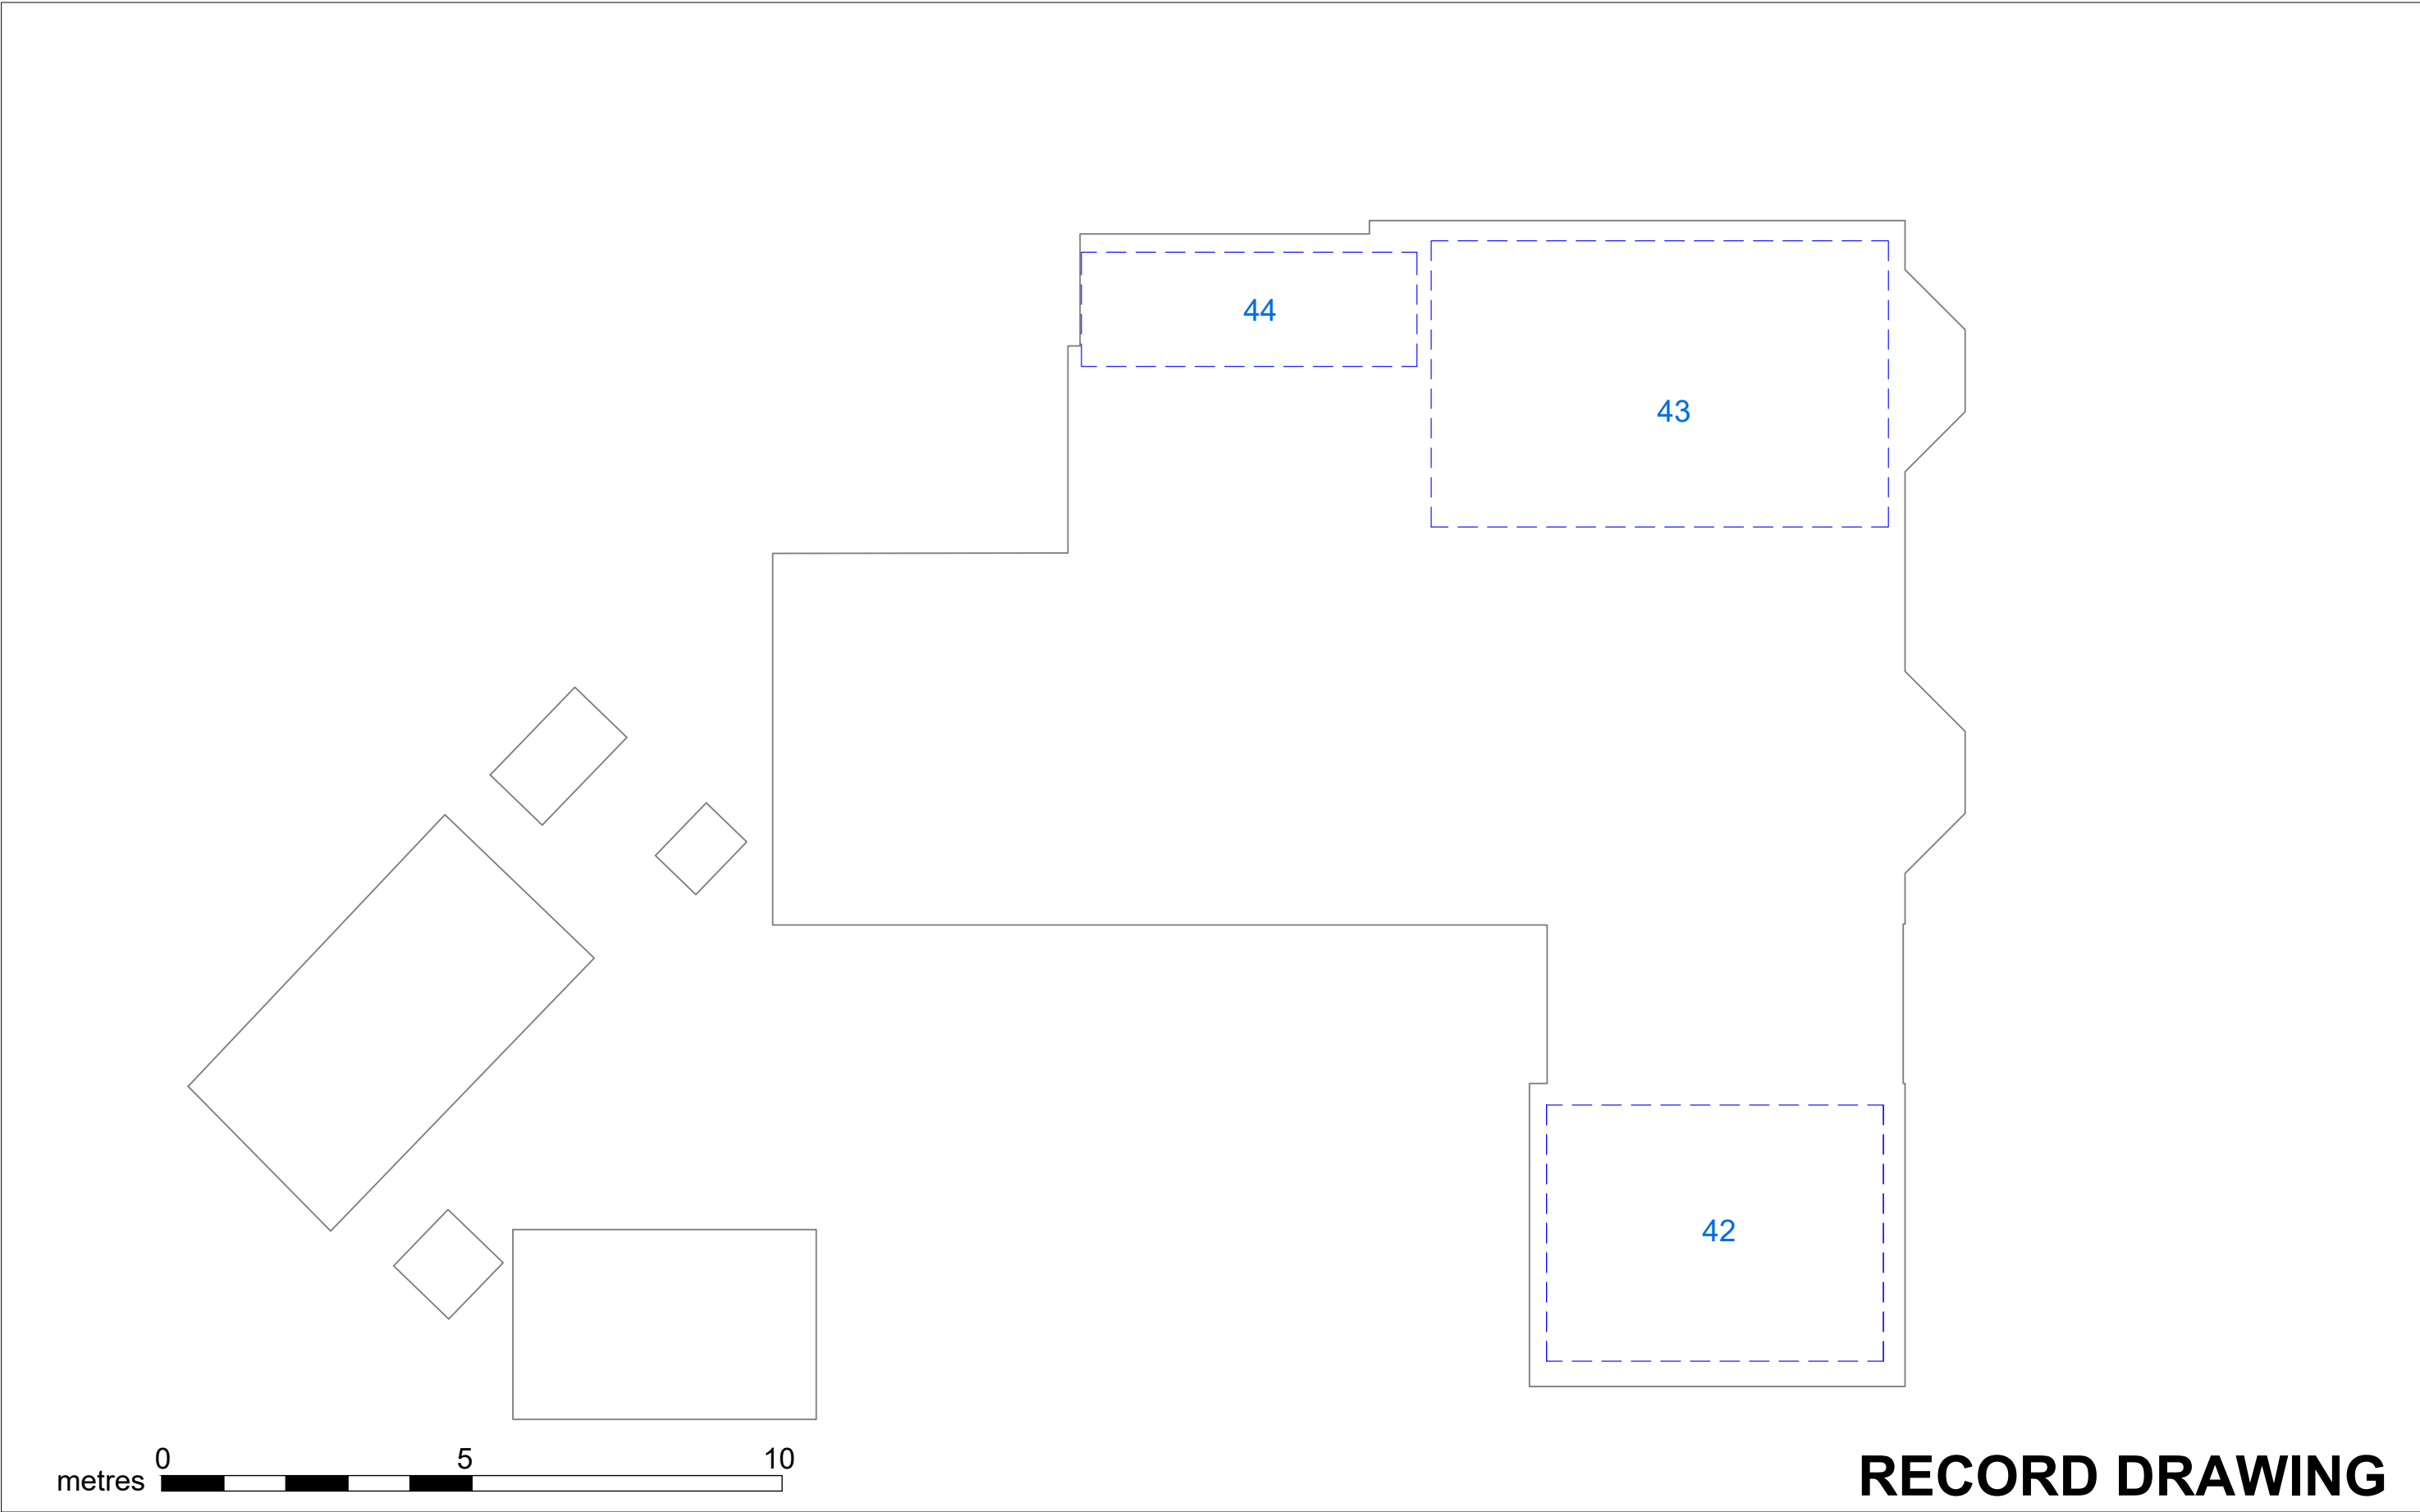

HCC Property Services,
Three Minsters House,
76 High Street, Winchester SO23 8UL.
tel: 03707 790555

Notes		
1 This drawing is © copyright Hampshire County Council 2025. No unauthorised reproduction permitted. All rights reserved.	3 © Crown copyright and database rights 2025 Ordnance Survey 100019180. Use of this data is subject to terms and conditions. You are granted a non-exclusive, royalty free, revocable licence solely to view the Licensed Data for non-commercial purposes for the period during which HCC makes it available. You are not permitted to copy, sub-license, distribute, sell or otherwise make available the Licensed Data to third parties in any form. Third party rights to enforce the terms of this licence shall be reserved to Ordnance Survey.	
2 No dimensions are to be scaled from this drawing		

rev	description	date	by
A	Amended to show both sites	16/08/12	HJP
B	1st floor added to Bath Lane	21/08/12	HJP
C	Properties split	02/04/13	HJP
D	HSS amendments added.	04/09/19	HJP
E	Floor plan updated following two refurbishment projects.	03/03/20	clw
F	Floor plan updated to latest format.	20/03/25	HJP

PROJECT				SHEET CONTENTS		
Fareham Day Services- Bath Lane Annexe, Fareham, PO16 0DJ				Property Records Loft Plan		
10008001873				Sheet 4 of 4		
SCALE		DATE	DRAWN.	CHKD.	DRAWING No.	REVISION
1:50 @ A1 1:100 @ A3		Unknown	Internal	---	01_Rec/004	F
				FILE REF: 10008001873-FarehamDayServicesBathLaneAnnexe.dwg		

