




South Elevation

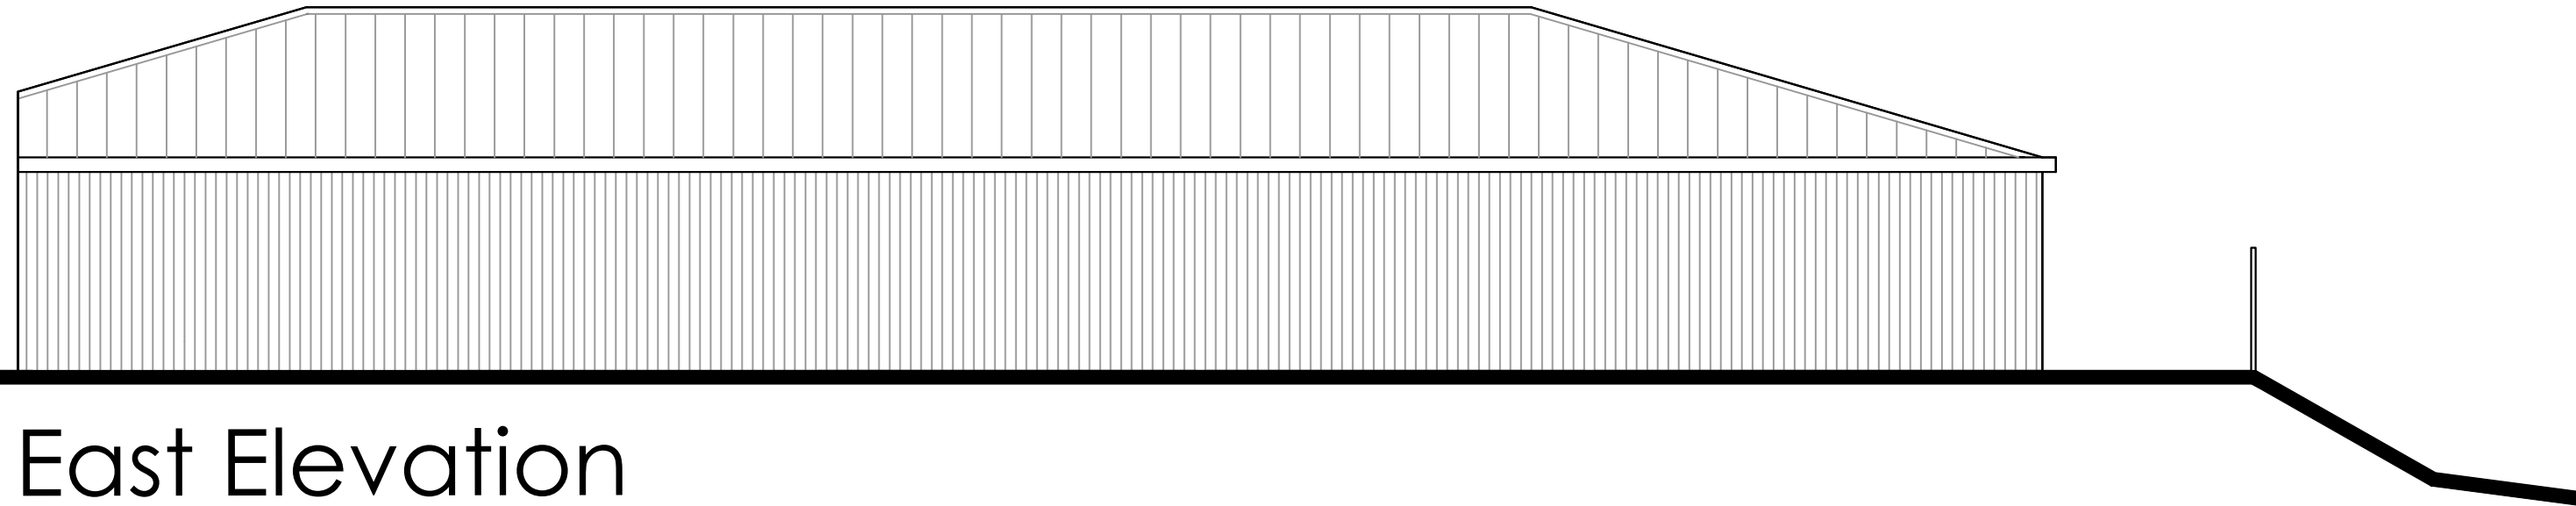



East Elevation

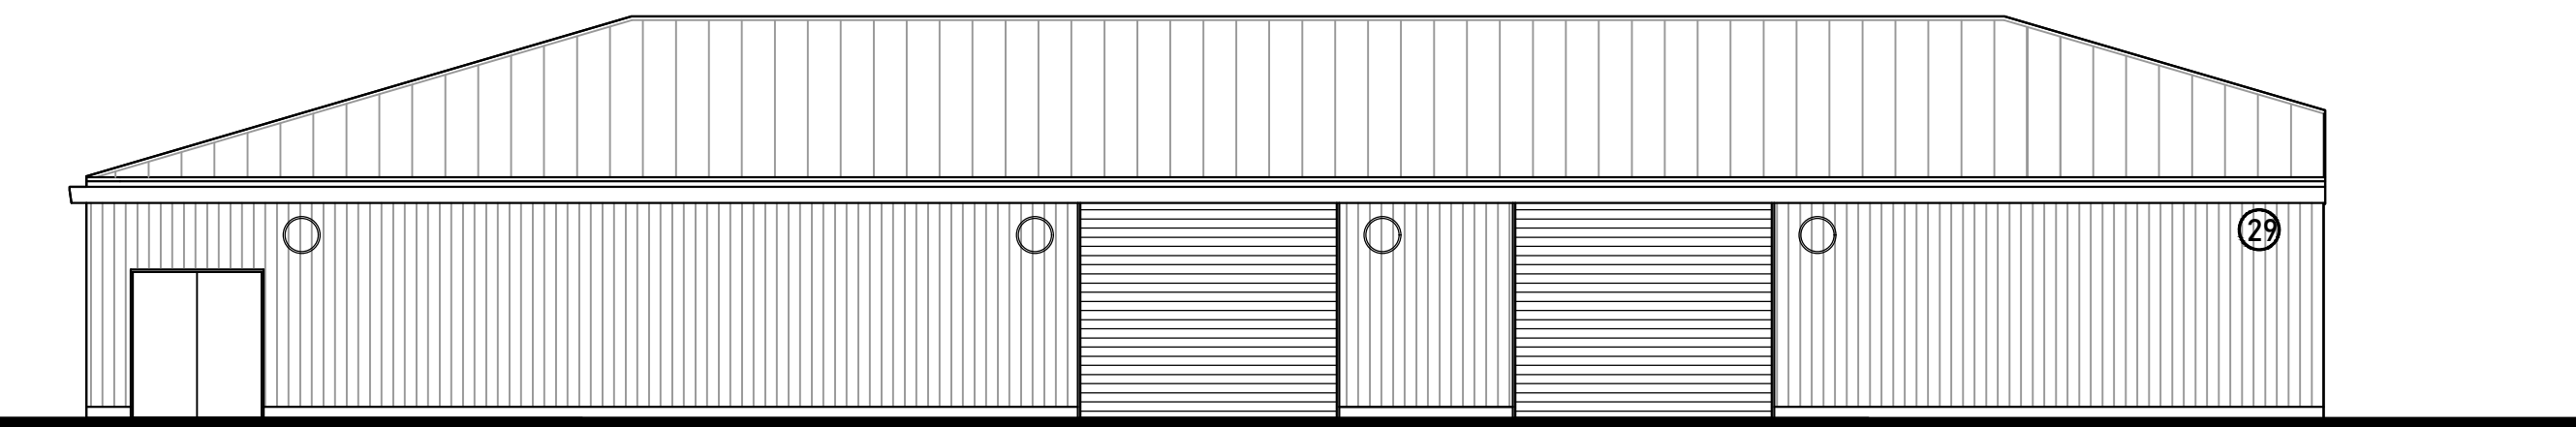

West Elevation

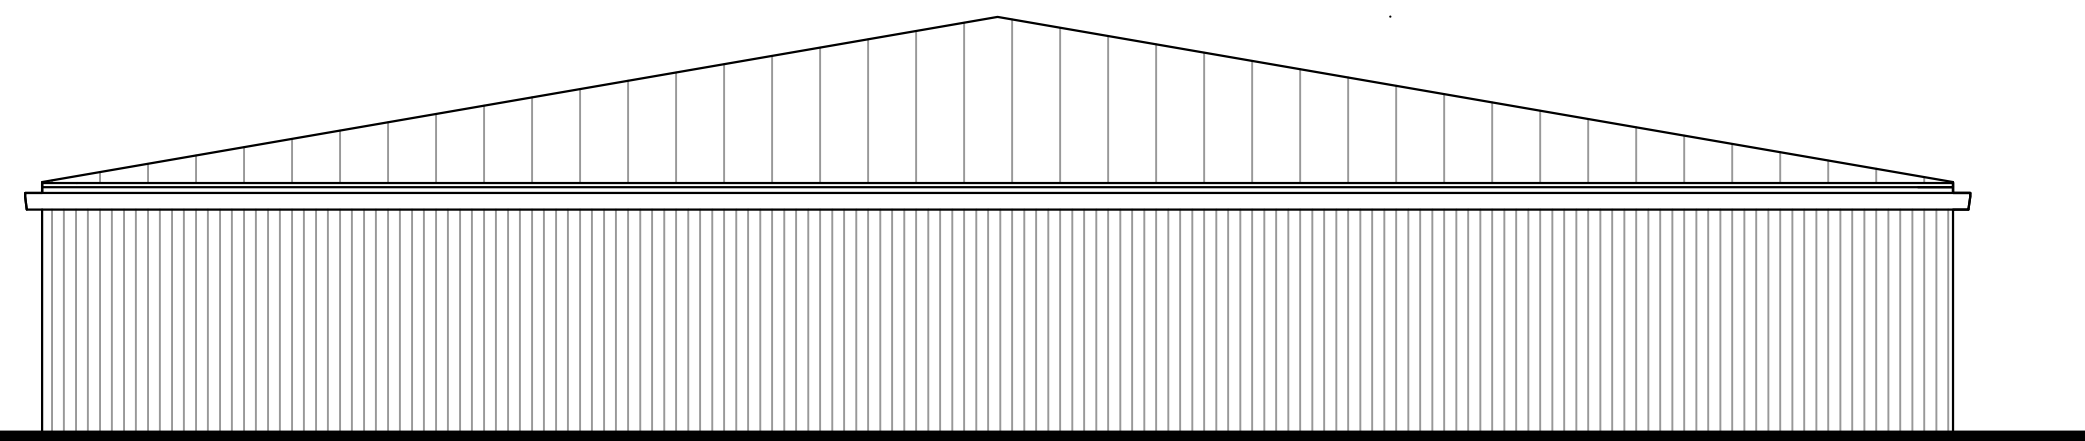

North Elevation

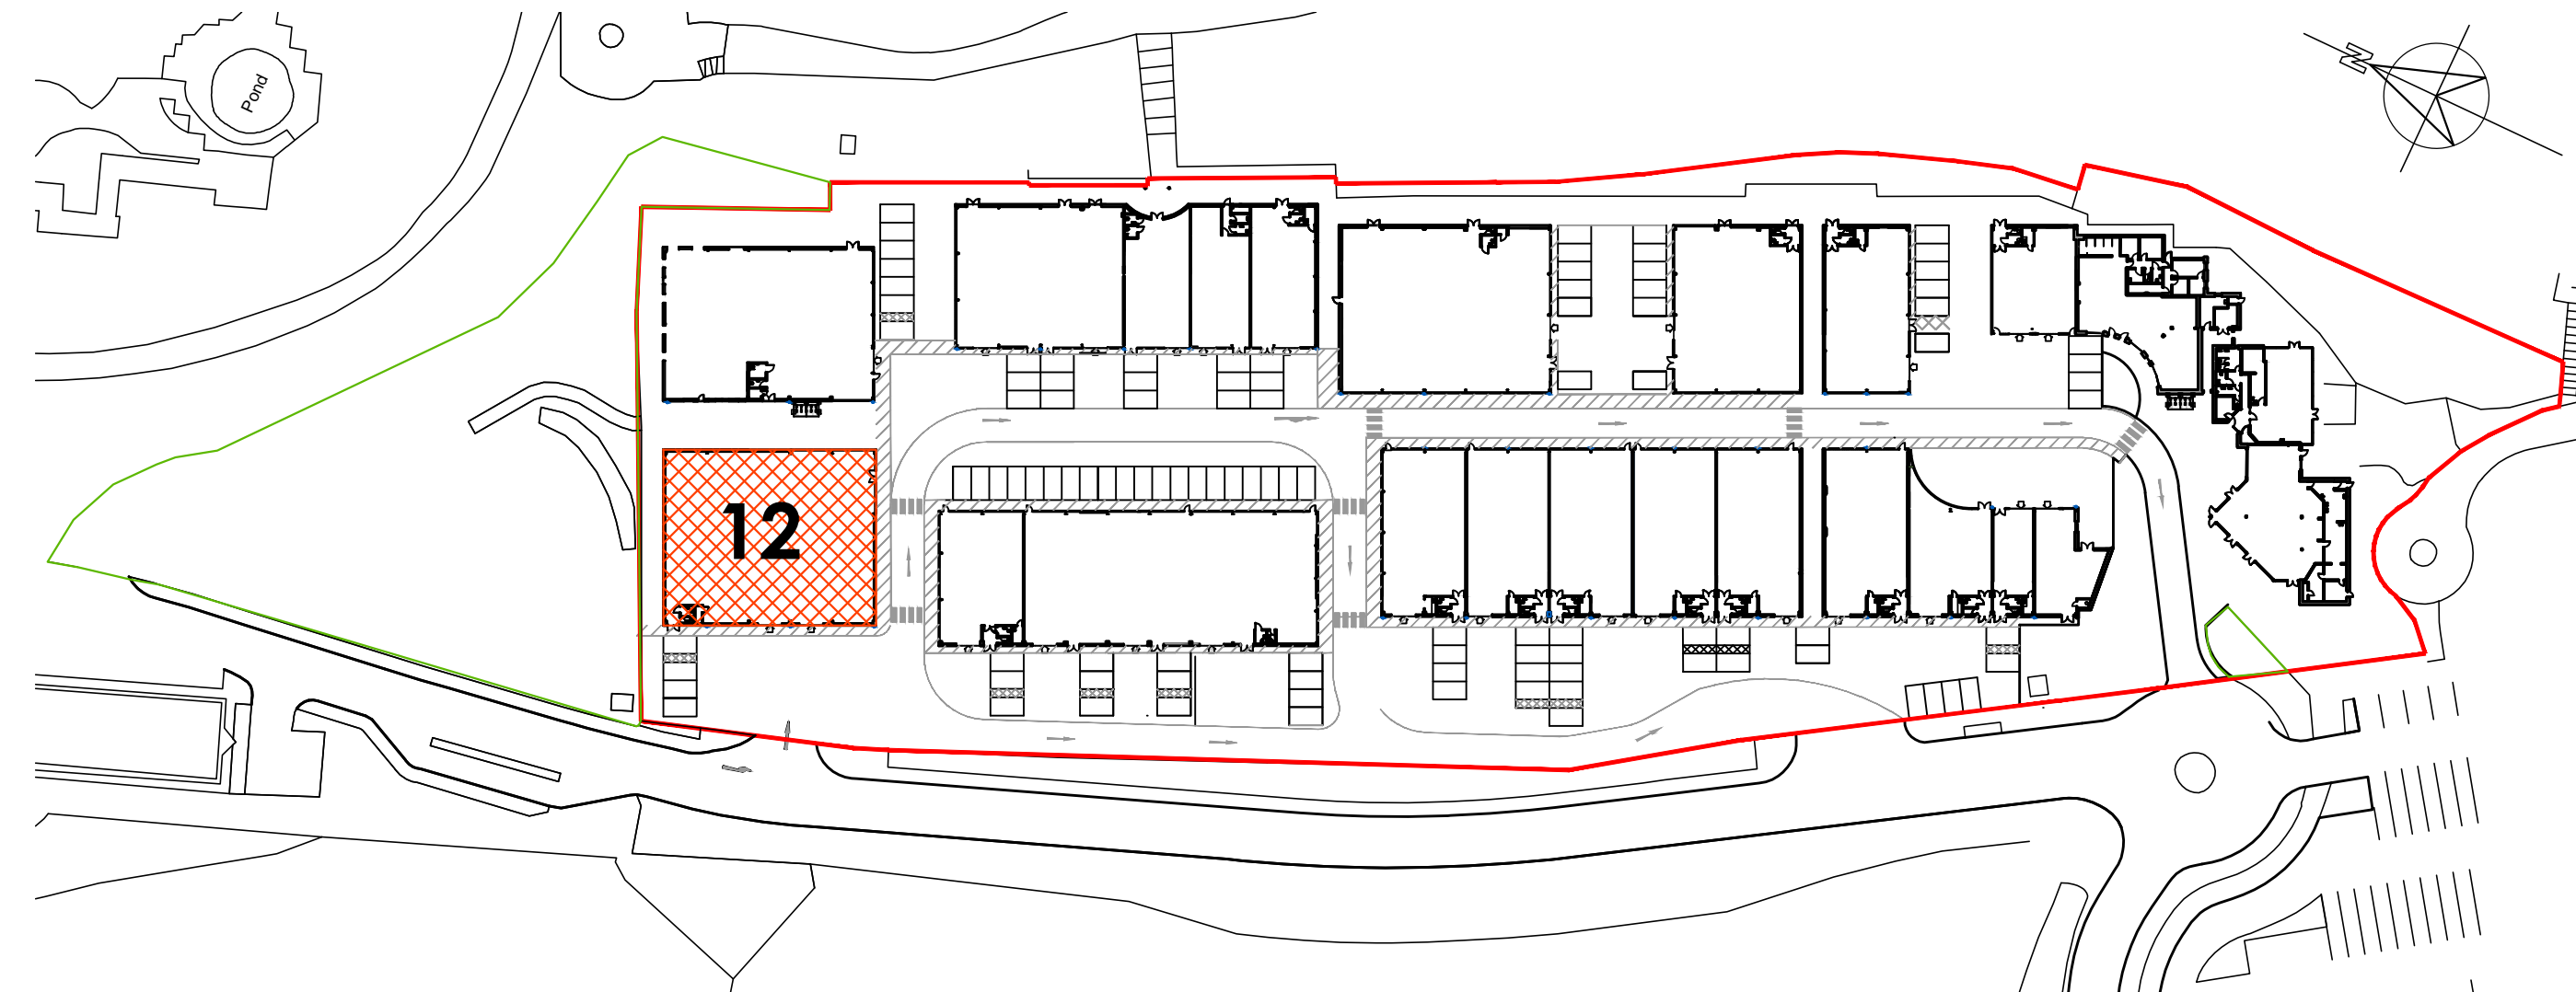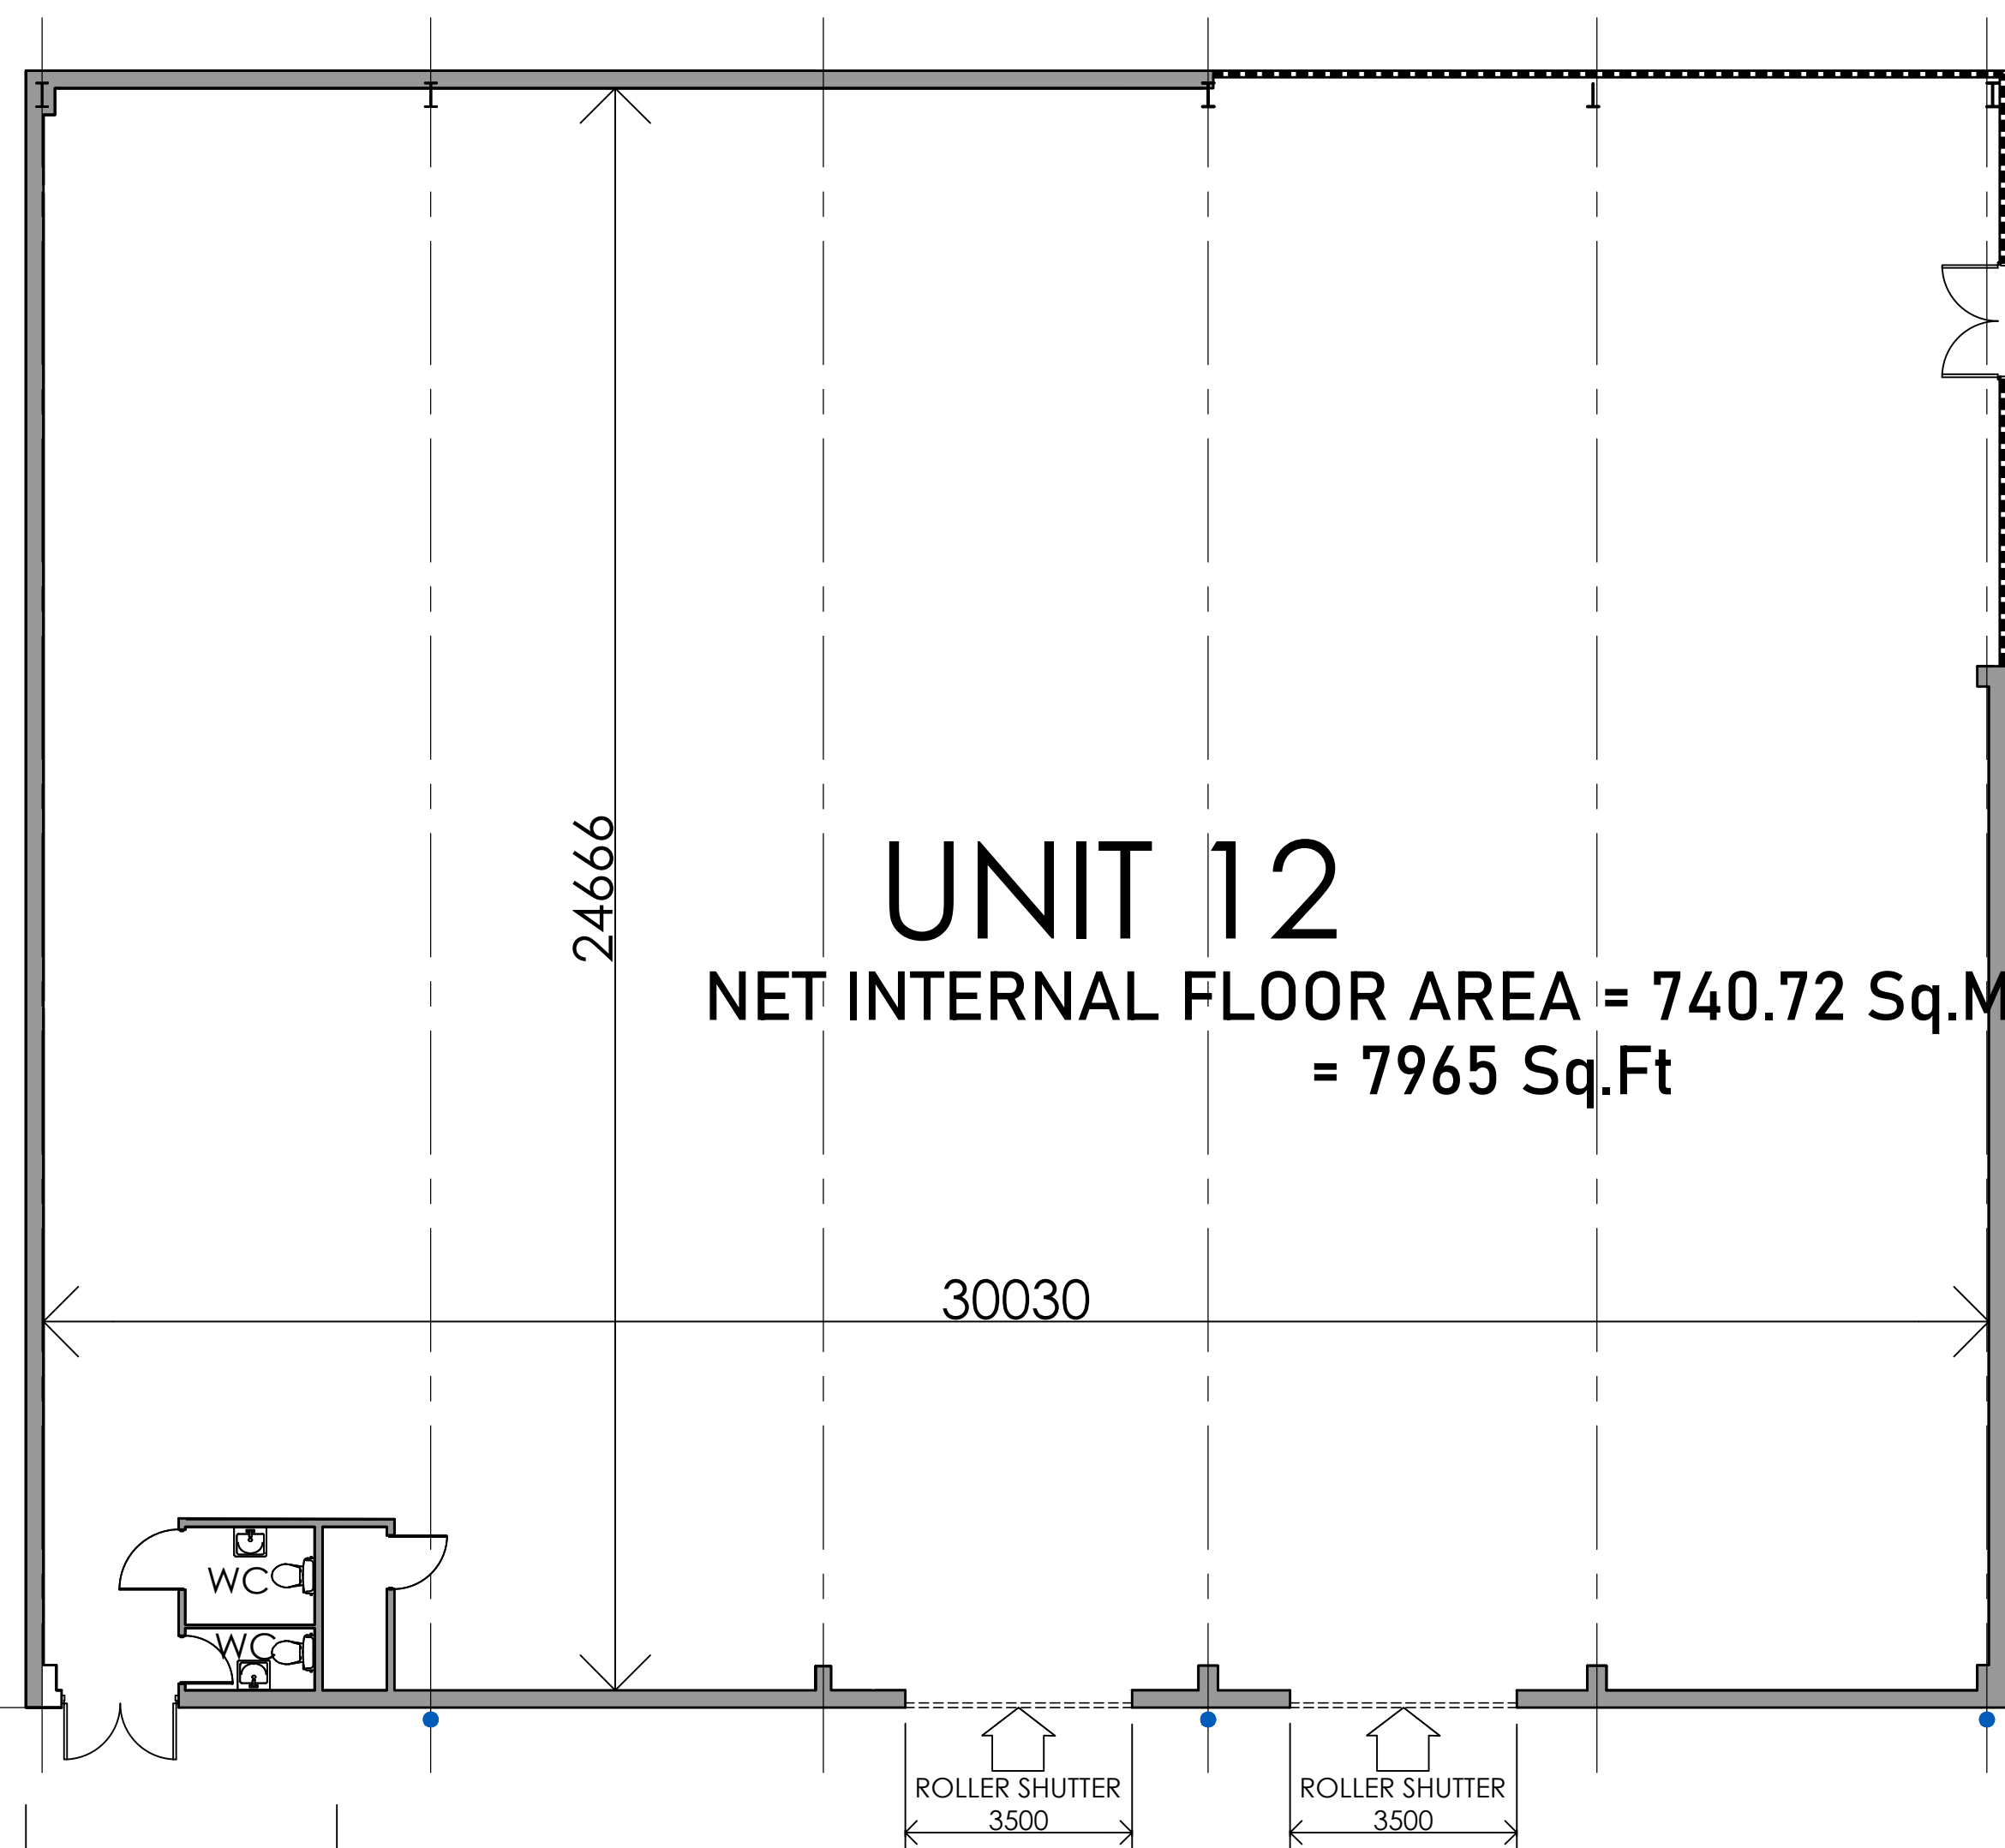

SITE PLAN 1:1000

UNIT: **UNIT 12**
NET INTERNAL FLOOR AREA = 740.72 Sq.M
= 7965 Sq.Ft

 **Creation Design**
Creation Design - Wales
Tel: 01495 616277 / 07508890294
www.creationdesign-wales.com
E-mail: info@creationdesign-wales.com

PROPOSED REDEVELOPMENT
FORMER FESTIVAL PARK SITE
QUEEN STREET
VICTORIA, EBBW VALE
NP23 6UN

UNIT 12. PLAN & ELEVATIONS
DATE: **June 2024** DRAWN BY: **P.P.**
SCALE(S): **1:100 @ A1** DRAWING NO: **24-073/AB/12** REV: