



NOTE:-
ALL DIMENSIONS ARE IN MILLIMETRES UNLESS OTHERWISE SPECIFIED.

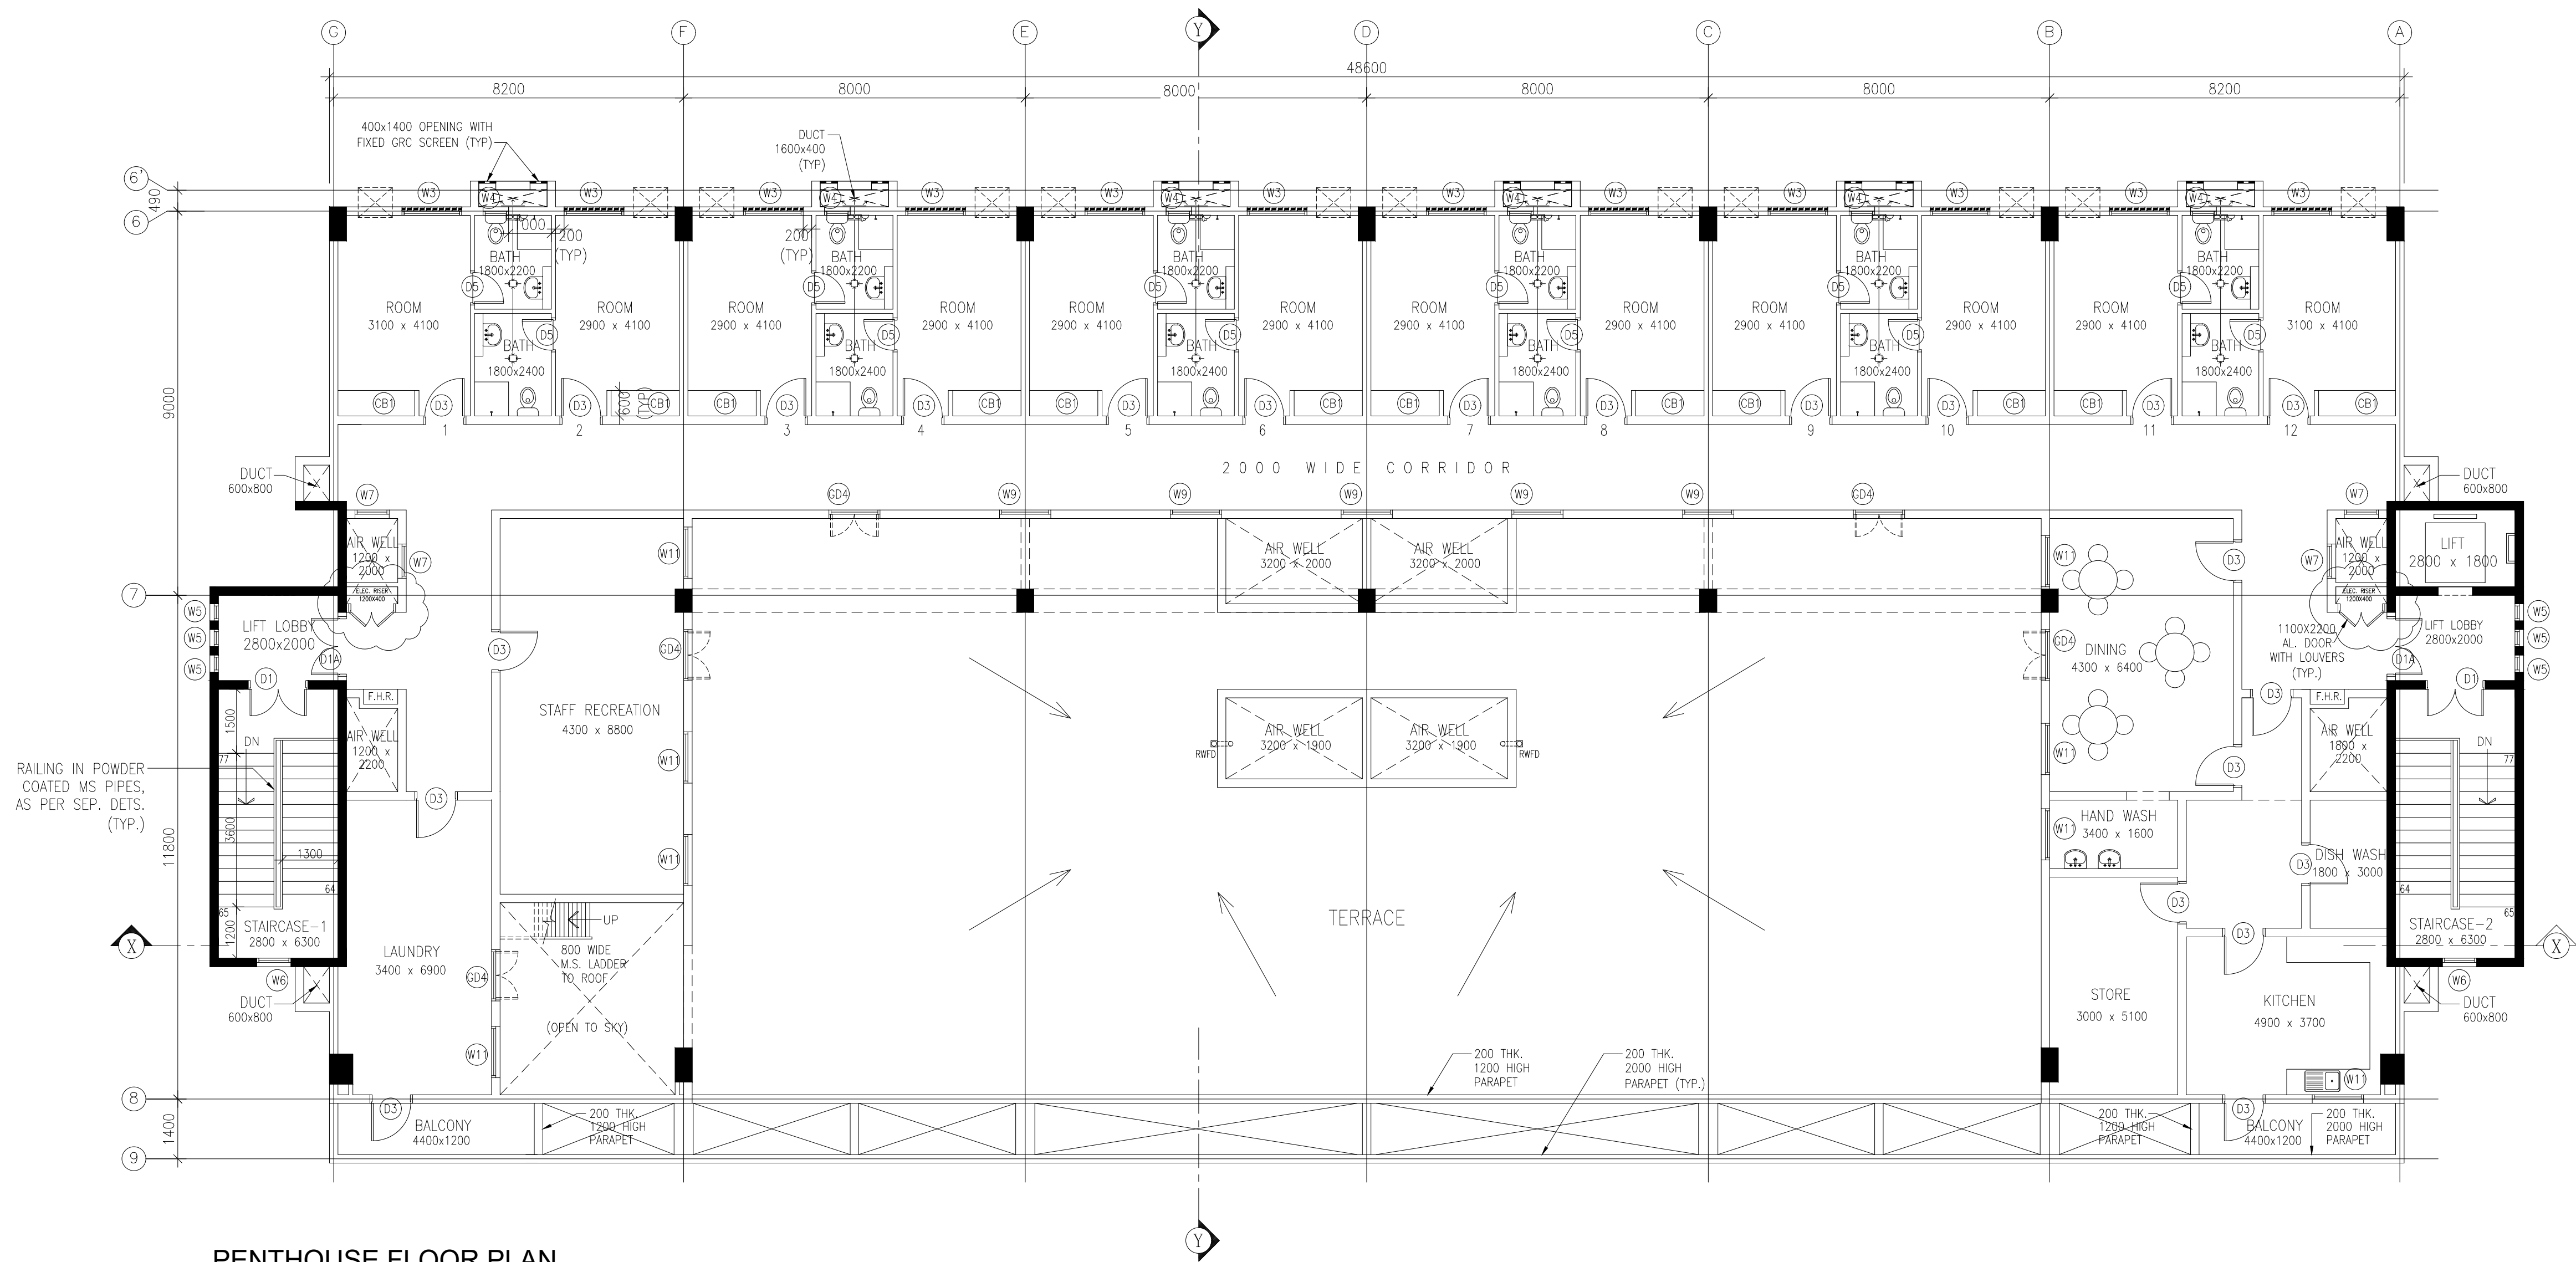

PENTHOUSE FLOOR PLAN

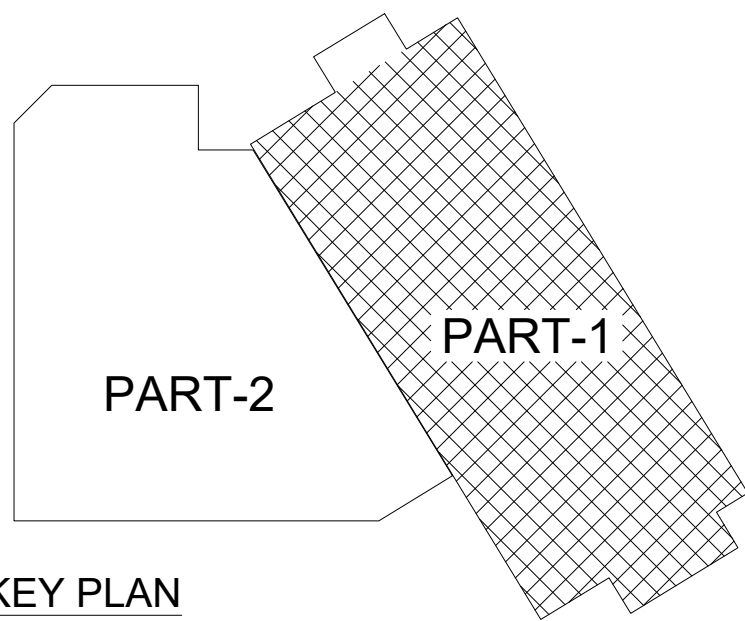

KEY PLAN

MAY'05	R1	ELECTRICAL RISERS ADDED.	
DATE	NO.	REVISION	SIGN

FOR MUNICIPALITY USE
MUSCAT MUNICIPALITY REGISTRATION NO.

AS BUILT DRAWING

استشارات قادري

KADRI CONSULTANTS

P.O. BOX 1604, JIBROO, POSTAL CODE 114, SULTANATE OF OMAN, TEL:795632 FAX:796091
FLAT NO. 301, BLDG. NO. 701, WAY NO. 2911, AL FARISAN STREET, RUWI

CLIENT	SUHAIL BIN SALEM ABDULLAH BAHWAN AL-MUKHEINY		
PROJECT	PROPOSED SHOWROOM PARTS STORE / WORKSHOP / ACCOMMODATION	LOCATION	PLOT NO.1233 HAHASSA BURAIMI
TITLE	PENTHOUSE FLOOR PLAN (SHOWROOM/ ACCOMMODATION BUILDING)		
SCALE	DATE	DRAWN	APPROVED
1:100	MAR'04		
ALL THE DRAWINGS ARE THE PROPERTY OF KADRI CONSULTANTS L.L.C. AND CANNOT BE USED WITHOUT THEIR WRITTEN PERMISSION. ALL THE PRINTS, SPECIFICATIONS AND THEIR COPY RIGHTS ARE THE PROPERTY OF KADRI CONSULTANTS L.L.C. & SHALL BE RETURNED AFTER THE COMPLETION OF WORK.			DRG.NO. 10.05



KEY TO ELEVATION