



FIRST FLOOR

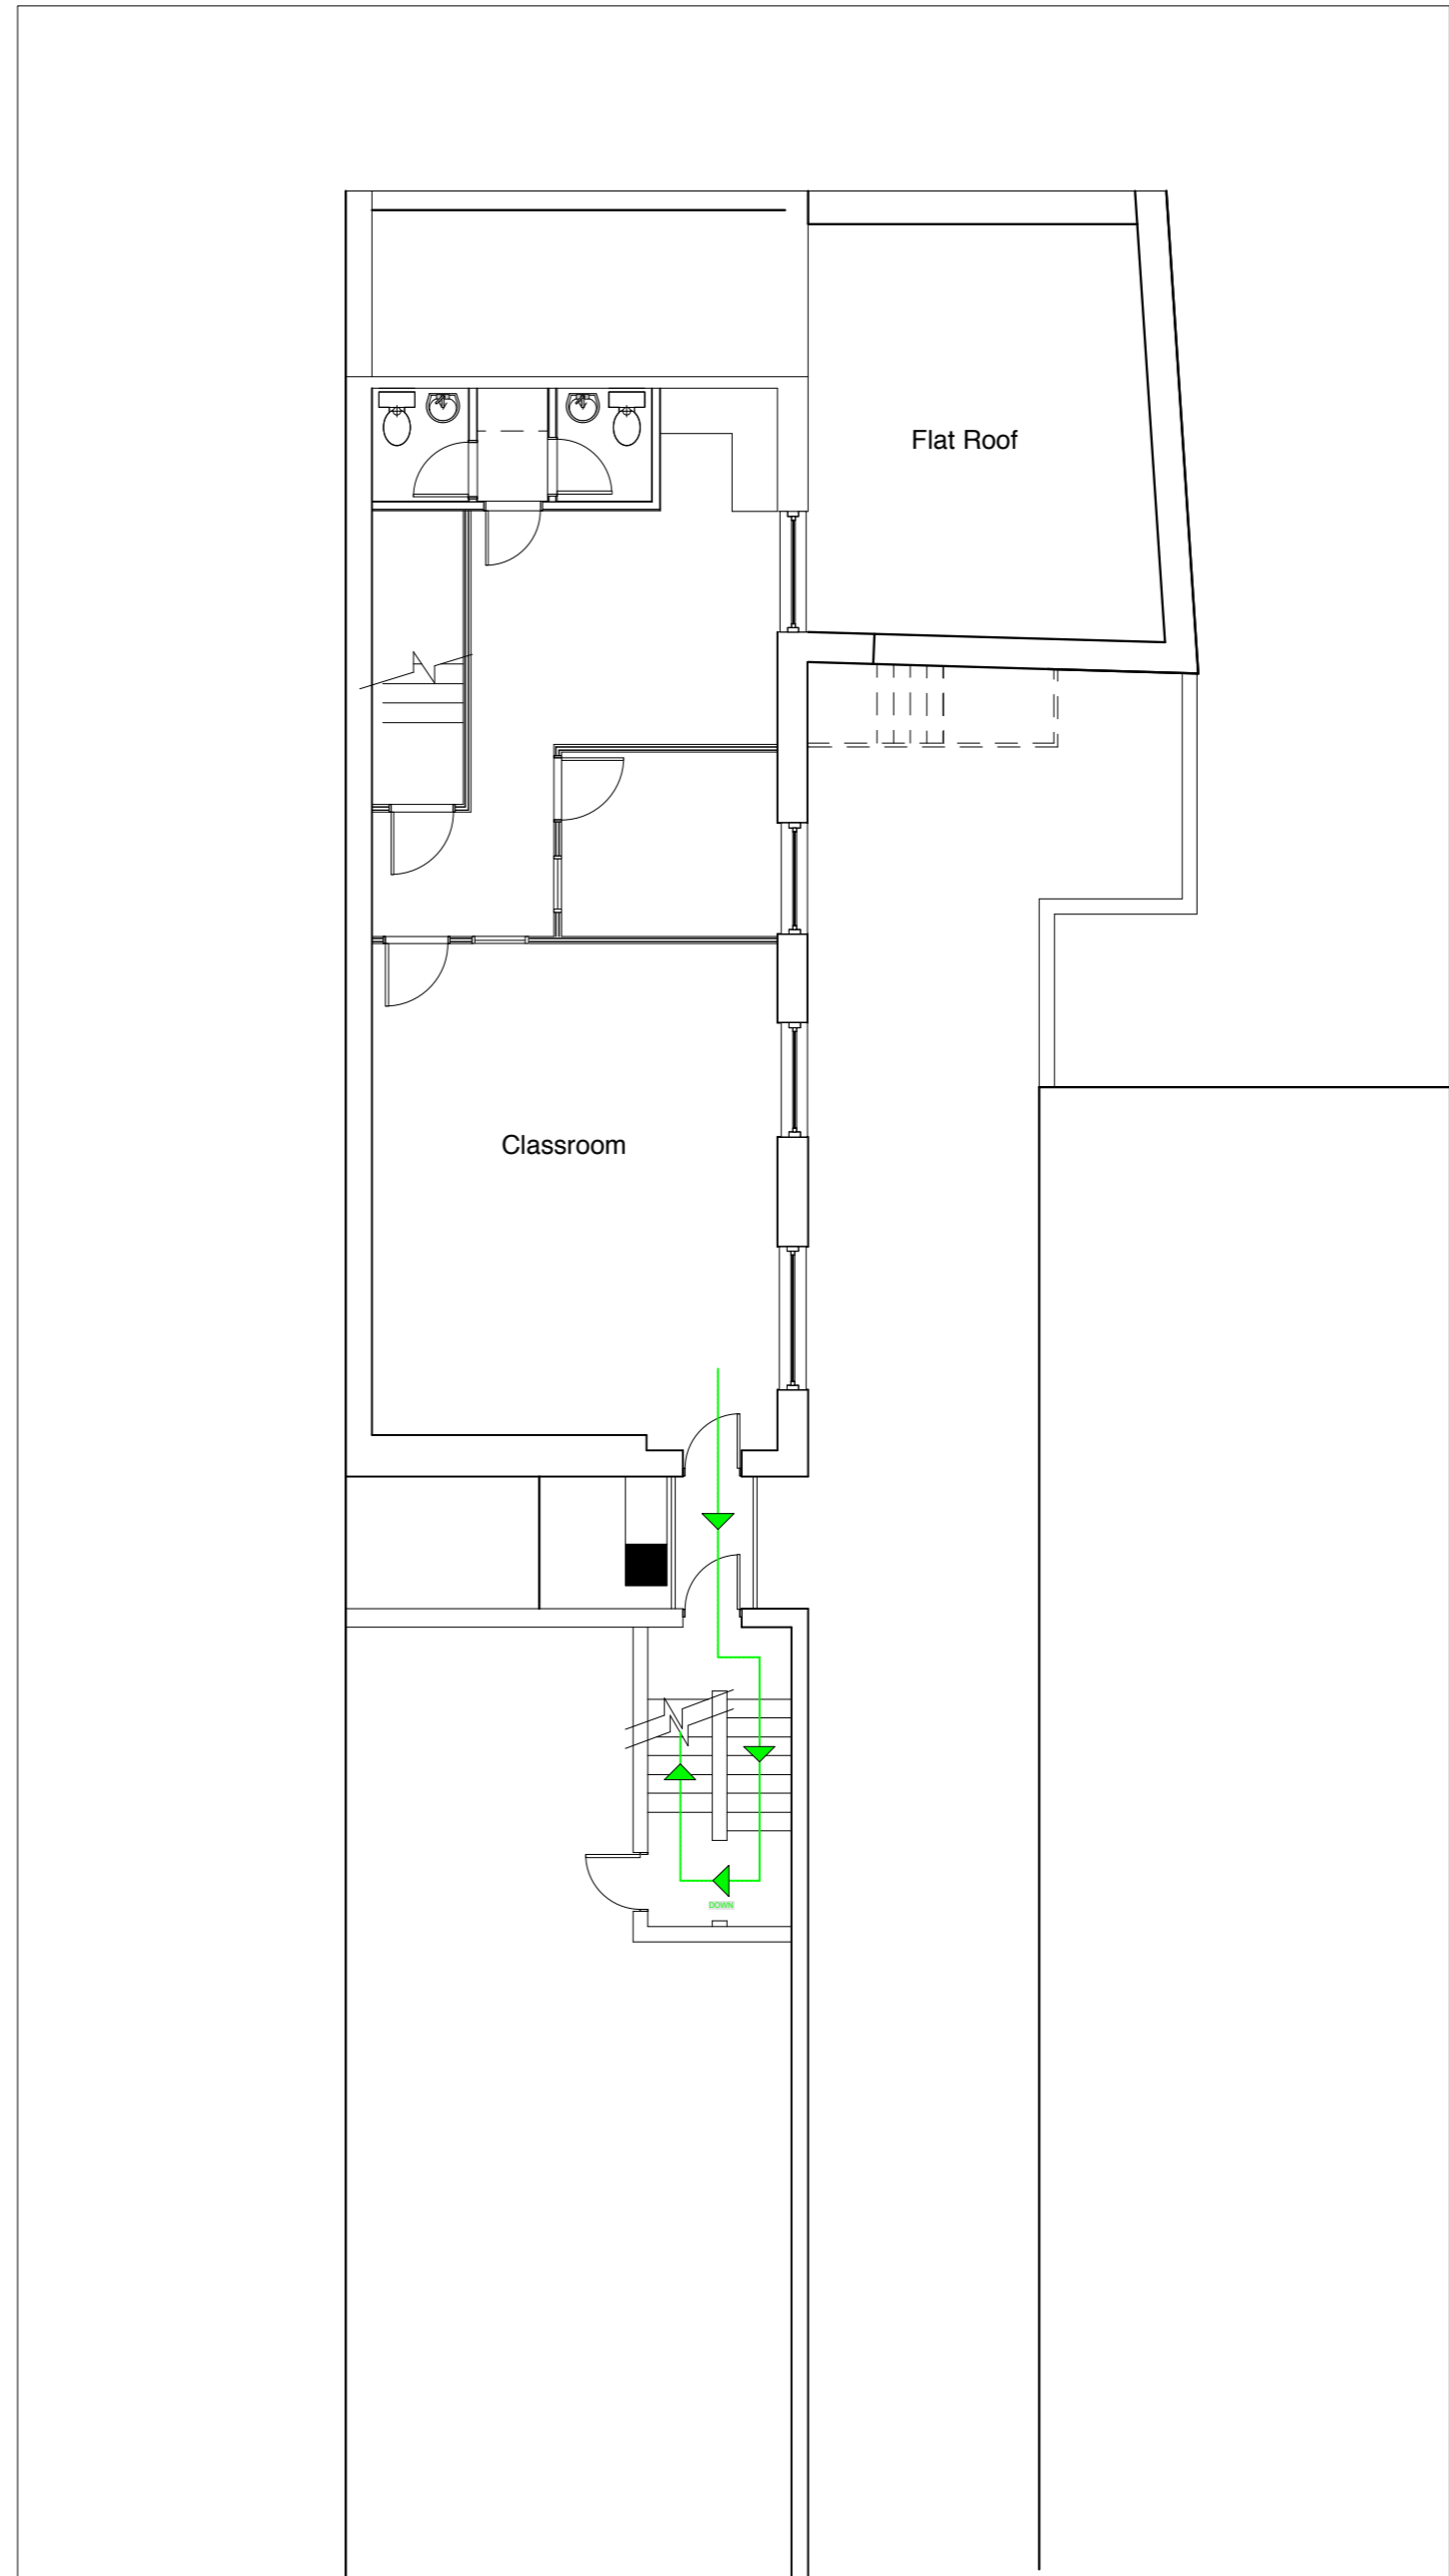

SECOND FLOOR

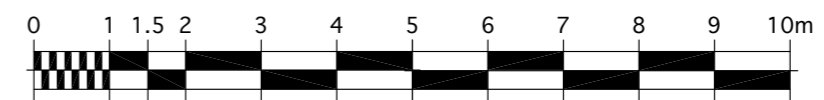

SCALE BAR

This drawing has been produced following a survey and does not constitute a design solution or approved layout

REVISIONS:			
REV.	DESCRIPTION	DATE	BY

Lacayo Wolfe
Design Consultants

11 Jerusalem Passage
LONDON EC1V 4JP

Telephone:
020 7336 6779

Facsimile:
020 7336 6799

PROJECT NO: **2099**

PROJECT : **47 KENSINGTON COURT
LONDON
W8**

CLIENT: **ASHBOURNE COLLEGE**

DRAWING: **AS BUILT LAYOUT
FIRST & SECOND FLOORS**

DRAWING NO: LW/2099-A2-AB-101	DATE: JUL'18
DRAWN LVT	SCALE 1:100 @ A2
	REV:

CONTRACTORS MUST VERIFY ALL DIMENSIONS ON SITE BEFORE COMMENCING ANY WORK. FIGURED DIMENSIONS TAKE PRECEDENCE OVER SCALED DIMENSIONS. THE COPYRIGHT OF THIS DRAWING IS RESERVED AND THE DRAWING MUST NOT BE DISCLOSED WITHOUT AUTHORITY.