


General Notes:

Do not scale from this drawing. Use marked dimensions.
Should any discrepancies be noted, please inform this office.
This drawing is copyright of Matthew Alchurch Architects Limited



FLOOR FINISHES KEY

- 1) Cleaned existing terrazzo flooring.
- 2) Architech Ash grey floor tiles.
- 3) Engineered oak flooring.
- 4) Chromitech warm 4.0 floor tiles.
- 5) External Treated Ribbed Timber Deck, Hard wood.
- 6) Resin bound gravel.
- 7) Planting, species Lavandula angustifolia 'Hidcote'.

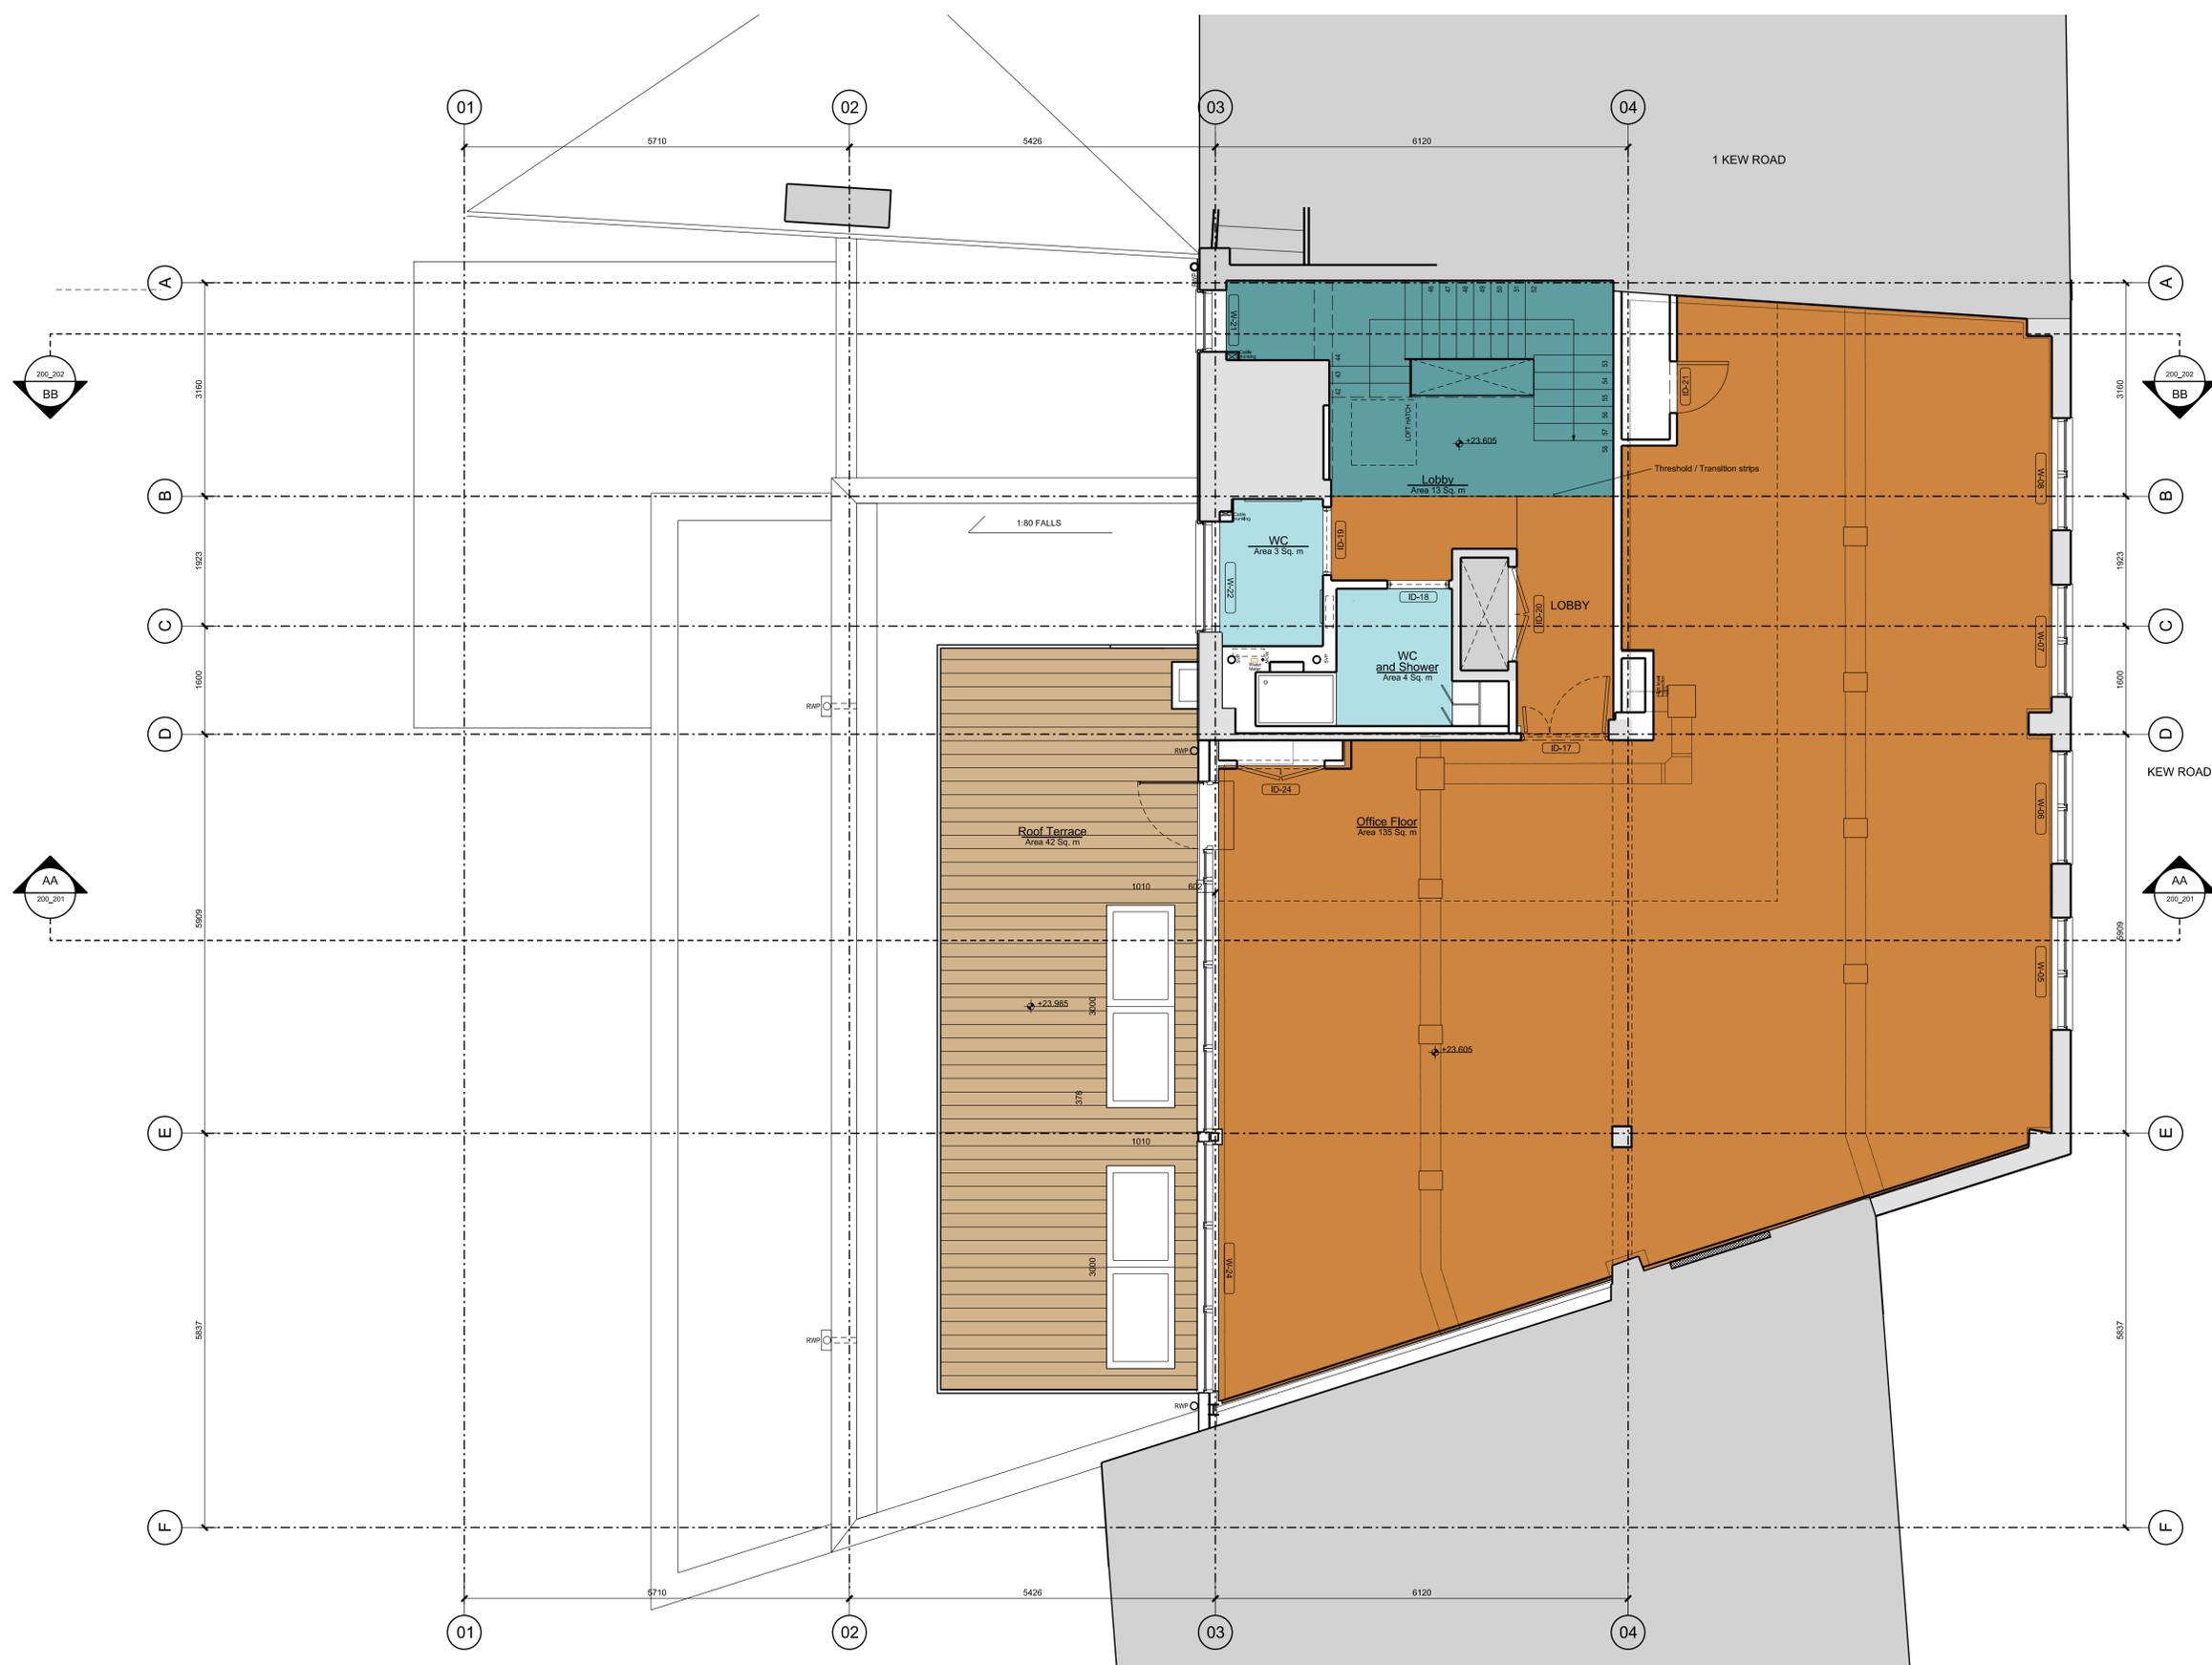

F	FINAL DESIGN ISSUE	03/06/15	BW	MA
E	ISSUED FOR CONSTRUCTION	18/09/14	BW	MA
D	ISSUED FOR CONSTRUCTION	15/08/14	BW	MA
C	AMENDED TO COMMENTS ISSUED FOR TENDER	17/04/14	BW	MA
B	AMENDED TO COMMENTS	11/04/14	BW	MA
A	ISSUED FOR TENDER	03/04/14	BW	MA

Rev: Description: Date Dwn by: Ckd by:



the boathouse design studio
27 ferry road teddington tw11 9nn
t: 020 8973 0050
e: info@maa-architects.com
w: www.maa-architects.com

Client: CBREI				
Project Name: MIDMOOR HOUSE OFFICE				
Drawing Title: THIRD FLOOR PLAN FLOOR FINISHES				
Project No: CBREI 001	Drawing No: 331_004	Revision: F	Scale: 1:50@A1	Date: 20/02/2014
Drawn by: BW	Checked by: MA	Drawing Status: FINAL DESIGN		