


LEVEL 03

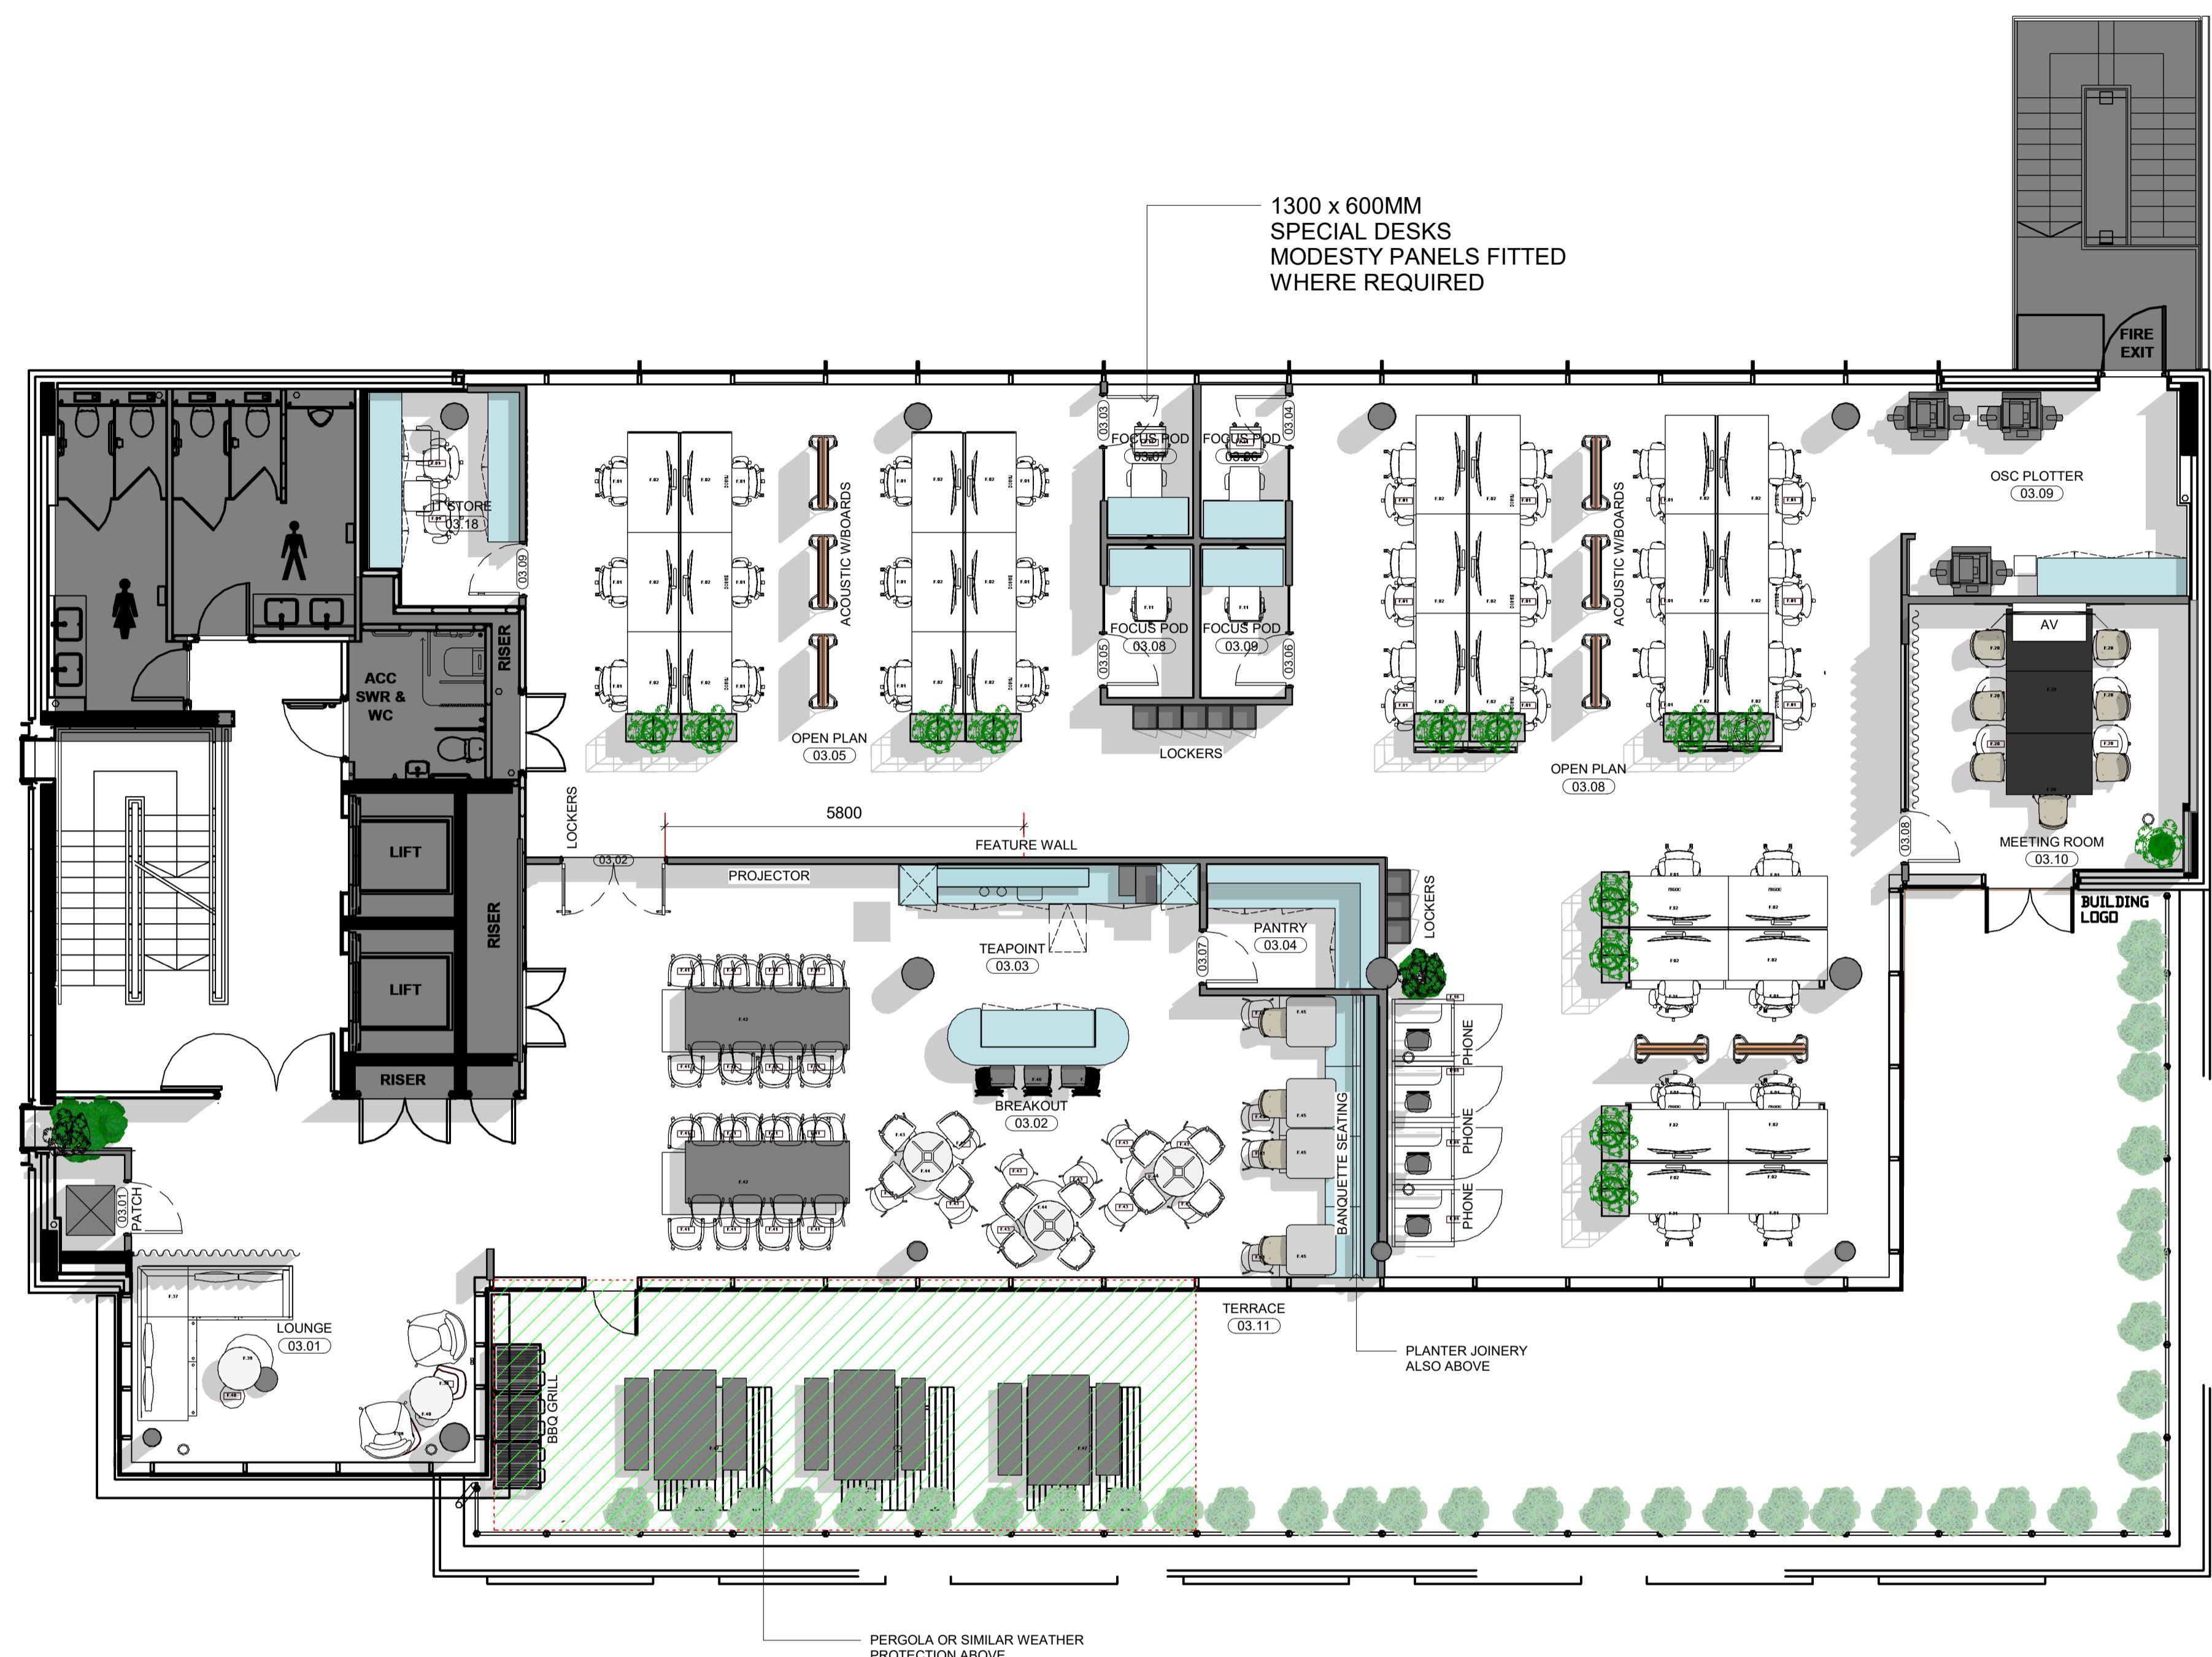

1 GA PLAN - LEVEL 03
1 : 75

KEYPLAN



GA KEY:

SOME SYMBOLS SHOWN MAY NOT APPEAR IN DRAWING, AND MAY NOT BE TO SCALE. DRAWING MUST BE PRINTED IN COLOUR.

WORK PROTECTED AREAS LANDLORDS DEMISE & WORKS NOT IN THE CONTRACT.

EXISTING CONDITIONS

PROPOSED PARTITIONS

PROPOSED GLAZED PARTITIONS

JOINERY ITEMS

ROOM NAME (00.01)

00 - FLOOR LEVEL
01 - ROOM NUMBER

FD30 - FIRE RATING
00 - FLOOR NUMBER
01 - ROOM NUMBER
DT - TYPE
01a - TYPE NUMBER

WHEELCHAIR TURN CIRCLE

SPOT ELEVATION MAKER

STATUS

AS BUILT DRAWINGS

REVISION DETAIL

REV DESCRIPTION BY DATE

CLIENT

GLENCORE

PROJECT ADDRESS

1 BELL STREET
MAIDENHEAD
SL6 1BU

DRAWING TITLE

GENERAL ARRANGEMENT
PLAN LEVEL 03

DWG NO: 46231-D3-V1-03-
DR-IA-0304

SUITABILITY: A

REVISION:

SCALE @ A1: As indicated

DATE:

DRAWN BY: LU

CHECKED BY: Checker