


FOR APPROVAL/COMMENT ONLY - DO NOT CONSTRUCT FROM THIS DRAWING

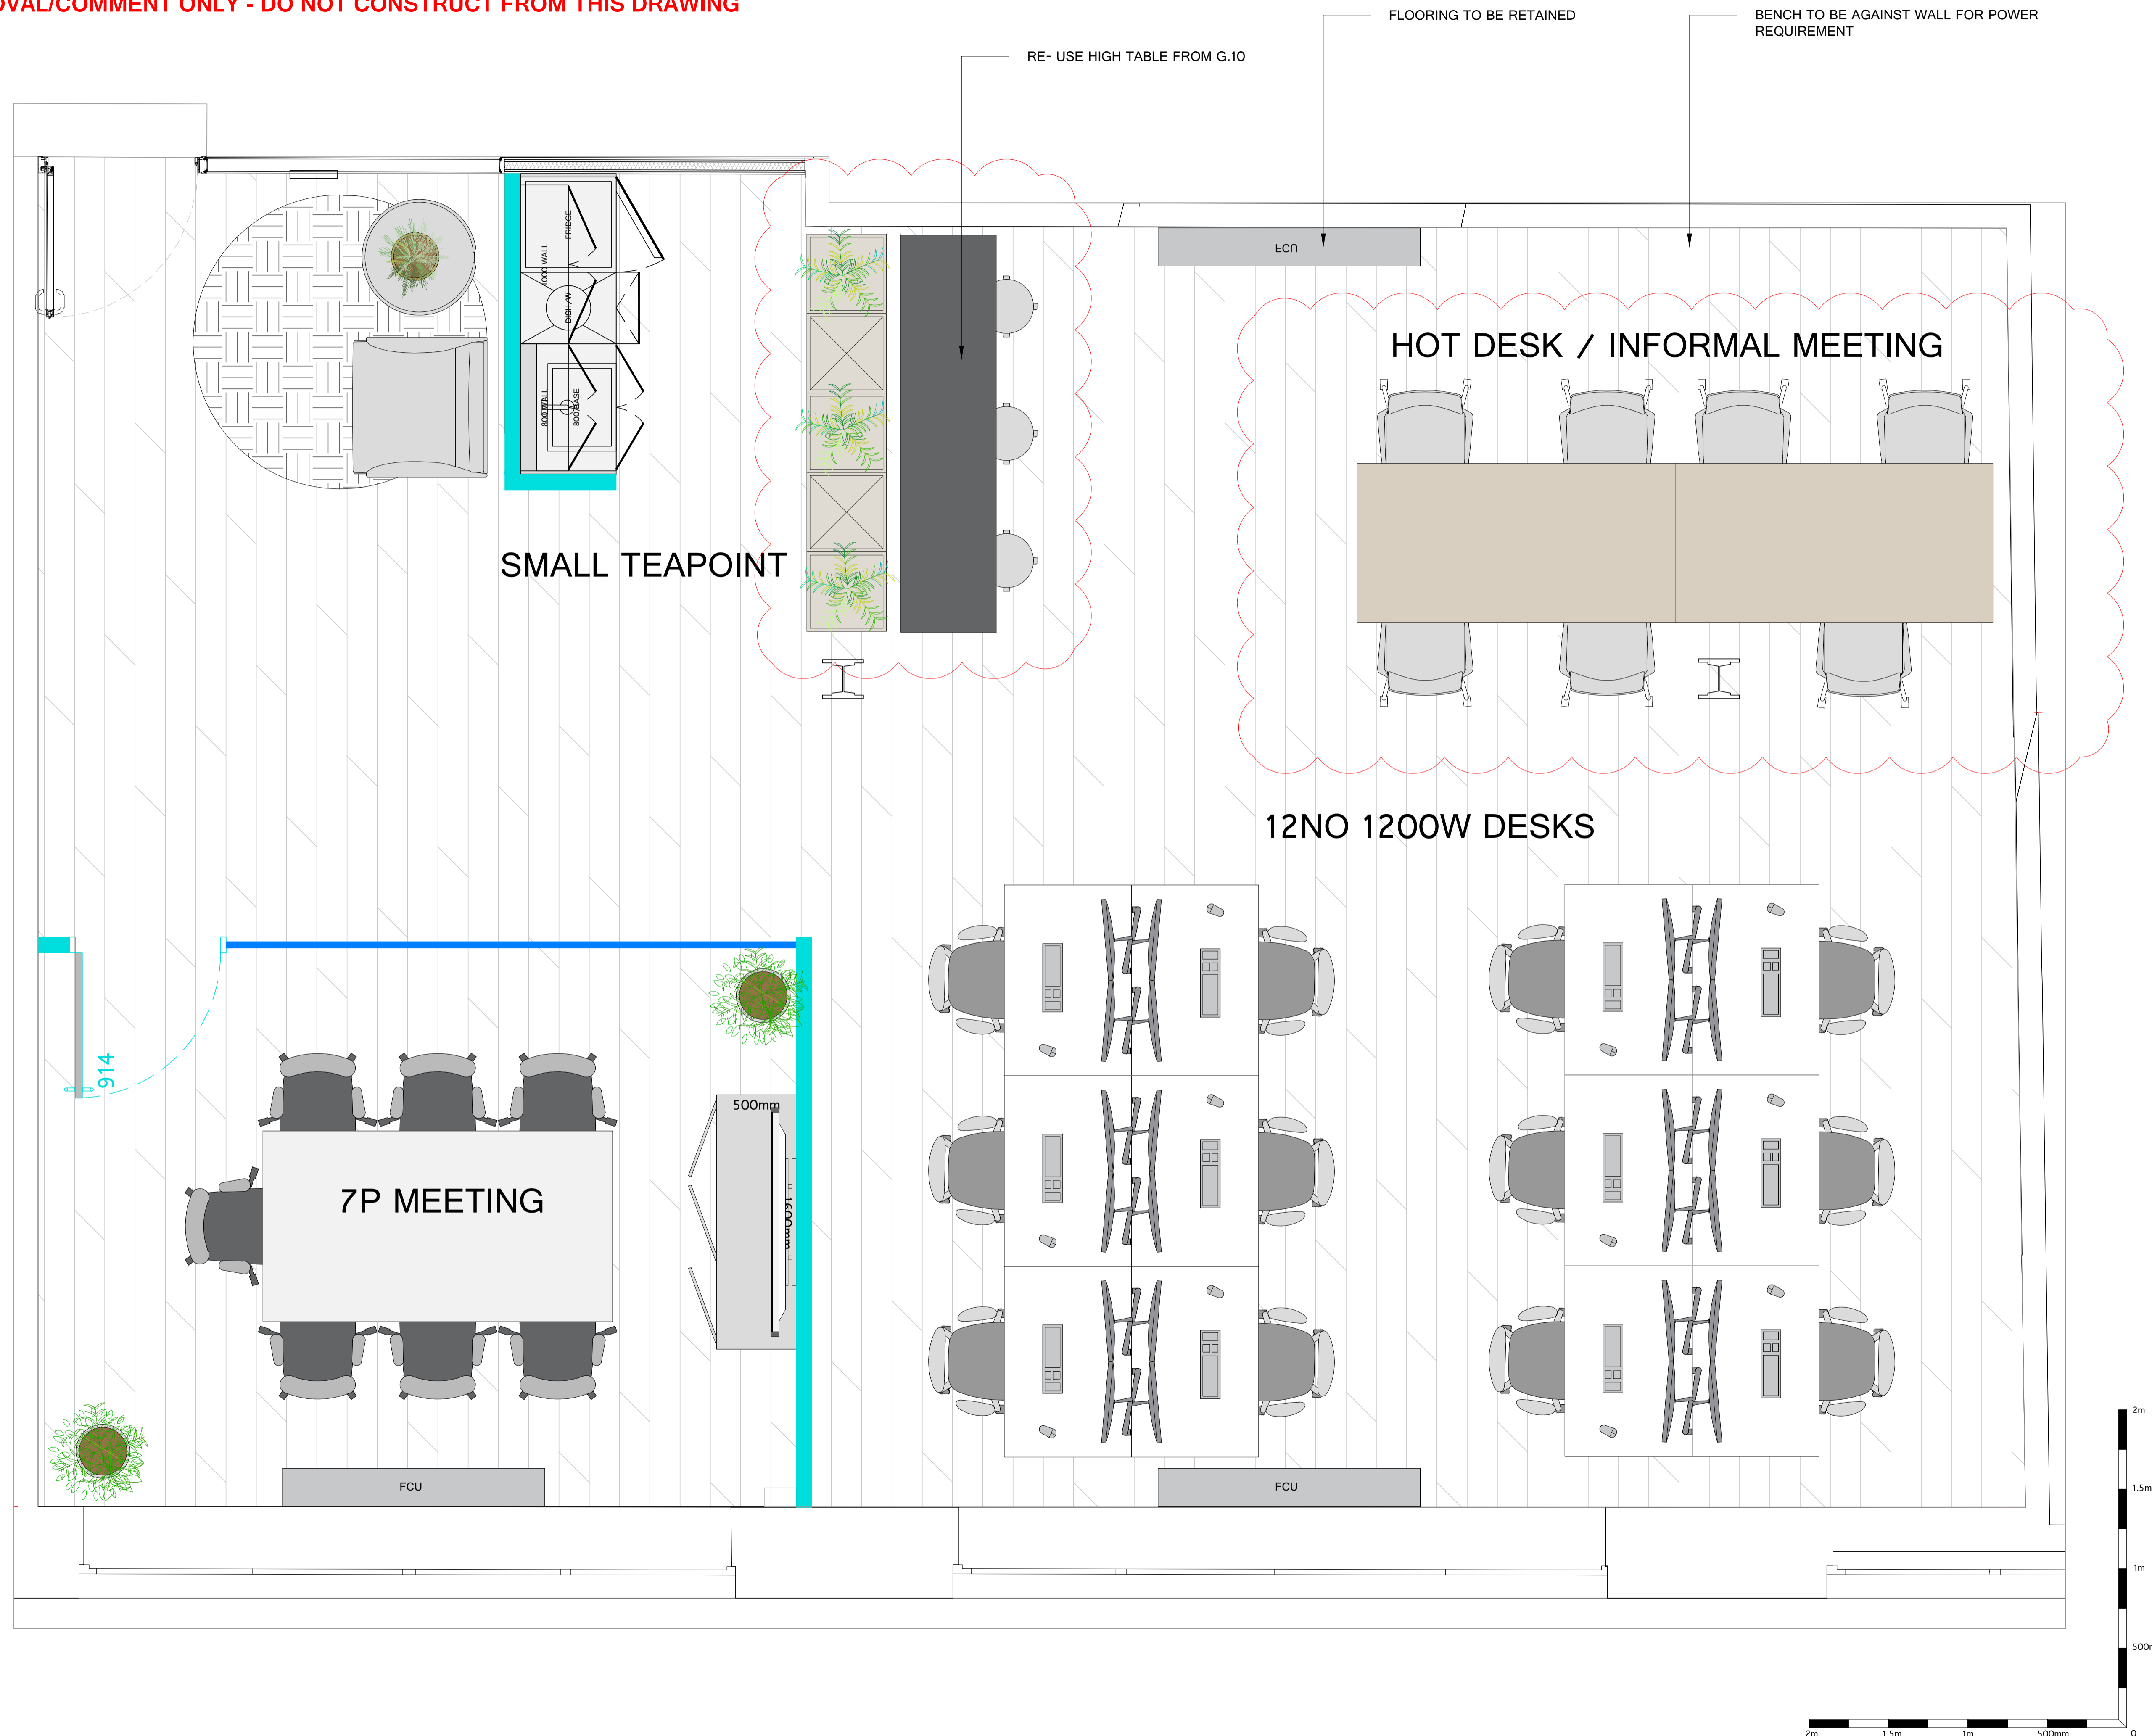

HELLO@DTHREESTUDIO.CO.UK
DTHREESTUDIO.CO.UK
020 7096 9520

NOTES

DTHREE STUDIO DO NOT ACCEPT LIABILITY FOR ANY ERRORS AND OMISSIONS ARISING FROM THE PREPARATION OF BASE BUILD DRAWINGS WHICH ARE DERIVED FROM ORIGINAL MATERIAL PROVIDED BY OTHERS. ALL DISCREPANCIES ARE TO BE REPORTED TO DTHREE STUDIO. GRID LINES ARE FOR REFERENCE PURPOSES ONLY. ALL DIMENSIONS TO BE VERIFIED BY CONTRACTOR ON SITE PRIOR TO ANY WORKS COMMENCING. DO NOT SCALE FROM THIS DRAWING. THIS DOCUMENT IS THE PROPERTY OF DTHREE STUDIO. COPYRIGHT IS RESERVED BY THEM, AND THE DRAWING IS ISSUED ON THE CONDITION THAT IT IS NOT COPIED, REPRODUCED OR RETAINED BY, NOR DISCLOSED TO ANY UNAUTHORISED PERSON, EITHER WHOLLY OR IN PART, WITHOUT THE CONSENT IN WRITING FROM DTHREE STUDIO.

©DTHREE STUDIO



STATUS

- Approval / Comment
- Building Control
- Contract
- Construction
- As-Built

REVISION DETAIL

REV	DETAIL	BY	DATE
SK01	FIRST DRAWING ISSUE	LH	25.07.22
SK02	REVISED TEST FIT	HM	10.8.22
SK03	REVISED FOLLOWING CLIENT COMMENT	HM	11.8.22
SK04	REVISED FOLLOWING SURVEY	HM	12.8.22

CLIENT

AKOYA POWER ROAD LTD
PROJECT ADDRESS
STUDIO 1
114 POWER RD, CHISWICK
W4 5PY LONDON

DRAWING TITLE

SECOND FLOOR - 2.06
GENERAL ARRANGEMENT

FOR APPROVAL

DWG NO:	00000-02-GA
REVISION:	SK04
SCALE @A1:	1:20 @ A3: 1:40
DATE:	25.07.22
DRAWN BY:	LH
CHECKED BY:	XX

