



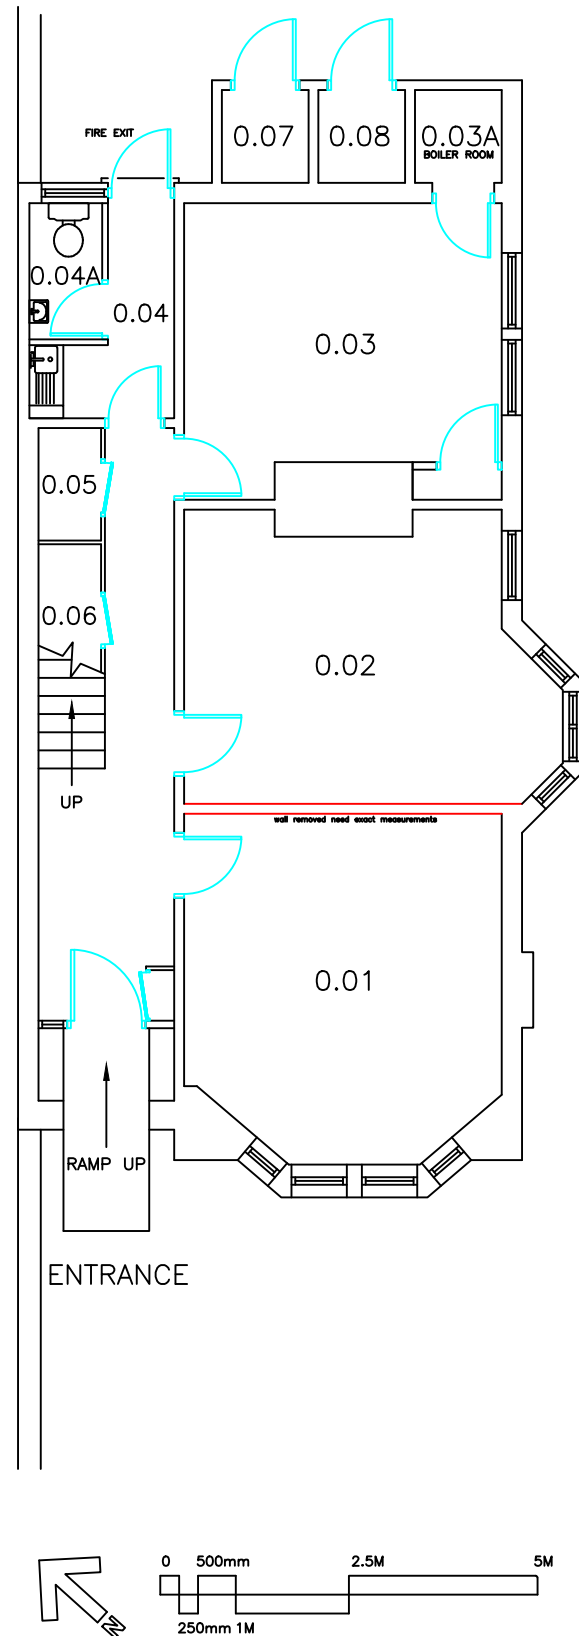


Estates

Title
No. 2 NORTH ROAD.
GROUND FLOOR PLAN.

Scale: 1:100\A3 SHEET	Original Layout Drawn: GPI
Last Revised Drawn/Date:	RLF - 10/07/2024
Rec. Drg. No.:	AQ\AQ05\FP\00

Record Drawing

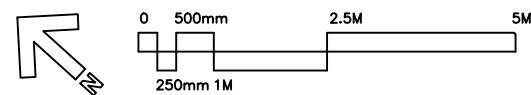
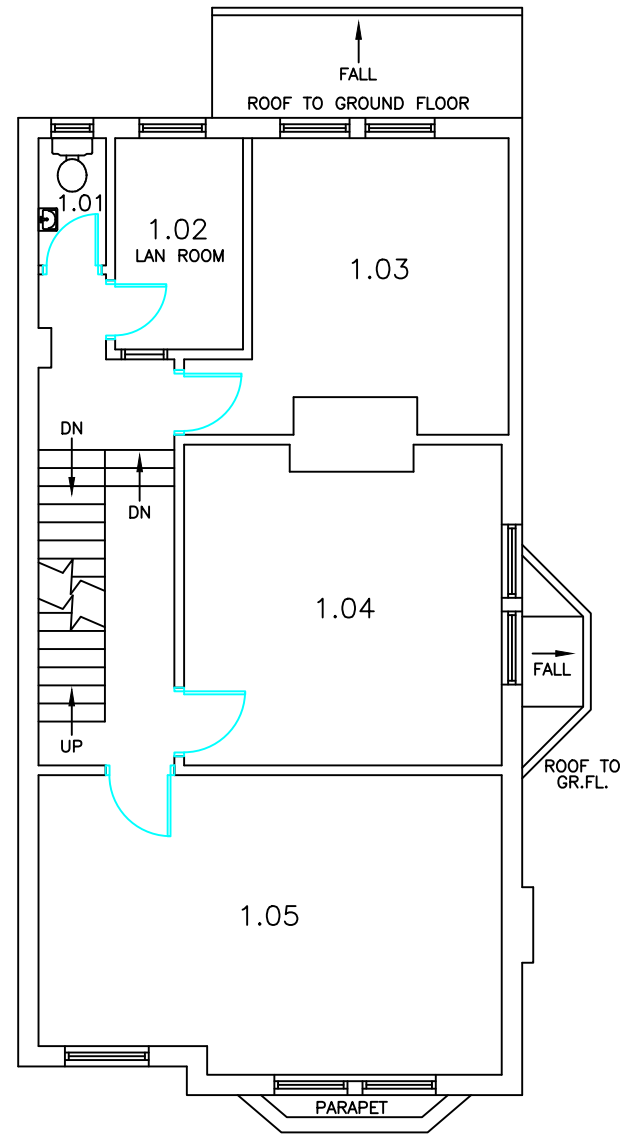


Estates

Title
**No. 2 NORTH ROAD.
FIRST FLOOR PLAN.**

Scale: 1:100\A3 SHEET	Original Layout Drawn: GPI
Last Revised Drawn/Date:	RLF - 10/07/2024
Rec. Drg. No.:	AQ\AQ05\FP\01

Record Drawing

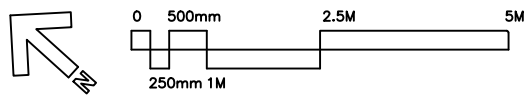
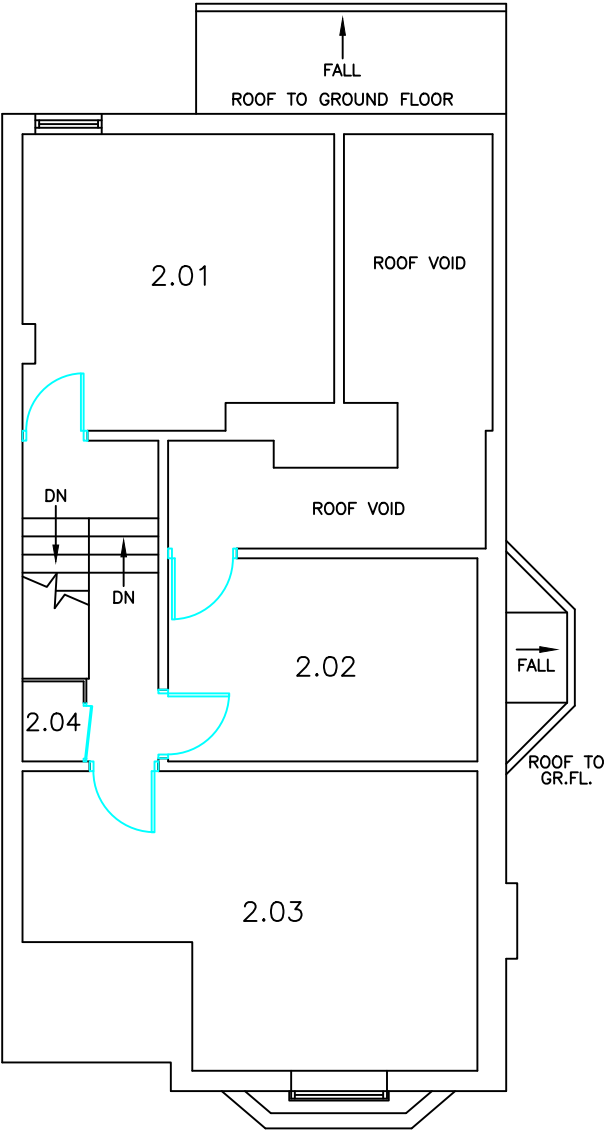


Estates

Title
**No. 2 NORTH ROAD.
SECOND FLOOR PLAN.**

Scale: 1:100\A3 SHEET	Original Layout Drawn: GPI
Last Revised Drawn/Date:	RLF - 10/07/2024
Rec. Drg. No.:	AQ\AQ05\FP\02

Record Drawing

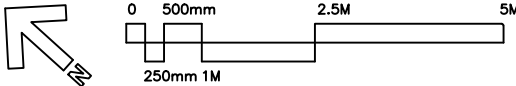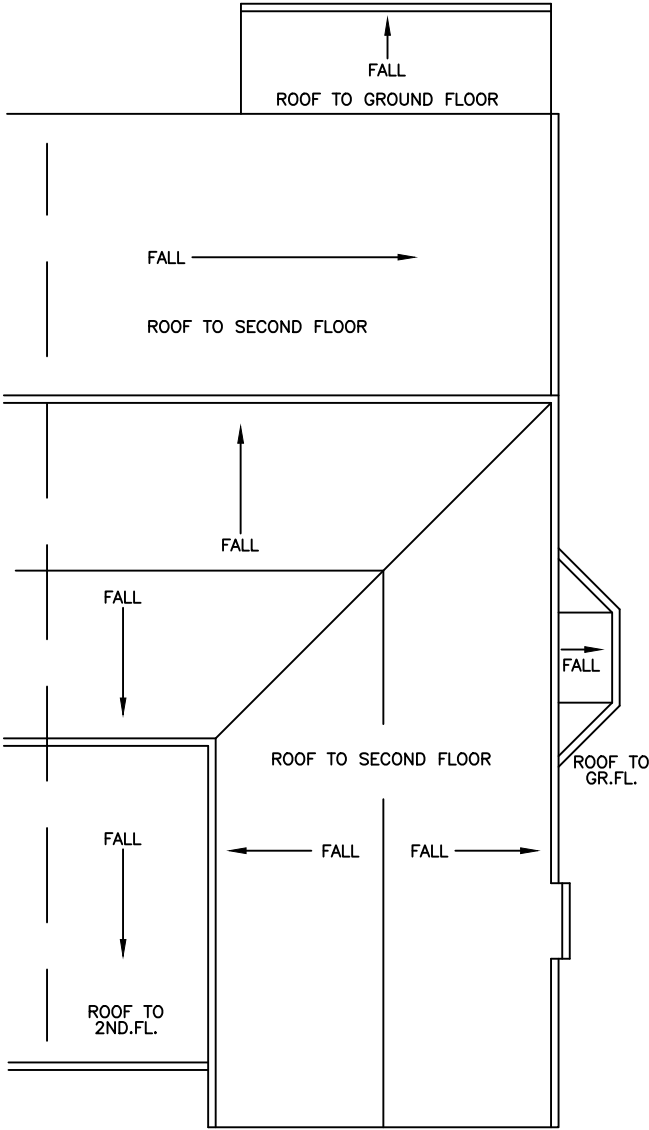

Estates

Title
No. 2 NORTH ROAD.
ROOF PLAN.

Scale: 1:100\A3 SHEET	Original Layout Drawn: GPI
Last Revised Drawn/Date:	RLF - 10/07/2024
Rec. Drg. No.:	AQ\AQ05\FP\03R

Record Drawing