



**BACK PICCADILLY**

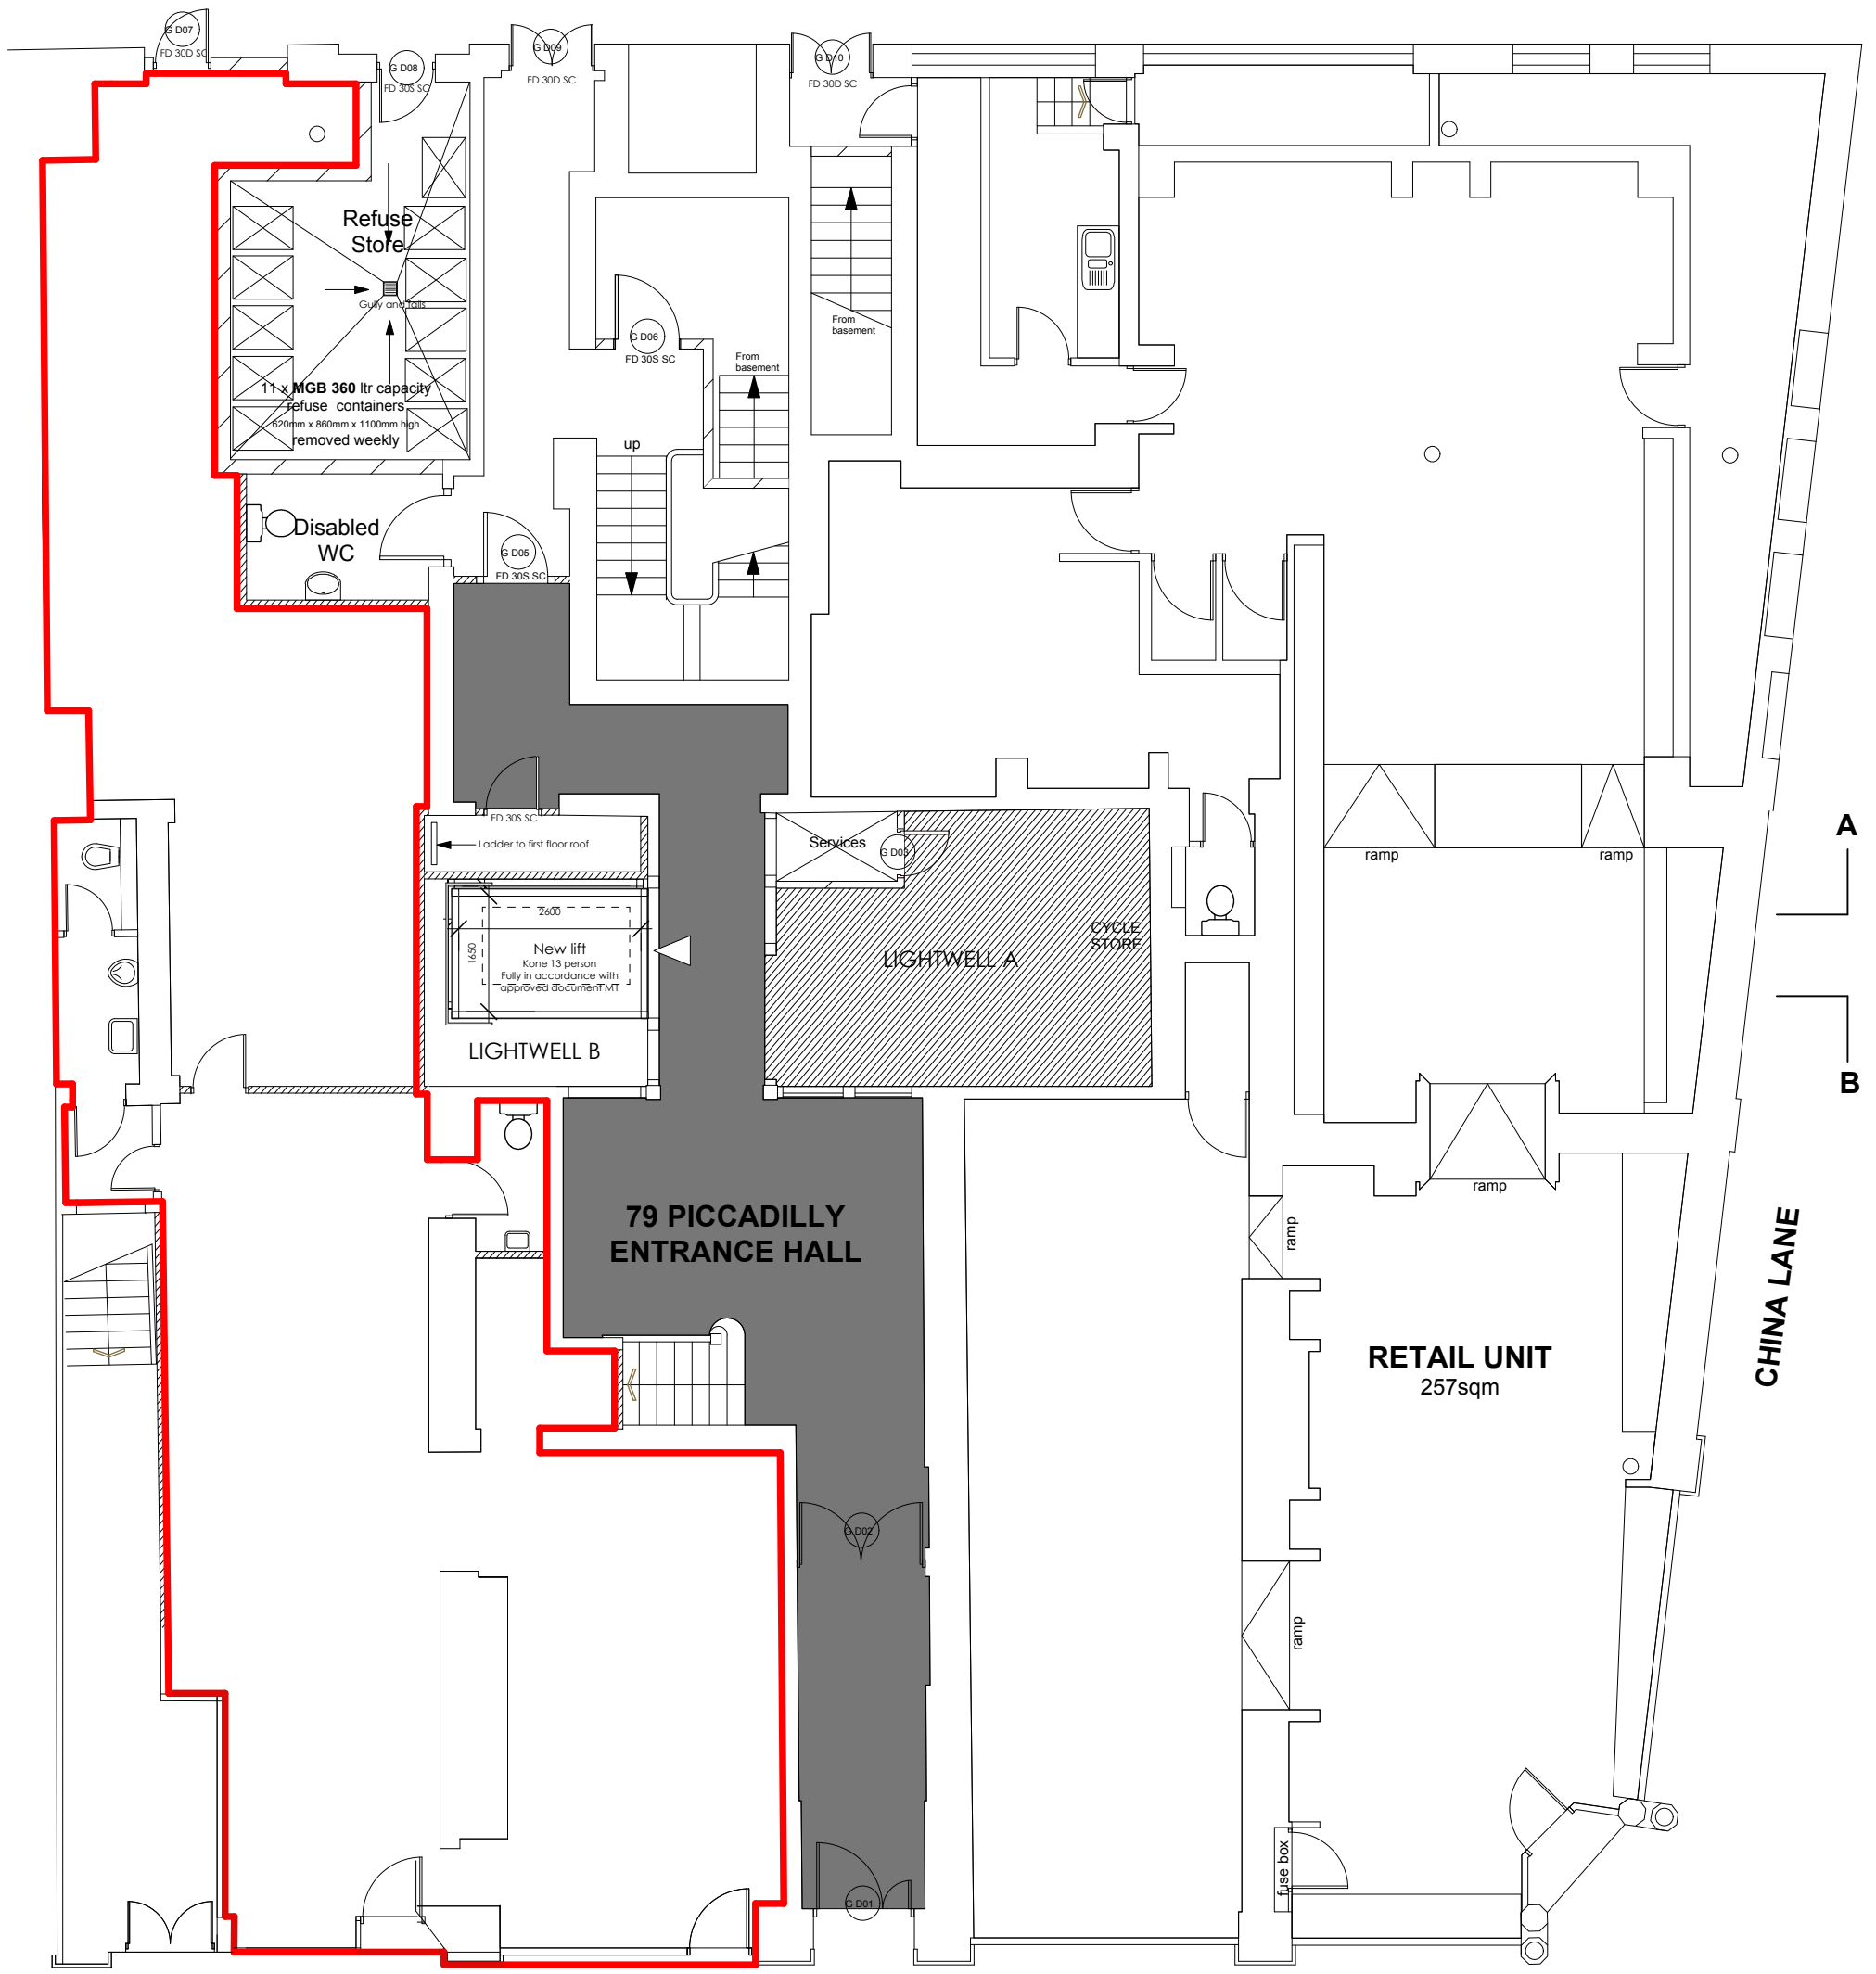

**PICCADILLY**

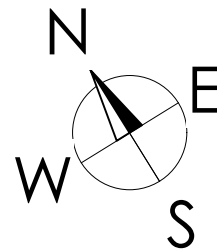

Description: 79 Piccadilly  
 Scale: 1:100@A3  
 Section: Ground Floor Plan  
 Version: 20/3/09  
 Drawn: NC  
 Location: K:\CAD\Piccadilly\As Built\883-AB(100)D ground 77-79.vwx

Red line removed	06-03-09	D
Areas revised following client comments	04-03-09	C
Drawing revised following	03-03-09	B
Disabled WC door handed	31-10-08	A
description	date	rev

PICCADILLY ESTATE for Eastern Green Ltd	scheme 883
<b>77-83 PICCADILLY</b> Ground Floor Plan Resurvey	no. <b>AB(100)</b>
	rev D
	scale 1:100@A3, 1:50 @ A1
	date 29-09-08
	drawn PTM