



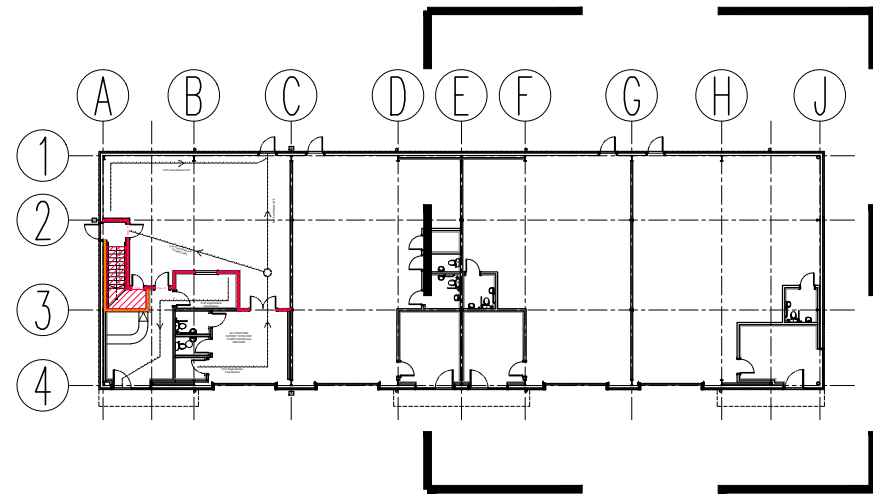

KEY PLAN
1:500

PART GROUND
FLOOR PLAN
1:50

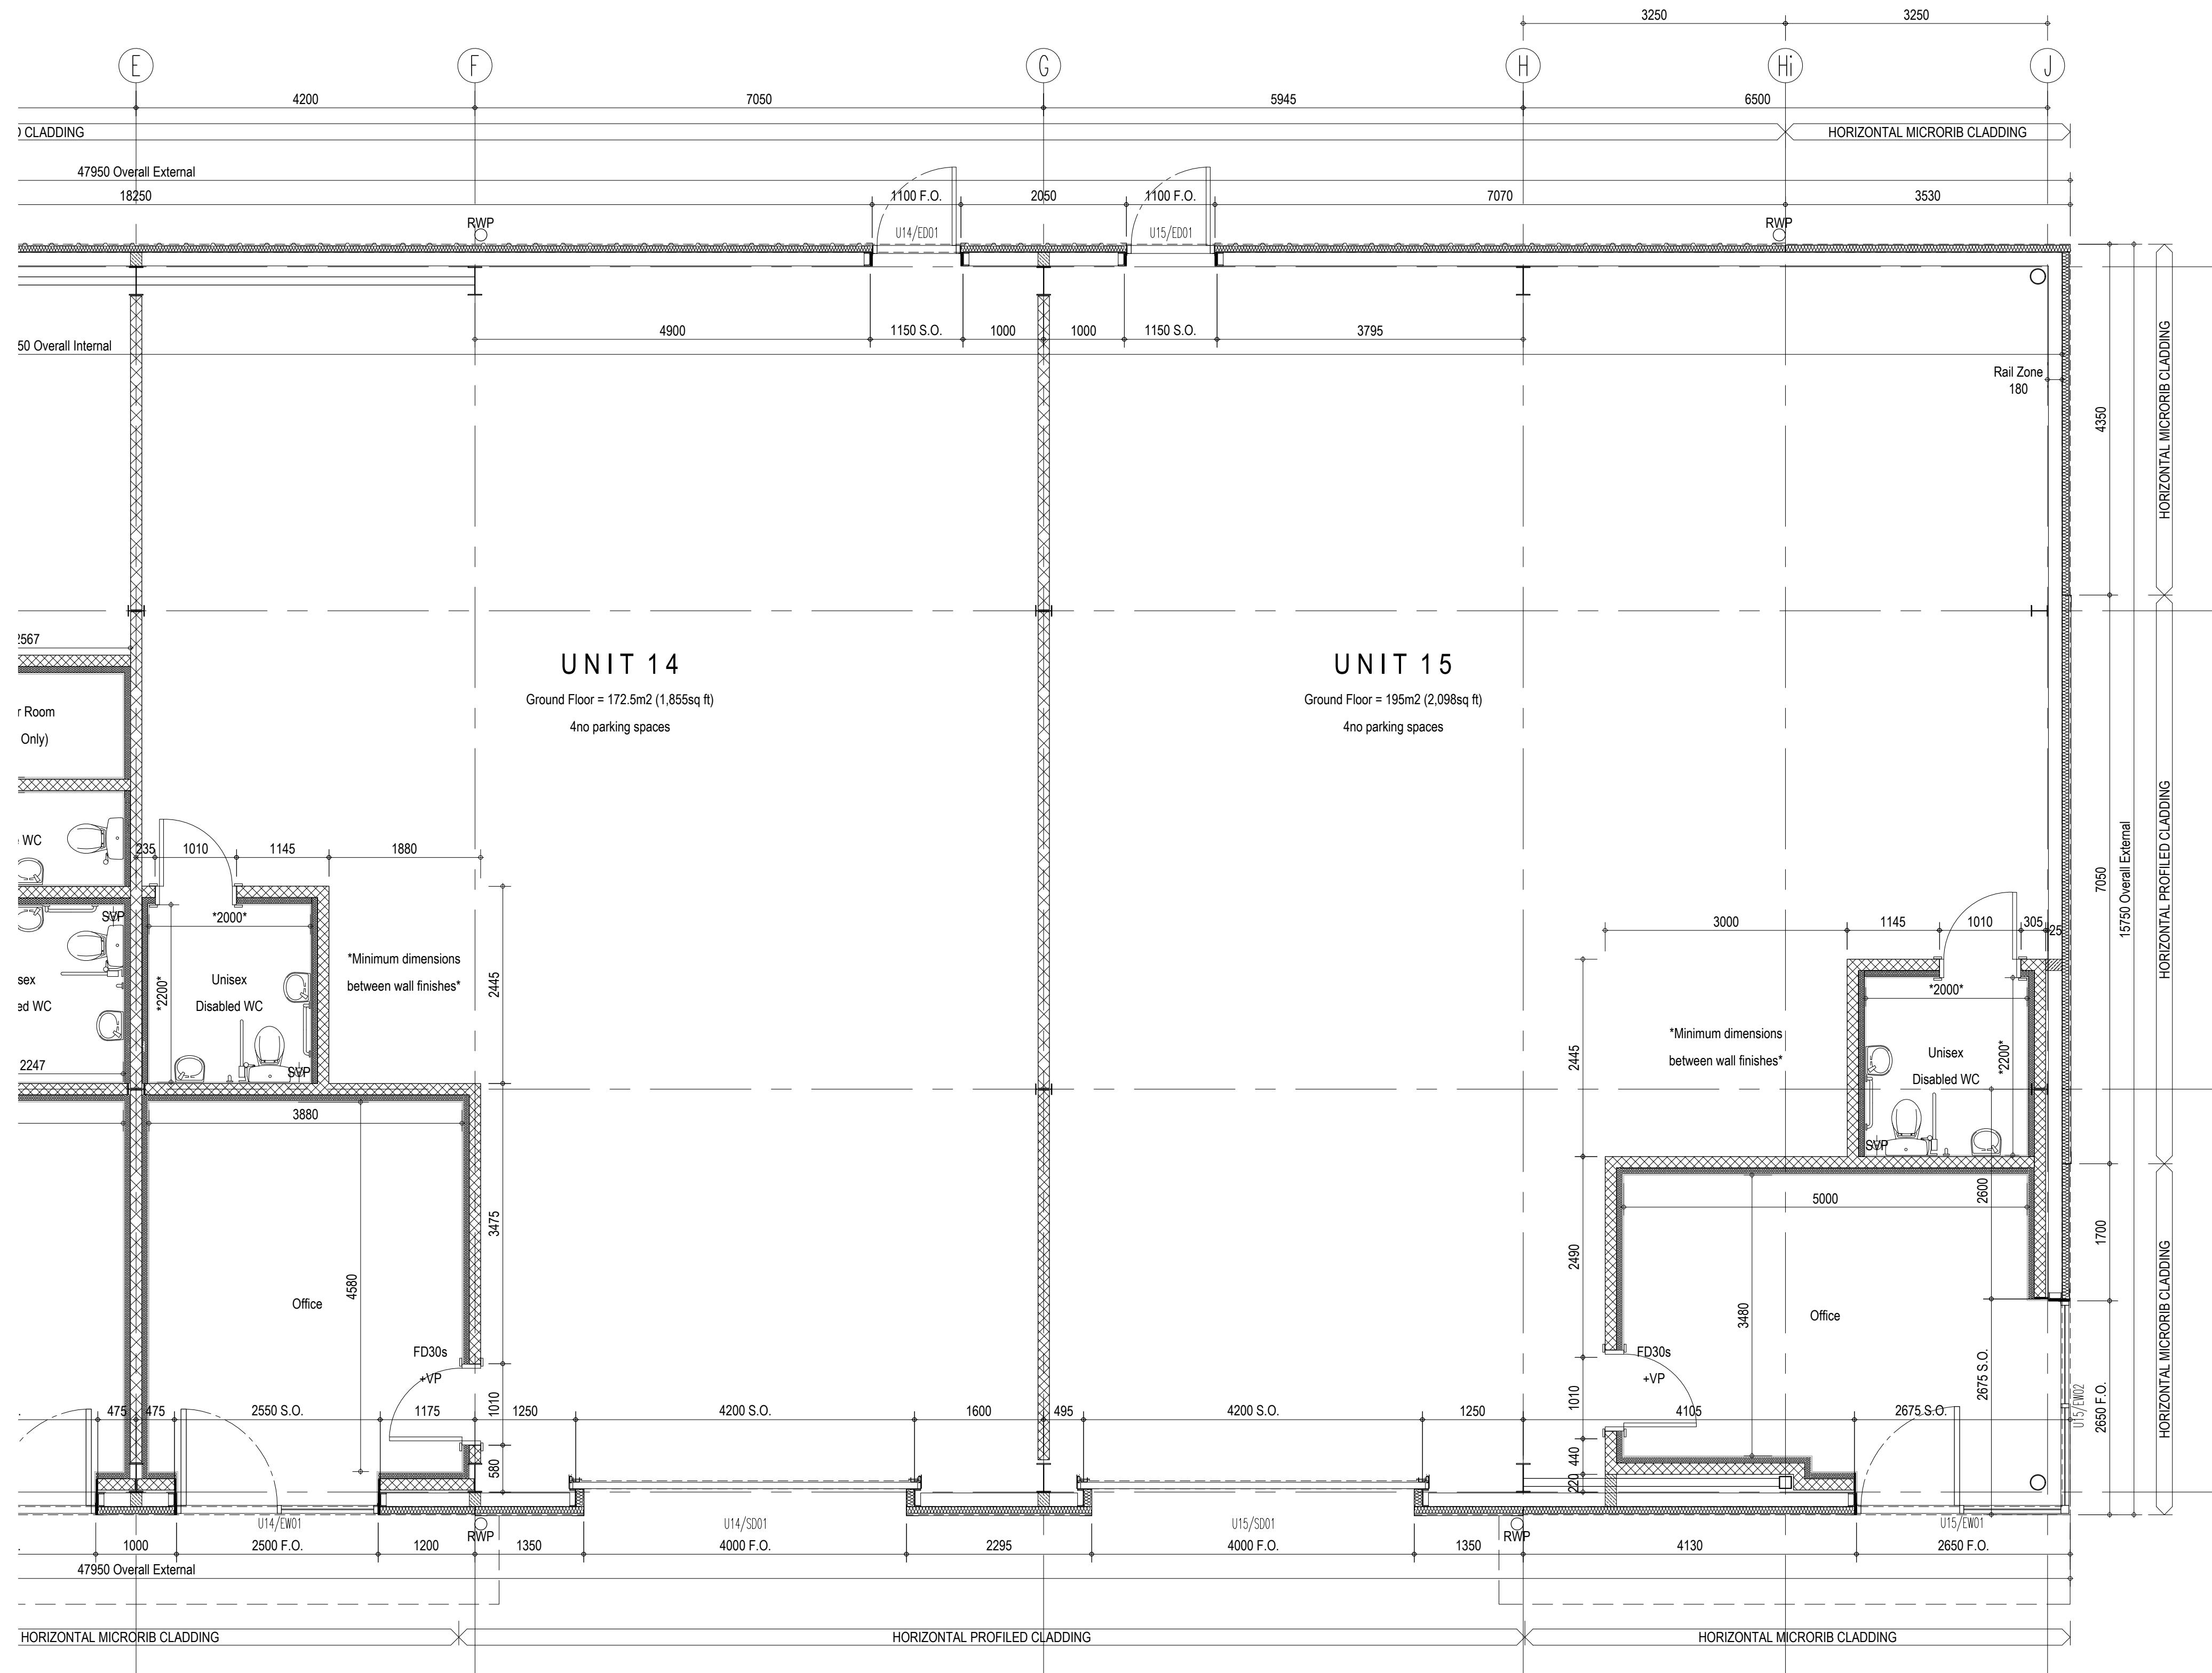

This drawing is copyright of DT Architects. Do not scale from this drawing. Check all dimensions onsite. The contractor shall bring any discrepancies immediately to the notice of the Architect.

AB	as built	06.01.2022
C02	unit 12 updated	06.01.2022
C01	construction issue	01.04.2021
P01	preliminary issue for comment	11.01.2021

revision	note	date
----------	------	------

client

Barnack Estates

project title

Eagle Park Phase II - Plot M & N
Crusader Court

drawing title

Unit 11-15
Part Ground Floor Plan (Sheet 02 of 02)

drawing status

As Built

scale	date	
1:50 @ A1	January 2021	
project number	drawing number	revision
2586	AB0222	AB

