
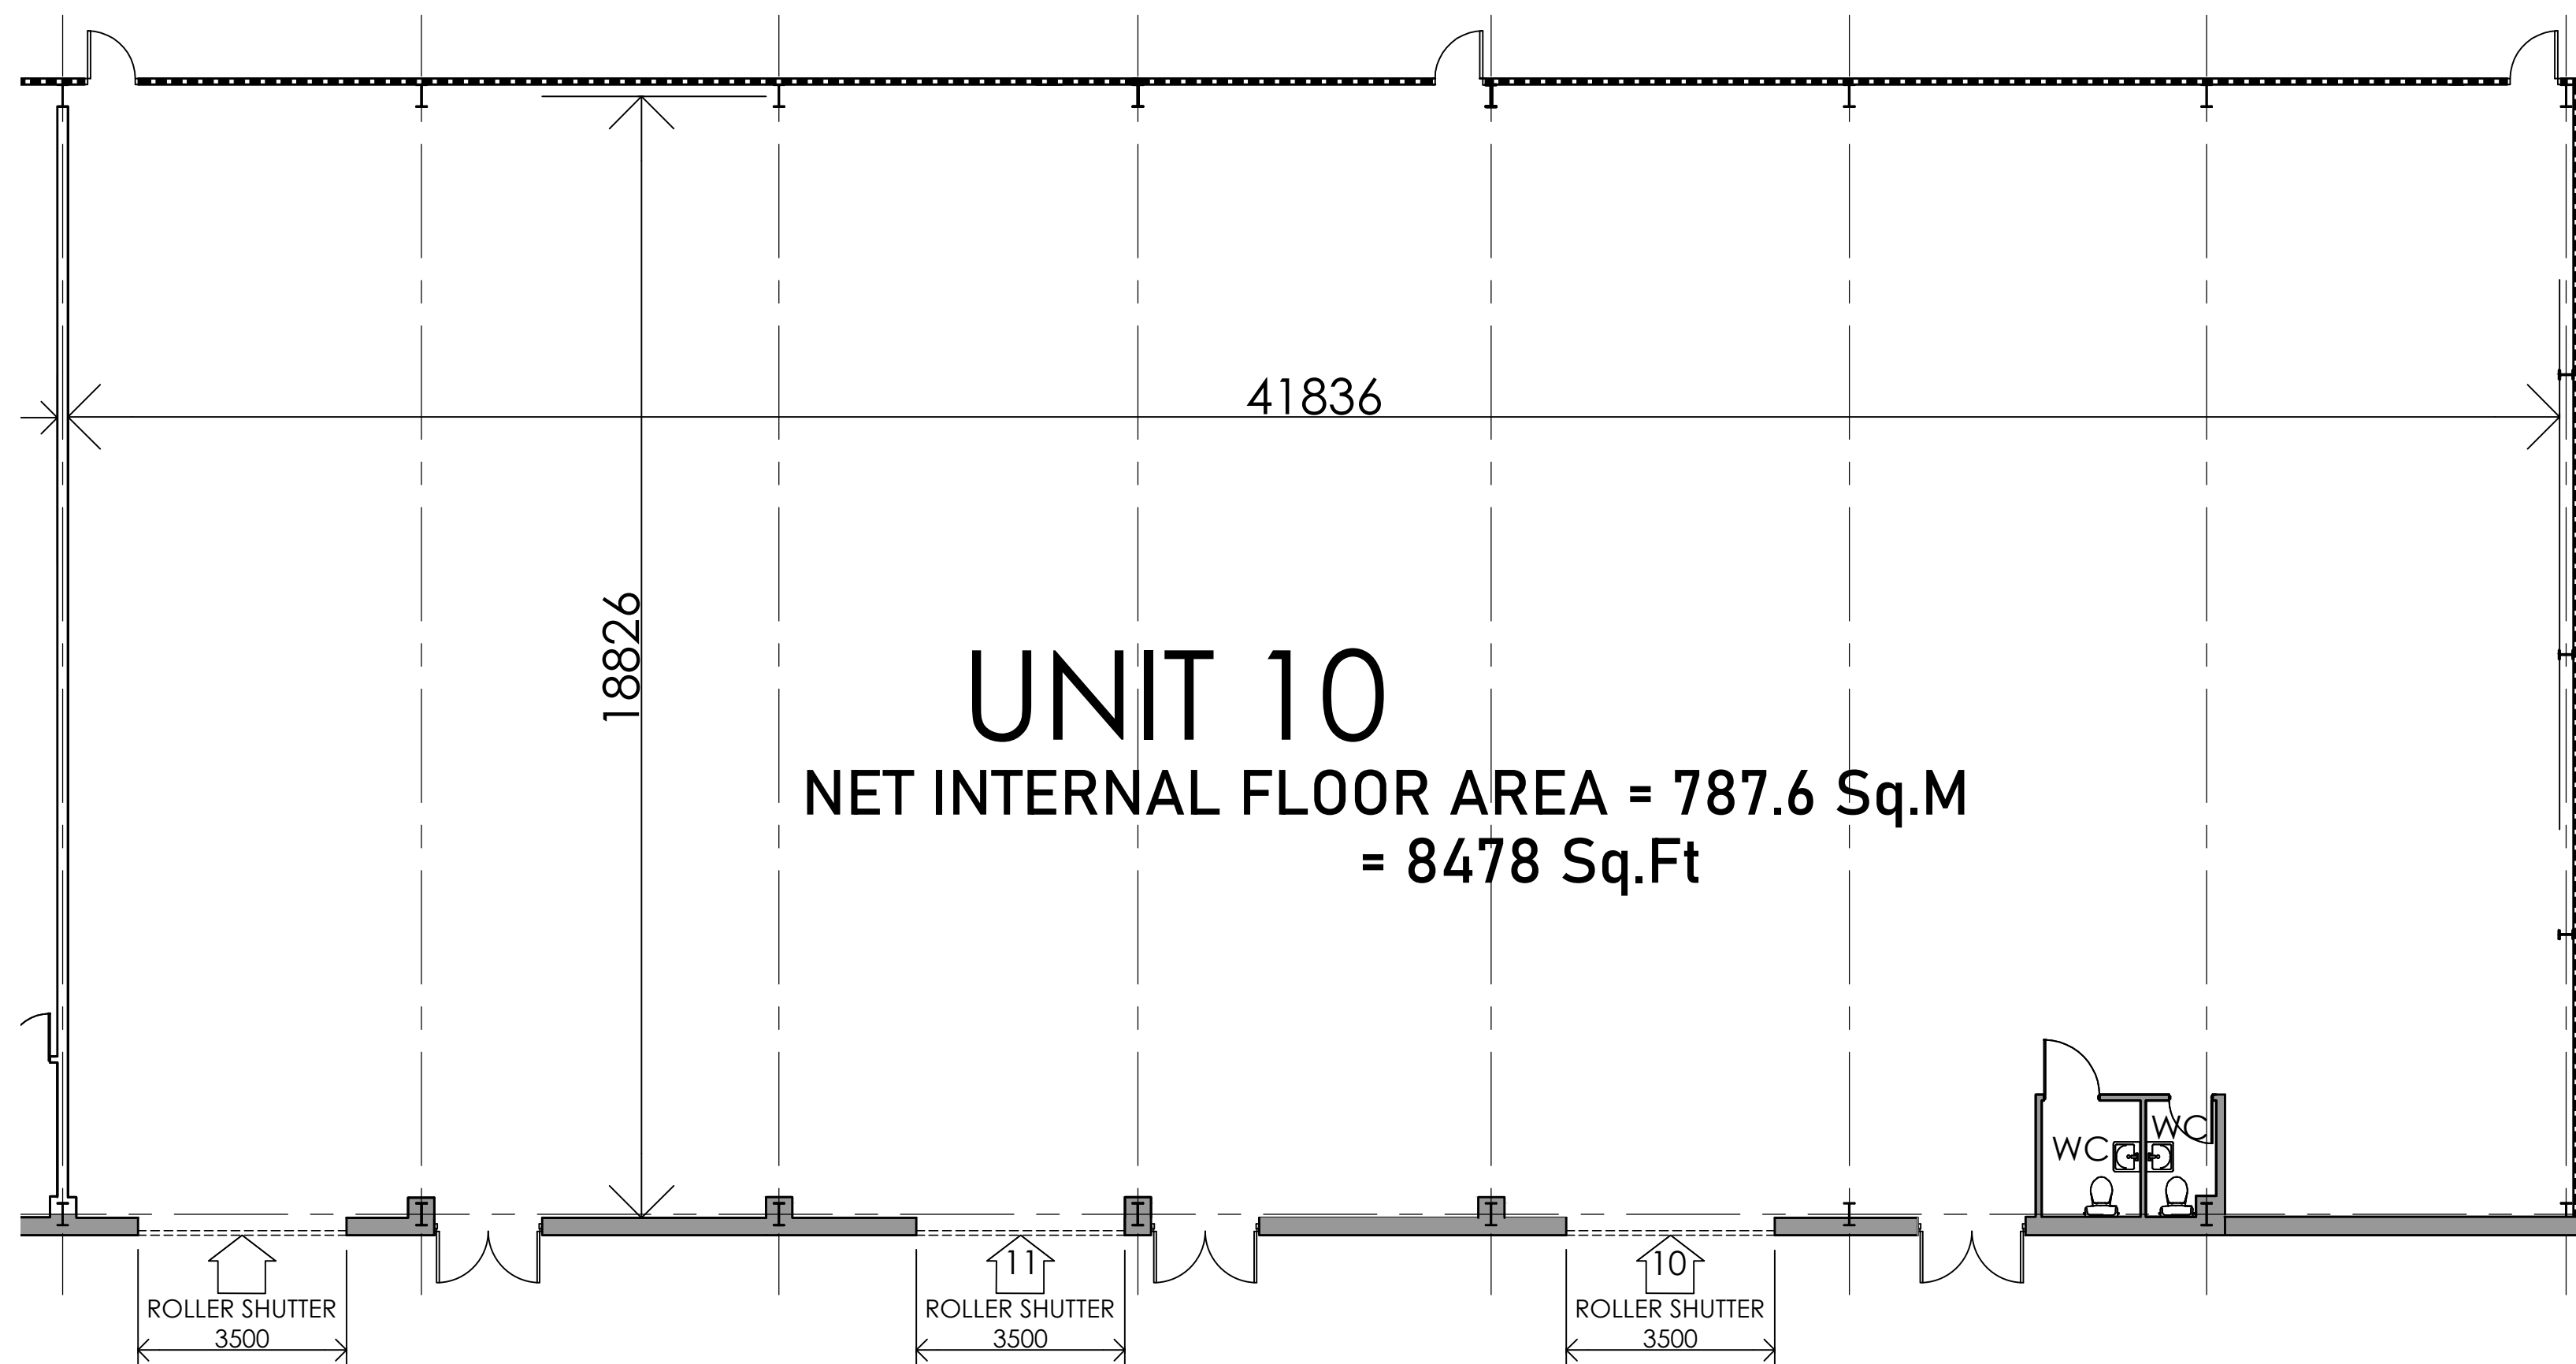
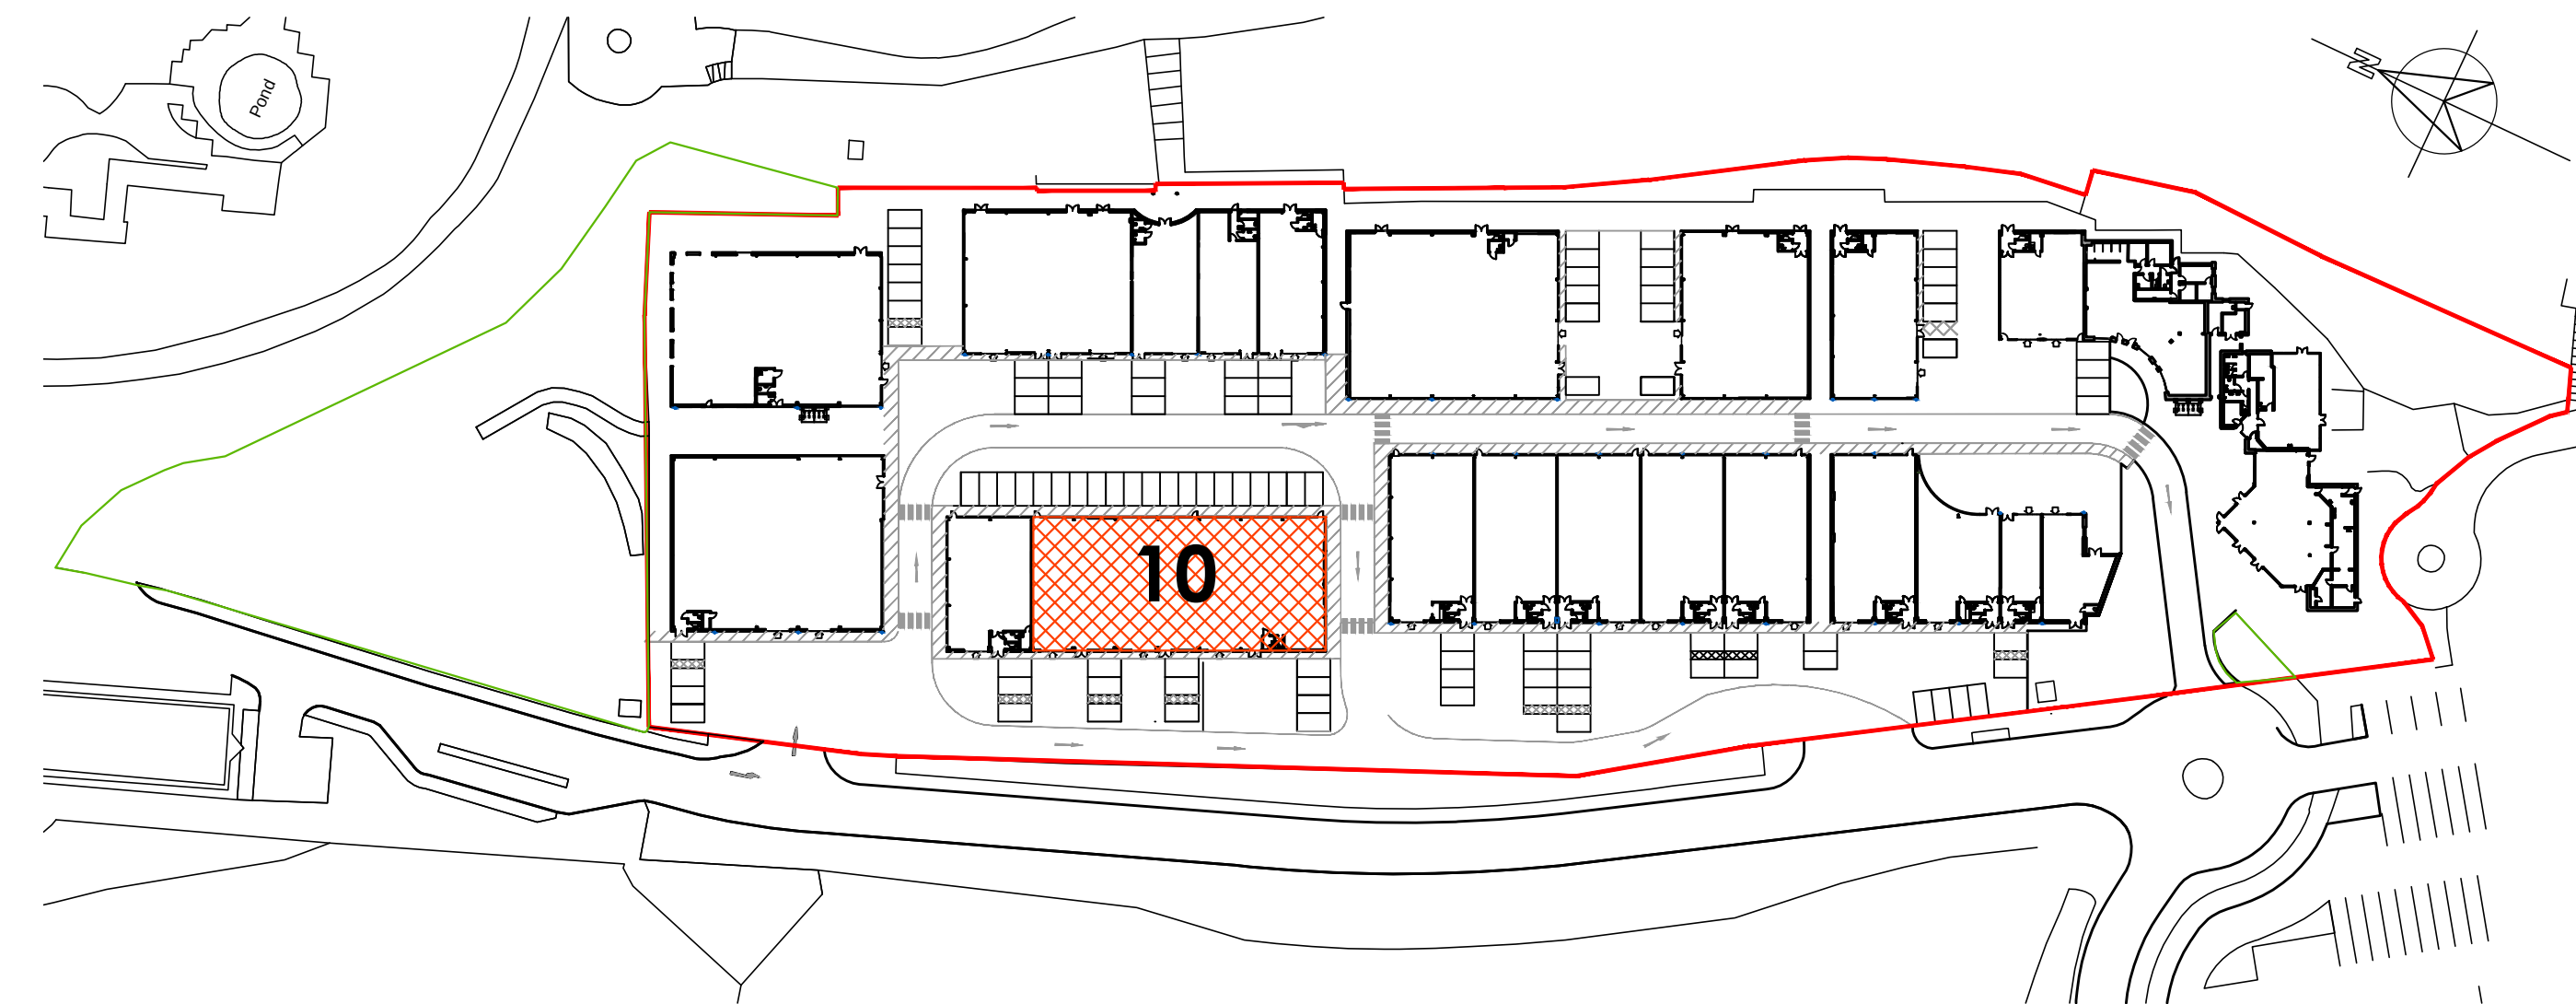
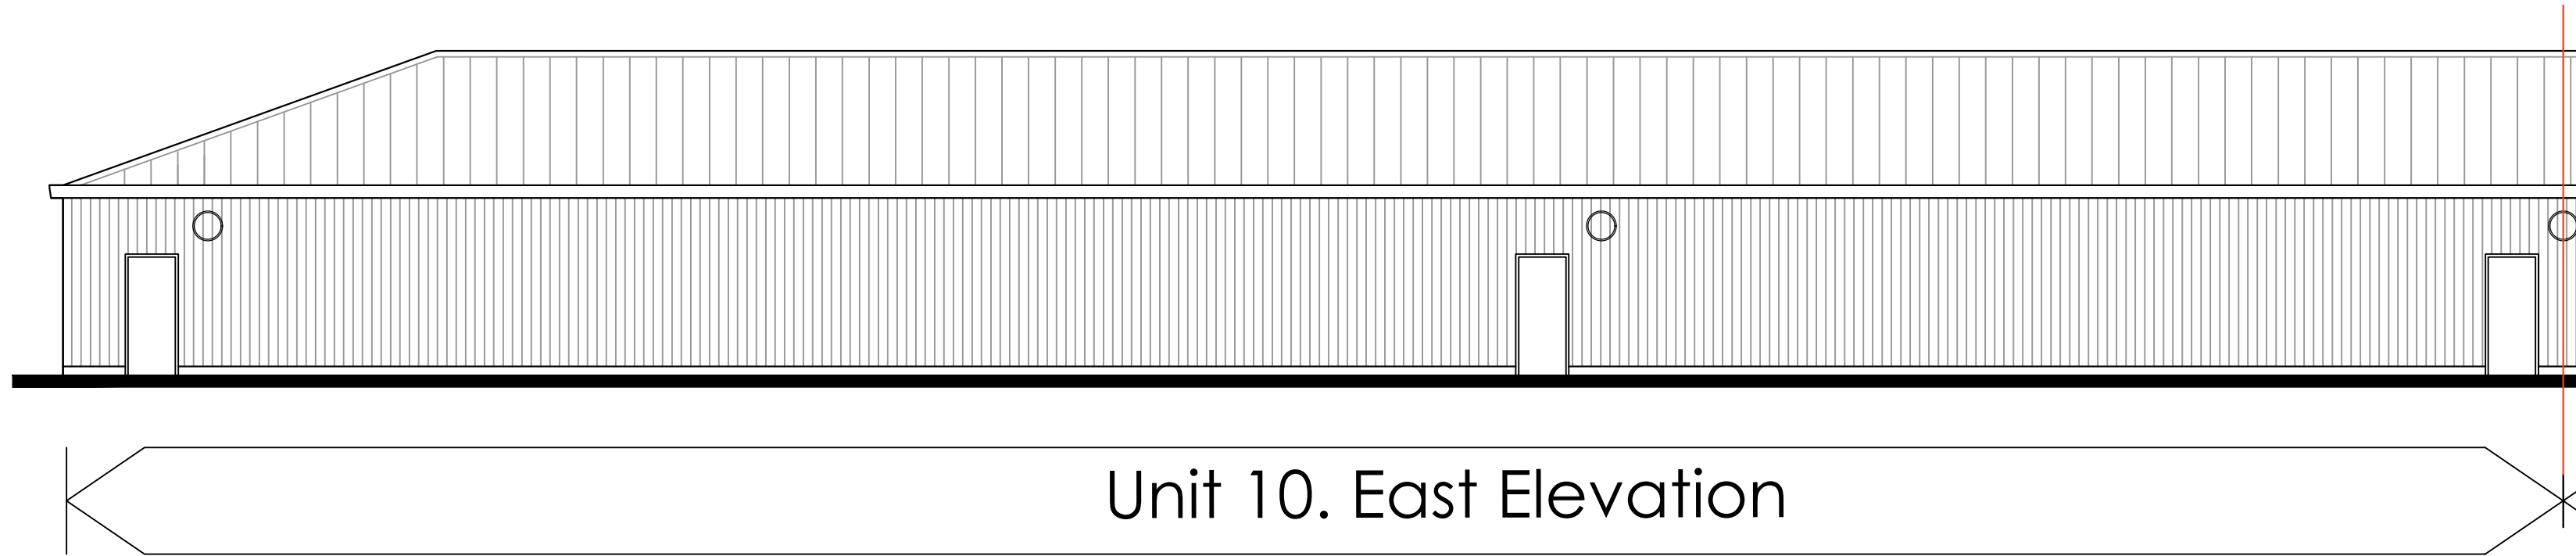
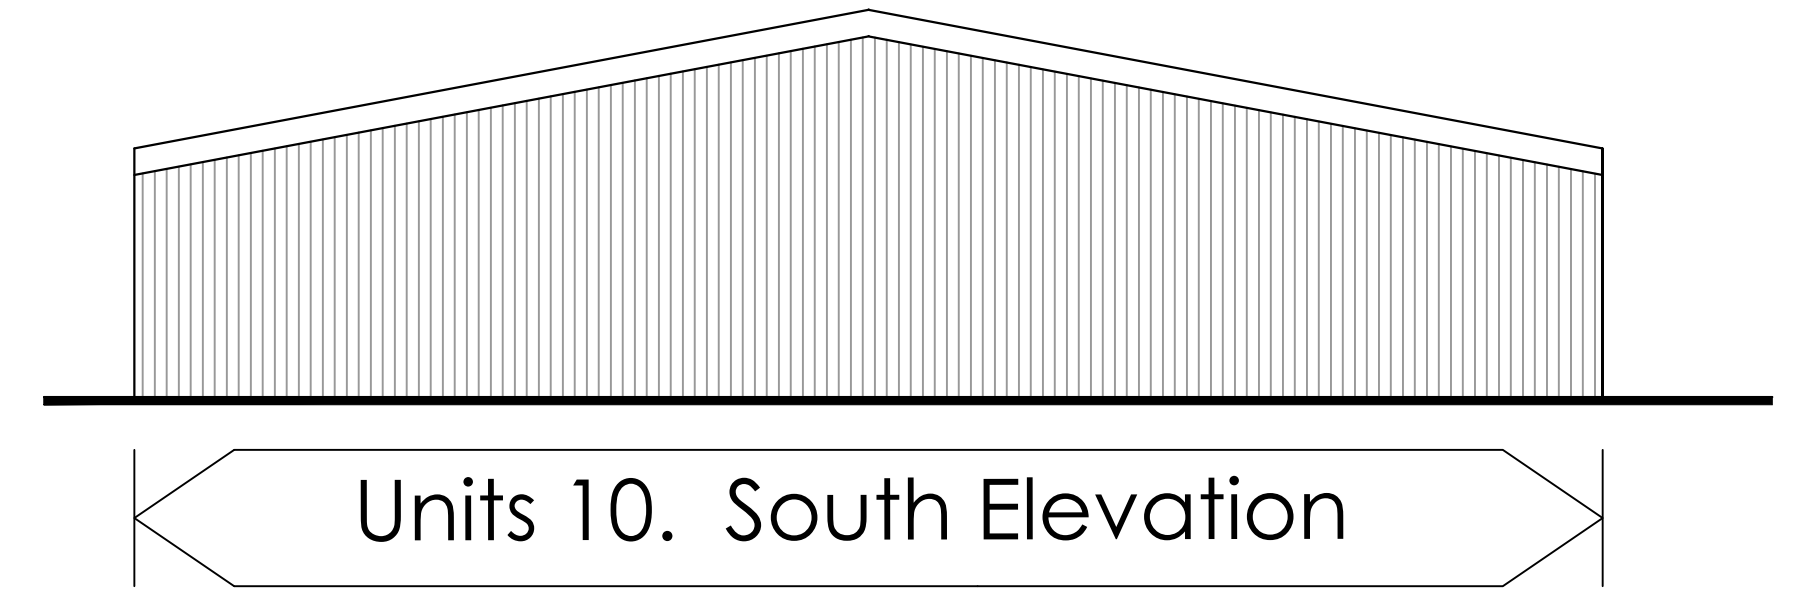


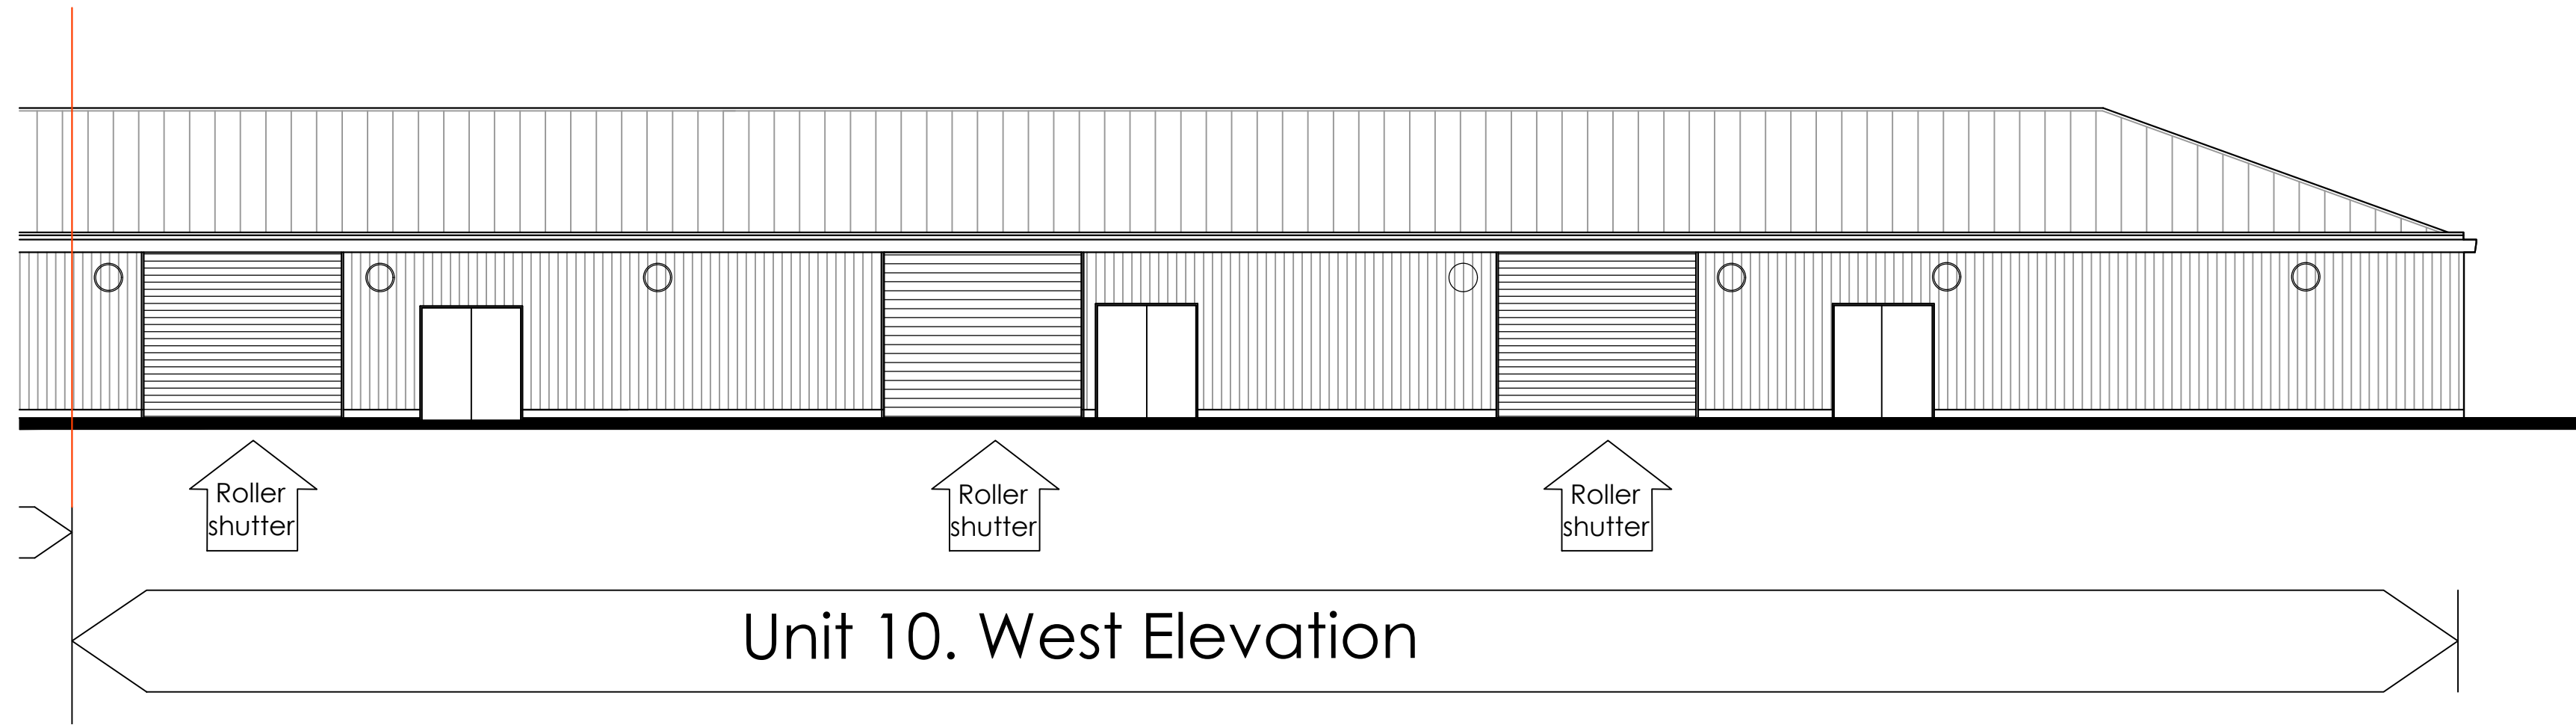

UNIT: **UNIT 10**
NET INTERNAL FLOOR AREA = 787.6 Sq.M
= 8478 Sq.Ft

Creation Design
Creation Design - Wales
Tel: 01495 616277 / 07508890294
www.creationdesign-wales.com
E-mail: info@creationdesign-wales.com

PROPOSED REDEVELOPMENT
FORMER FESTIVAL PARK SITE
QUEEN STREET
VICTORIA, EBBW VALE
NP23 6UN

UNIT 10. PLAN & ELEVATIONS

DATE: June 2024	DRAWN BY: P.P.
SCALE(S): 1:100 @ A1	DRAWING NO: 24-073/AB/10