

Copyright of this drawing belongs to & is vested in **THIRDWAY INTERIORS** and may not be reproduced or without written consent by **THIRDWAY INTERIORS**. Any persons, firm or company unlawfully reproducing or distributing this drawing or in any way infringing the copyright therein will be prosecuted.

This document is the property of **THIRDWAY INTERIORS**. Copyright is reserved by them, and the drawing is issued on the condition that it is not copied, reproduced or retained by, nor disclosed to any unauthorised person, either wholly or in part, without the consent in writing from **THIRDWAY INTERIORS**.

Note
ALL DIMENSIONS MUST BE CHECKED ON SITE.
DO NOT SCALE FROM THIS DRAWING.
THIS DRAWING IS FOR DISCUSSION PURPOSES ONLY AND IS SUBJECT TO FIRE OFFICER AND BUILDING REGULATION APPROVALS BEING OBTAINED.

Drawing Approval
Client Signature
Printed Name
ThirdWay Signature
Date
Specification Ref

Status
 Preliminary/Info.
 Contract
 Construction
 Approval/Comment
 As-Built
 Building Control

Revision Detail

Rev	Detail	By	Date
A	INFORMATION	RG	22.05.15
B	INFORMATION	RG	28.04.15
C	INFORMATION	RG	12.05.15
D	UPDATED PACK	RG	22.05.15
E	UPDATED GA	RG	26.05.15

PRELIMINARY DRAWING

Client
WESTBROOK PROPERTIES

Project Title
ALL FLOORS
THE AIRCRAFT FACTORY
100 CAMBRIDGE GROVE
LONDON
W6 0LE


Drawing Title
SECOND FLOOR
GENERAL ARRANGEMENT
WORKING DRAWING

Date: 17.03.15 Drawn By: DJ

Scale: 1:300@A3 Rev: E

Drawing No: TWI-1017-02-GA

ThirdWay
ThirdWay Interiors Ltd
2nd Floor 3-5 Bleeding Heart Yard
London EC1N 8SJ

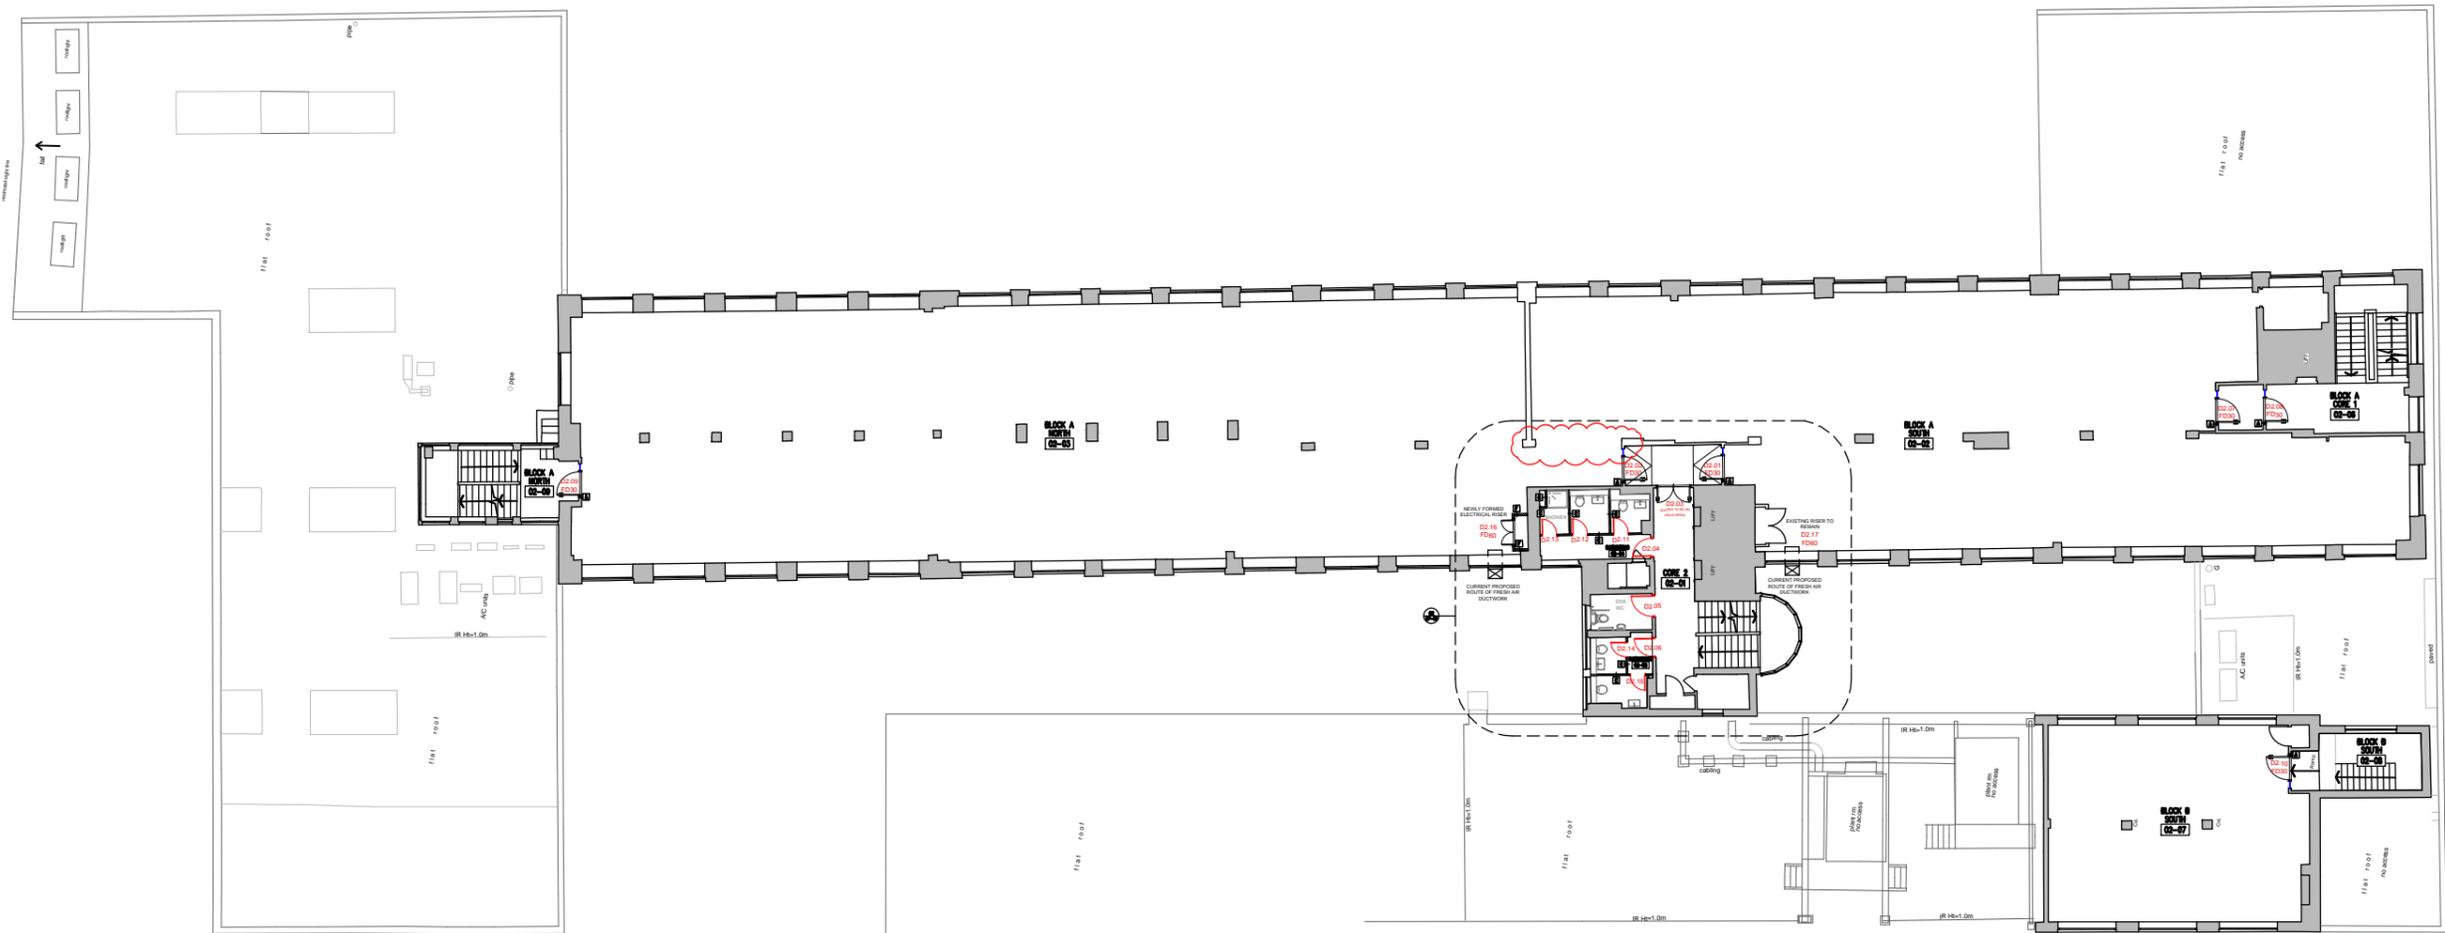

SECOND FLOOR



SITE WORKS		PARTITIONS		GLAZING		DOORS		CORES	
1/2H FIRE	- HALF HOUR FIRE RATED PARTITION		- EXISTING CORE WALL masonry wall		- 100mm NEW STUD PARTITION fit to u/s of susp.ceiling		- HALF GLAZED PARTITION fit to u/s of susp.ceiling		- EXISTING SOLID CORE
1H FIRE	- ONE HOUR FIRE RATED PARTITION		- EXISTING PARTITION		- 100mm NEW STUD PARTITION fit to soffit ceiling		- DOUBLE GLAZED PARTITION fit to u/s of susp.ceiling		- NEW SOLID DOOR
			- 75mm NEW STUD PARTITION fit to u/s of susp.ceiling		- 100mm NEW STUD PARTITION (1250mm high) fixed with standard capping		- SILICON JOINTED GLAZING fit to u/s of susp.ceiling		- NEW GLASS DOOR
					- DOUBLE GLAZED PARTITION fit to u/s of susp.ceiling		DO1 - DOOR NUMBER		- NEW GLASS DOOR WITH FRAME
					- SINGLE GLAZED PARTITION fit to u/s of susp.ceiling		SC - SELF CLOSER ON DOOR		FD20S - 20 MIN SMOKE DOOR
					VP - VISION PANEL IN DOOR		FD30S - ONE HOUR FIRE RATED DOOR WITH SMOKE SEAL		FD60S - ONE HOUR FIRE RATED DOOR WITH SMOKE SEAL