
## GROSVENOR PLACE (BELOW)

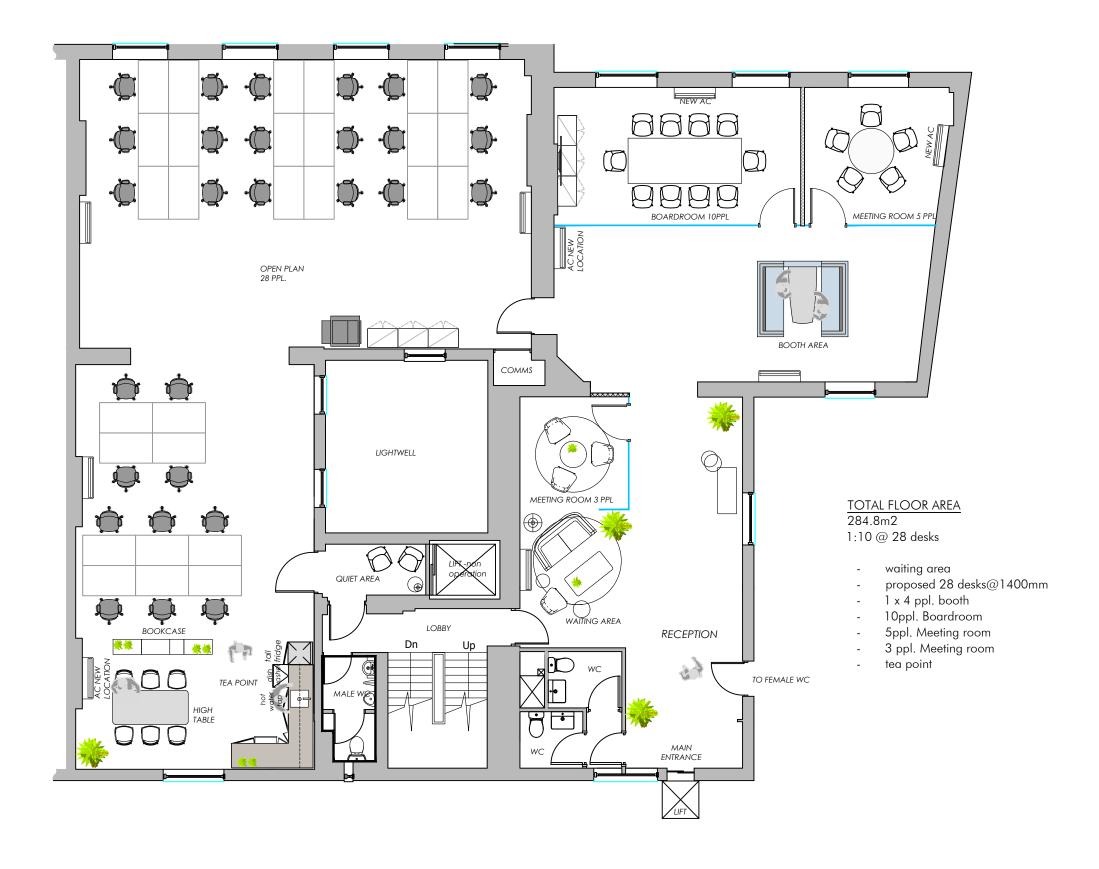

## AS BUILT

Н	07.08.19	AS BUILT	AR	SG
G	06.06.19	RECEPTION COFFEE TABLE AMENDED	AC	AC
F	03.05.19	DESKS SHIFT CLOSER TO THE WINDOW	AC	AC
Е	01.05.19	DESK NUMBERS REVISED	AC	AC
D	29.04.19	REMOVED PENDANT LIGHTS AT RECEPTION	AC	AC
С	25.04.19	RELOCATED RECEPTION DESK AND ACS	AC	AC
В	date 24.04.19	RELOCATED COMMS ROOM, REVISED TEA POINT LAYOUT ADDED AC & CEILING PROJECTION	AC	AC

## ORCHARD

Orchard House, Threshelfords Business Park, Inworth Road, Essex, COS 95E T: 020 7061 9866 | F: 020 7061 9877 E: Info@orchardgroup.org.uk | W: www.orchardgroup.org.uk

19-20 GROSVENOR PLACE

PROPOSED GENERAL ARRANGEMENT PLAN NOT SHOWING RECEPTION DESK

issued for			drawing no			
COMMENTS			OG19-014-GA			
	job no OG19-014		1:100@A3	drawn JG	checked PB	