
This drawing is the property of BEH Interiors Limited and may not be reproduced or otherwise without prior consent.

All dimensions must be checked on site before any works are undertaken.

DO NOT SCALE THIS DRAWING

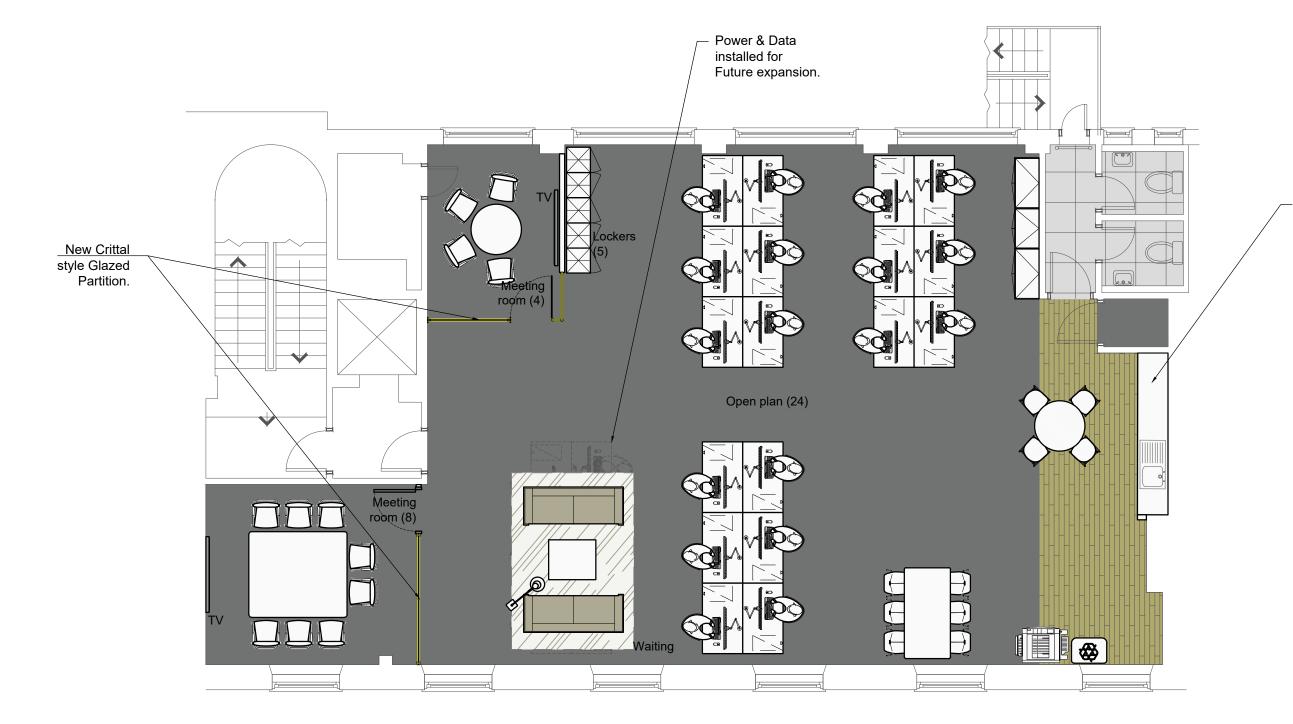

General arrangement

1: 75

No change to Existing Tea point.

30.11.22 Furniture layout revised 23.11.22 Partition Revised RH 27.10.22 First issue Rev. Date. Description Drawn Revisions:



BEH Interiors Limited Unit 2, The Piano Works 117 Farringdon Road London, EC1R 3BX

Tel: +44 (0) 20 3781 7472

Email: info@behinteriors.co.uk

Project Title:

34 Threadneedle Street London General arrangement Level 2

Drawing Title:

General Arrangement AS BUILT

Drawn By:	Date: 30.11.22 Checked By:	
RH		
Scale:		
1: 75 (A3)	RH	
Job No Dwg type	Level	Revision
1/81 GA		۸ ۵