




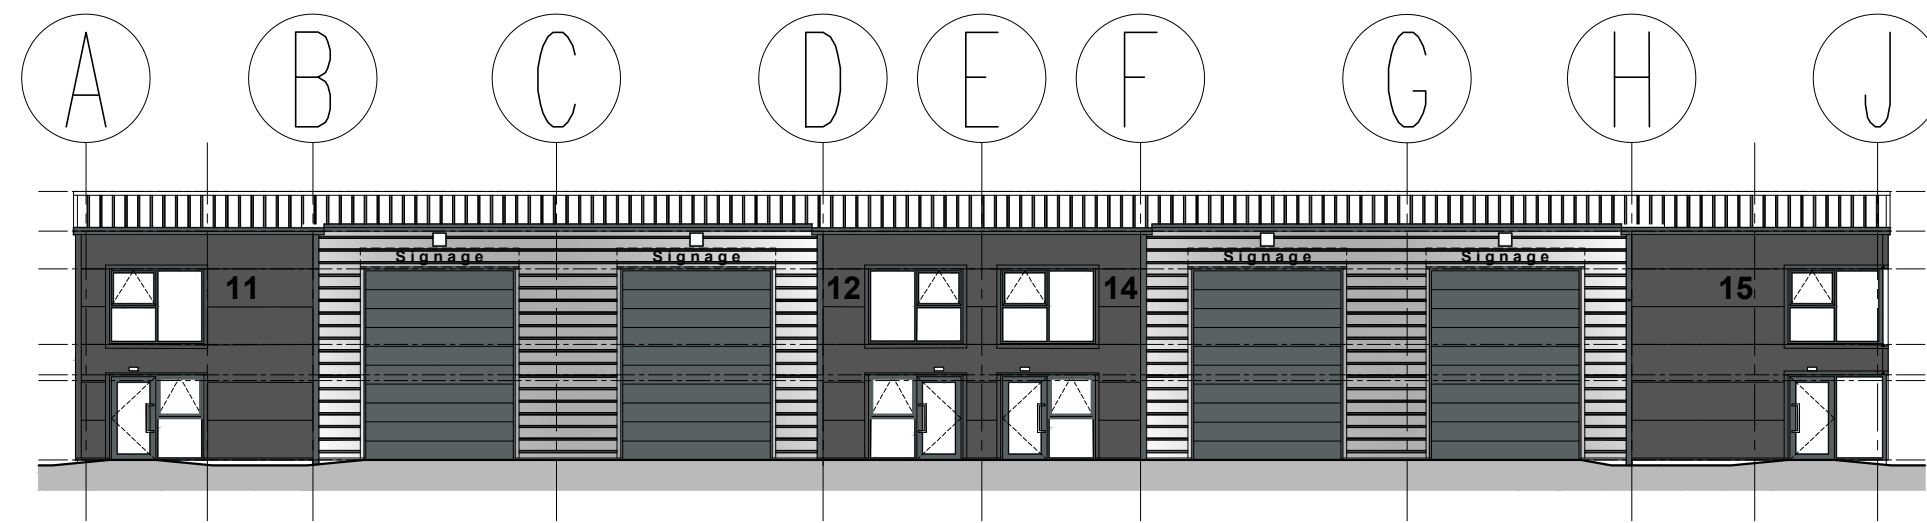

OVERALL SOUTH WEST ELEVATION
1:200

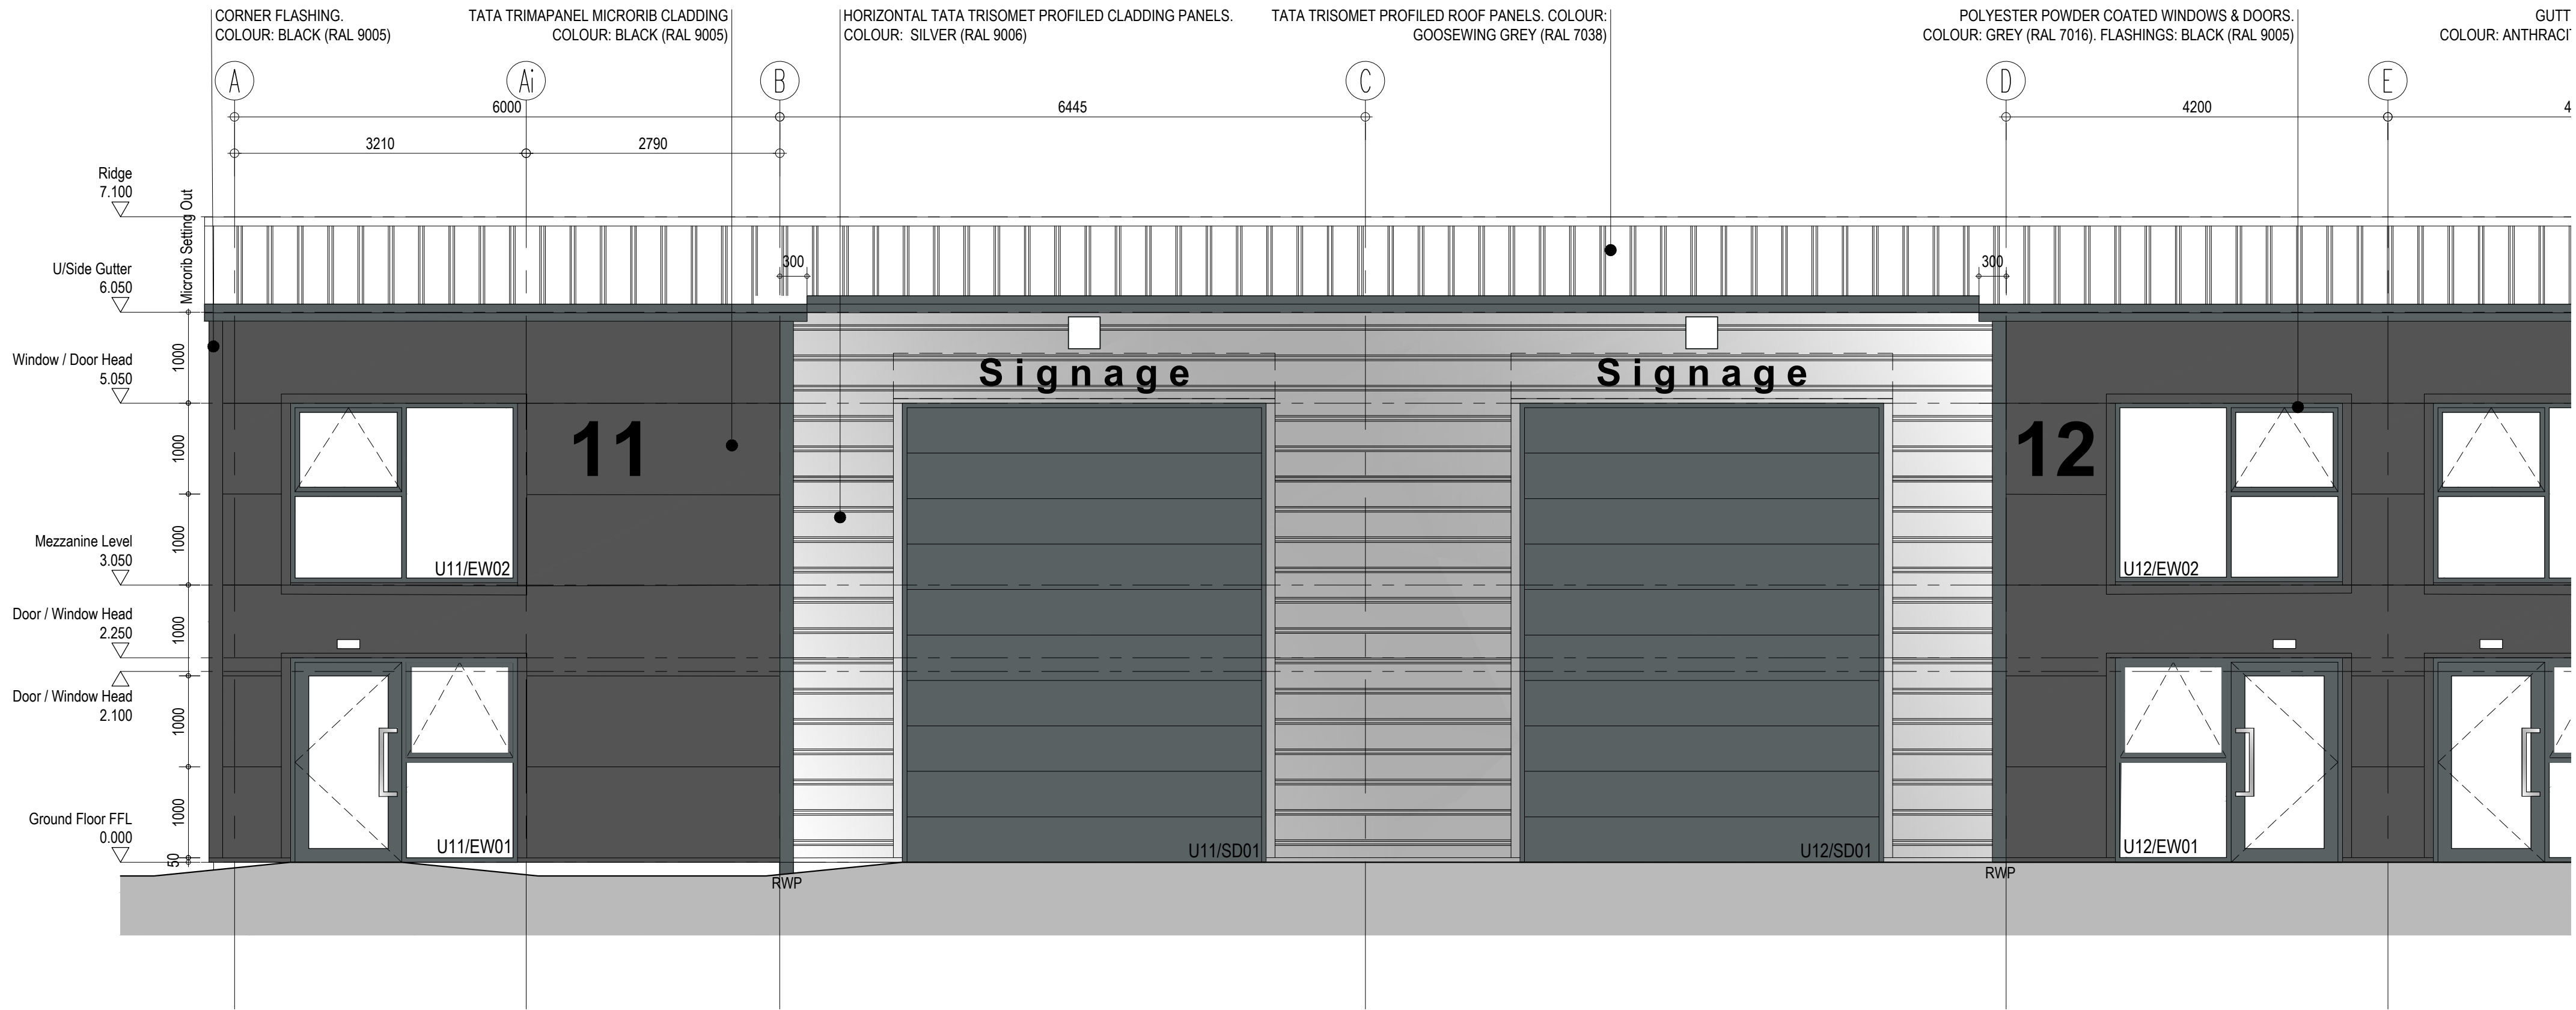

PART SOUTH WEST ELEVATION
1:50

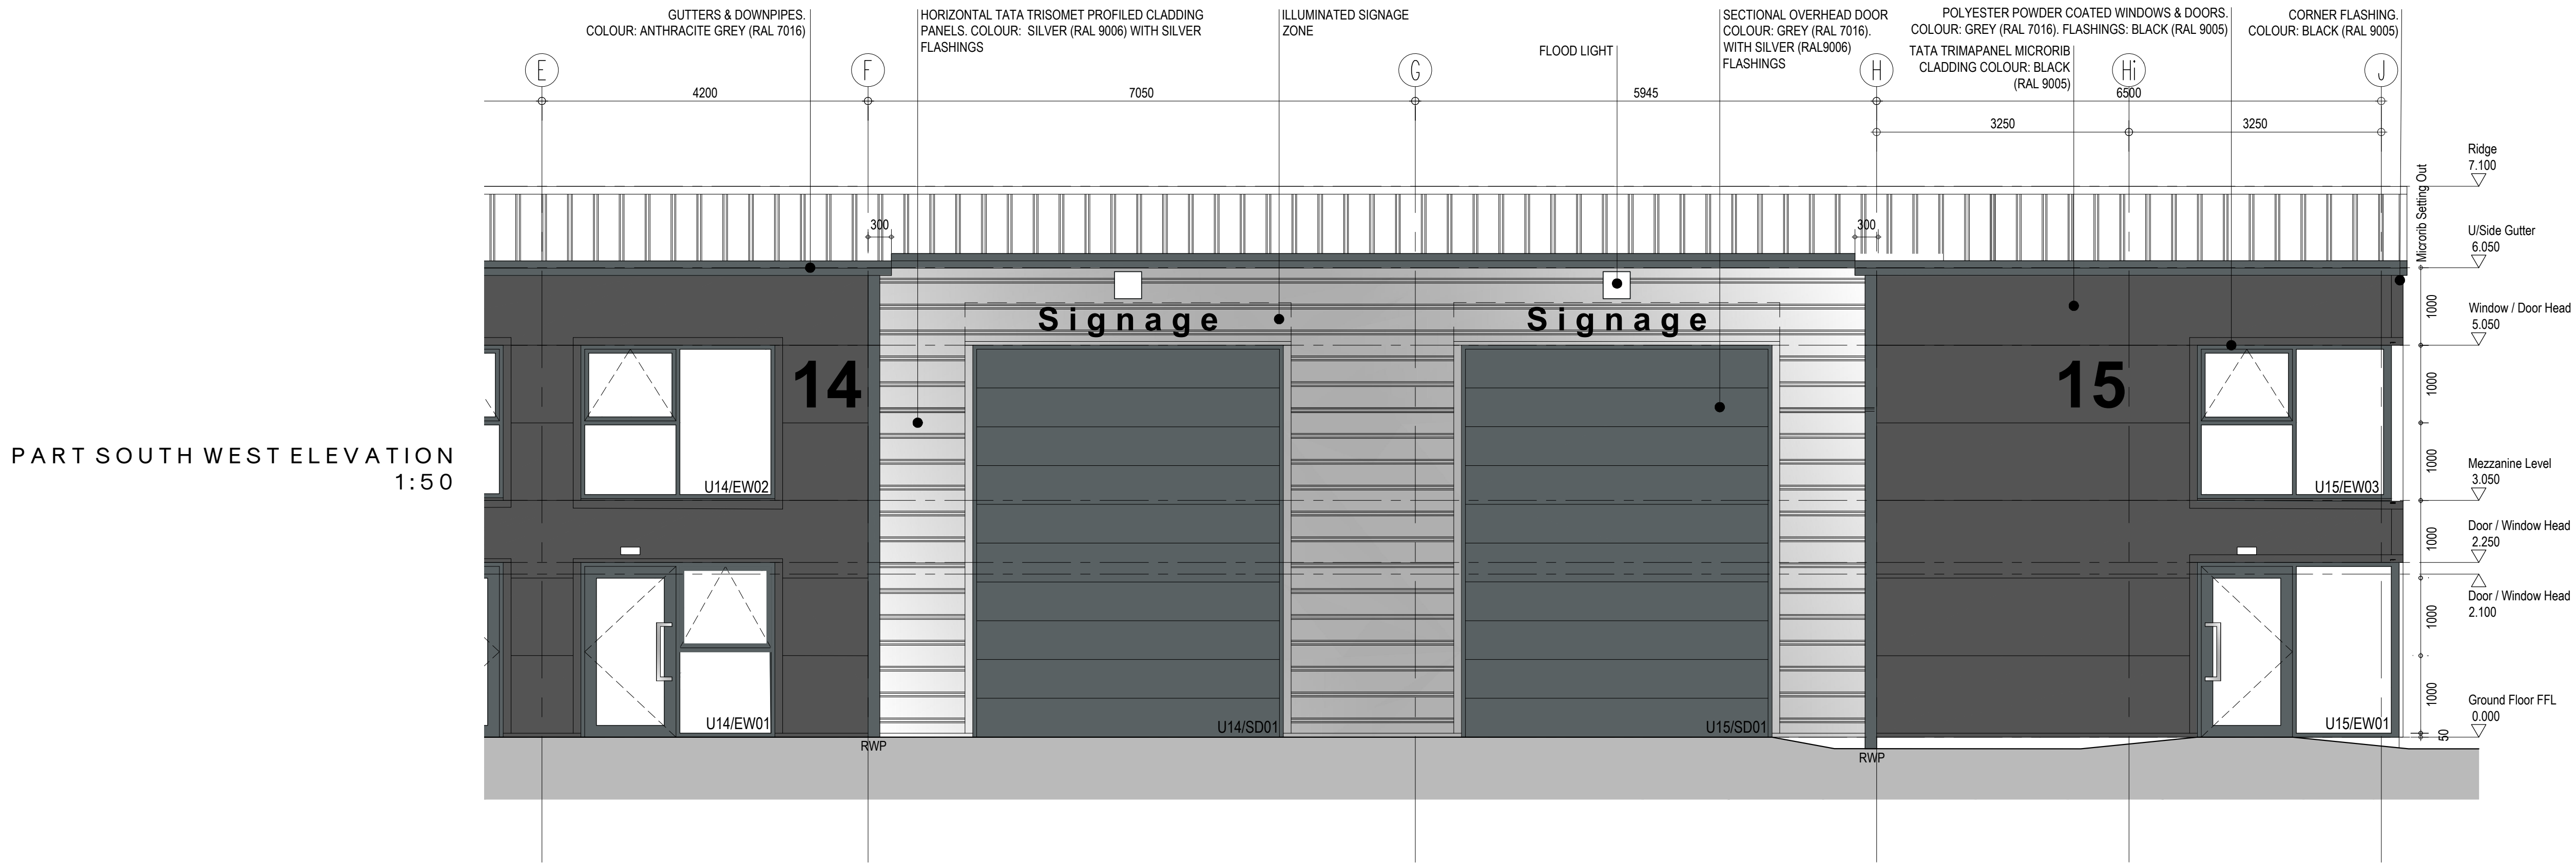

PART SOUTH WEST ELEVATION
1:50

AB	as built	06.01.2022
C01	construction issue	01.04.2021
P01	preliminary issue for comment	11.01.2021

revision	note	date
----------	------	------

client

Barnack Estates

project title

Eagle Park Phase II - Plot M & N
Crusader Court

drawing title

Unit 11-15
Elevations (Sheet 01 of 03)

drawing status

As Built

scale	date
-------	------

1:50 @ A1	January 2021
-----------	--------------

project number	drawing number	revision
----------------	----------------	----------

2586	AB0821	AB
------	--------	----