


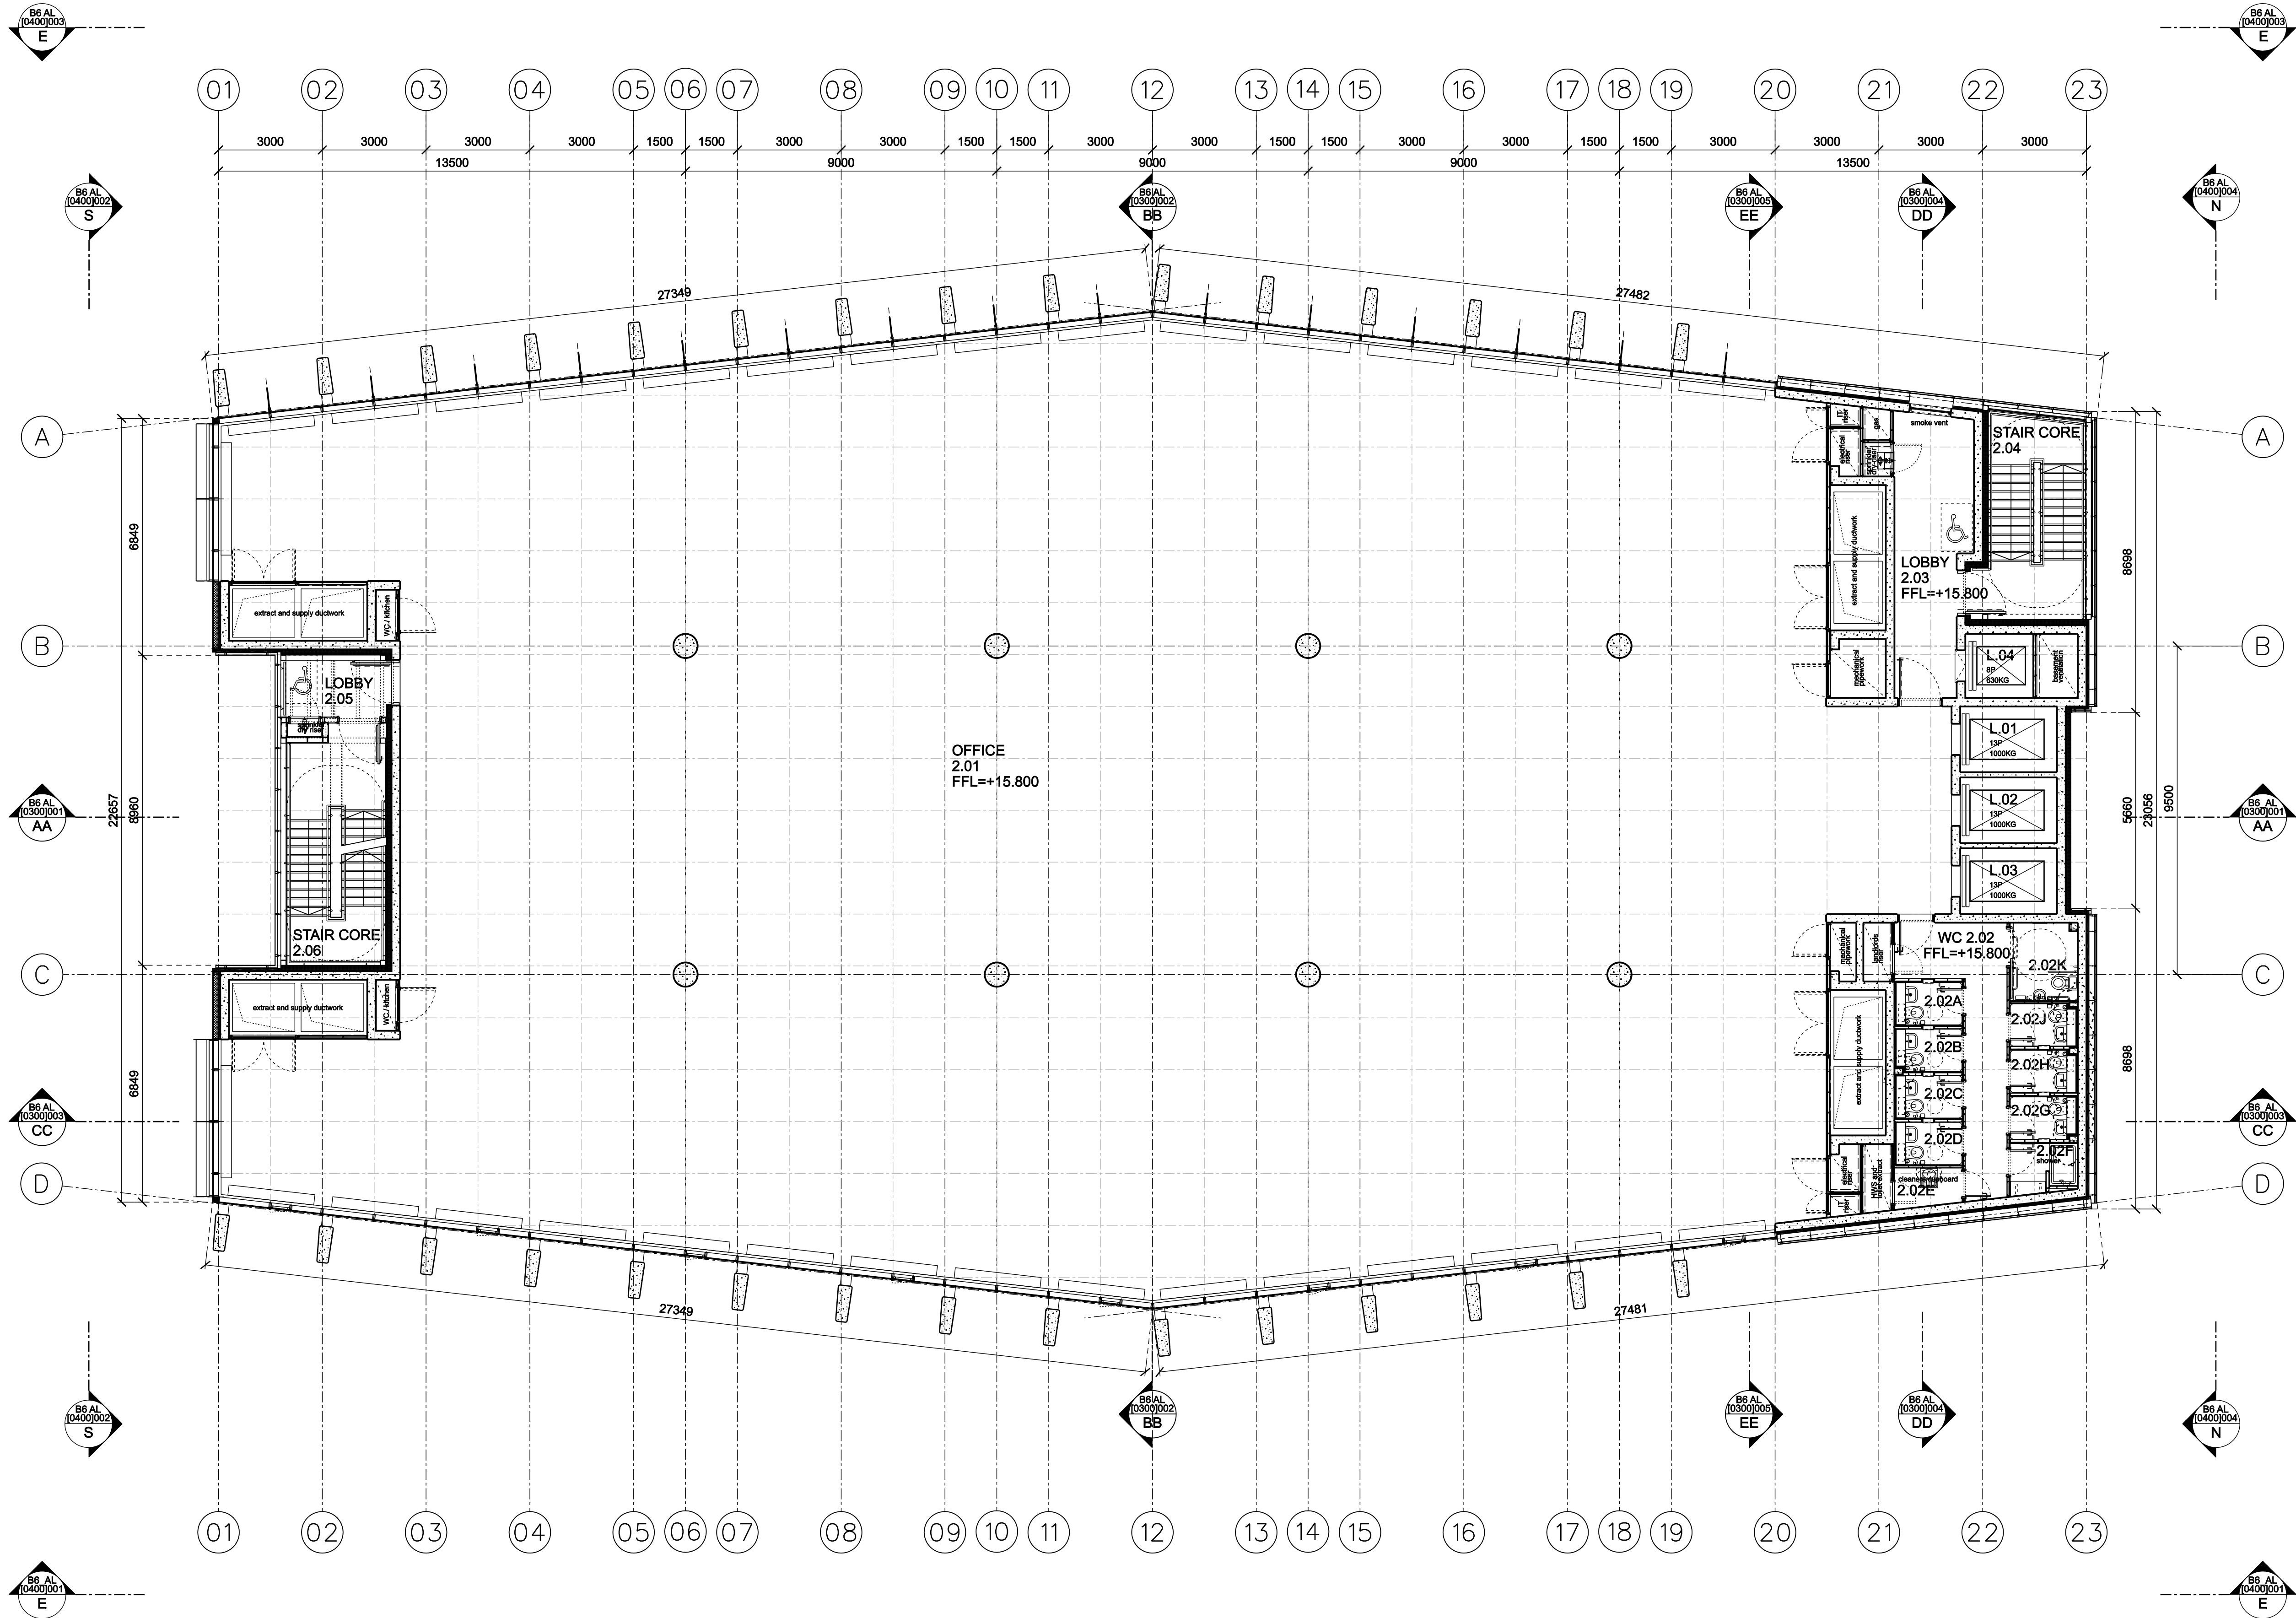

- NOTES
1. Do not scale from this drawing.
 2. All dimensions to be checked on site by the contractor and such dimensions to be his responsibility
 3. Report all drawing errors, omissions and discrepancies to the architect
 4. Refer to individual packages and schedules for dimensions, levels and setting out information.

CONSULTANTS	
CLIENT:	NOTTINGDALE LTD - C/O MONSIEUR LIMITED, 179 HARROW ROAD, PADINGTON, LONDON W2 6RH
STRUCTURAL ENGINEER:	ADAMS KARA TAYLOR - CHARTER HOUSE, 2 FARRINGTON ROAD, LONDON, ECM 3JW
MECHANICAL ENGINEER:	WATERMAN GROUP Plc - VERSAILLES COURT, 3 PARIS GARDEN, LONDON, SE1 8NE
COST CONSULTANT:	JACKSON COLES - MORELANDS, 3RD FLOOR, BLOCK B, MORELANDS, 5-23 OLD STREET, LONDON, EC1V 9JL
PROJECT MANAGER:	JACKSON COLES - MORELANDS, 3RD FLOOR, BLOCK B, MORELANDS, 5-23 OLD STREET, LONDON, EC1V 9JL
ACOUSTIC CONSULTANT:	SANDY BROWN ASSOCIATES - 1 COLEBROGE GARDENS, LONDON NW6 3DH
SPECIFICATIONS CONSULTANT:	
LANDSCAPE ARCHITECTS:	MUF - 49-51 CENTRAL STREET, LONDON, EC1V 8AB
CLADDING CONSULTANT:	
CONTRACTOR:	LANG O'DOURKE - BRIDGE PLACE, ANCHOR BOULEVARD, ADMIRAL'S PARK CROSSWAYS, DARTFORD, KENT DA2 6SN


KEY	
REV	DATE
B01	100309
As Built Submission	

'As Built' Drawing Issue Notes:

This drawing is based on the last revision issued for construction under the Building Contract, but has been revised to represent the current status on site as of 19th Jan 2009, as advised to us by the Contractor on that day. The drawing has not been verified by site survey.

The references on this drawing refer to drawings which were issued for construction but may not have been updated to incorporate the final building design.

A-SITE REFERENCE: NHV2-AHMM-B6-0200-PL-003

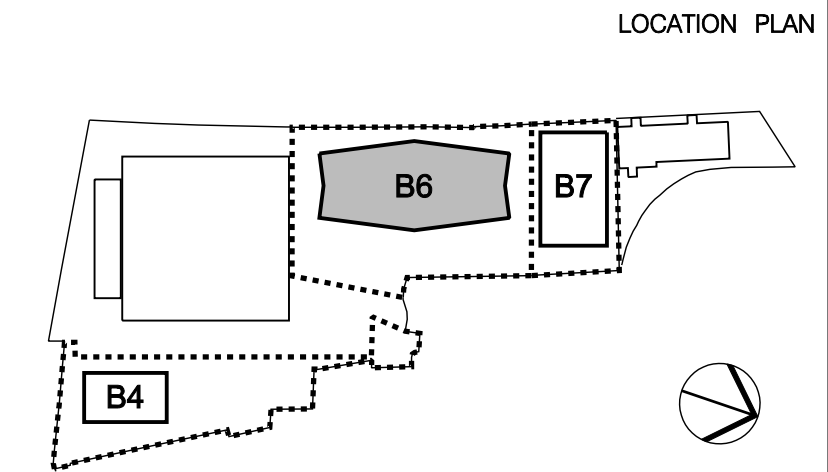

ALLFORD HALL MONAGHAN MORRIS

ARCHITECTS LLP
2ND FLOOR, BLOCK C, 5-23 OLD STREET LONDON EC1V 9JL
TEL: 020 7261 5261 FAX: 020 7261 6123 E: INFO@AH-MM.CO.UK

job title NOTTING HILL VILLAGE - PHASE 2
drawing title/location B6 - SECOND FLOOR PLAN

drawn by	checked	scale	date
GO	PR	1:100@A1; 1:200@A3	AS BUILT
project	zone	type	CSB element
A668	B6 AL [0200] 003	B01	