


The information contained herein is classified "confidential". It is the sole property of British Land and any use there of and/or reproduction there of is expressly prohibited without the written consent of British Land.

It is the responsibility of Contractors and/or Clients to check measurements displayed on the drawings. British Land accepts no responsibility for errors brought about by incorrect measurements.



Notes:

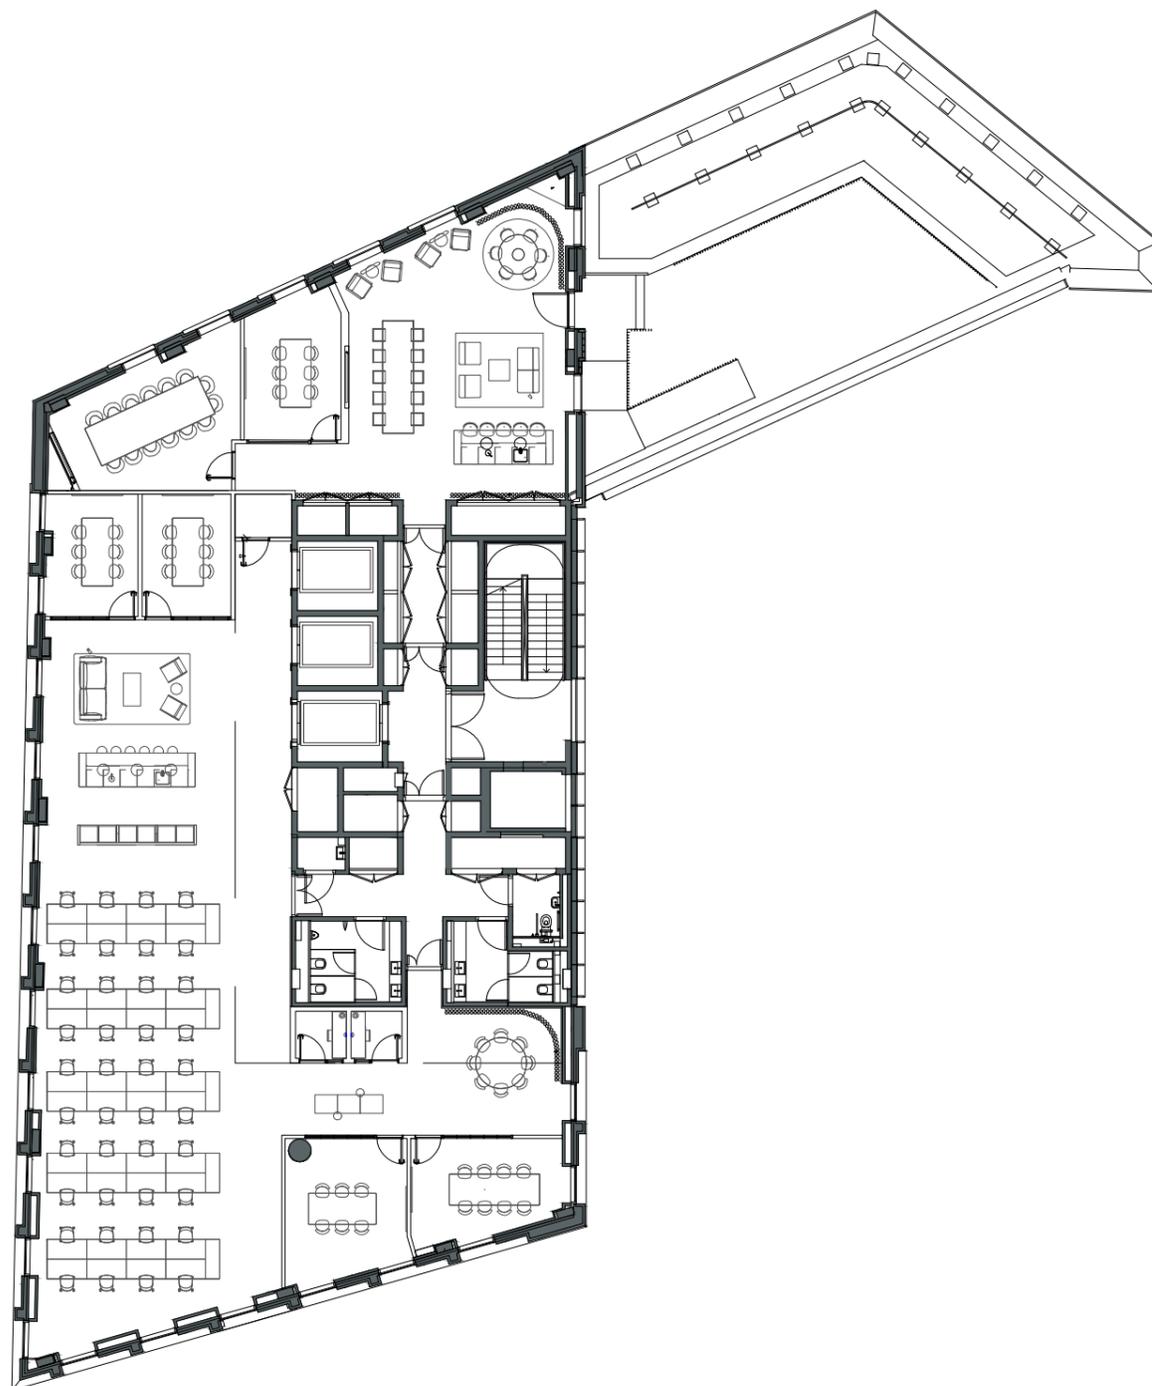

Rev.	Description	Init.	Date

**Work Ready**  
BY BRITISH LAND

Tel: 020 7467 3451  
www.britishlandworkspace.com

Facility Address  
**ELDER YARD  
LONDON  
E1 6DB**

Customer

Drawing Title  
**LEVEL 5  
AS INSTALLED**

Drawn By <b>DJ</b>	Date	Scale
Checked By	<b>25.11.25</b>	<b>1:250 @ A3</b>
file name		