

EQUIPMENT SCHEDULE

1. VEG CHILLER.	16. HC900.	32b. 3 BOWL SINK - 1650x950.	57. DISHWASHER.	78c. SLUSH MACHINE.
2. KREMEBALL MACHINE	16a. HC900 - FLAPS IN PLACE OF DOOR.	33. S/S SHELVING.	58. S/S WALL TO SIDE OF FRYER.	78d. TABLE TOP CARPIAGANI
3. TILL.	17. BUN TOASTER.	34. CHEMICAL CUPBOARD.	59. DUKE HSHU HOT HOLD TO B.S. - 3x2 HIGH.	78e. BLENDERS & TOPPINGS TABLE
3a. SELF SERVICE KIOSK.	18. WHB with bin under	35. COLD DRAWERS.	59a. DUKE HSHU HOT HOLD TO HCW- 2x2 HIGH.	79a. EPCS PANEL.
3b. HANDHELD TERMINAL.	19. BURGER STATION.	36. POST MIX SYRUPS.	60. STAR GRILL.	79b. EPCS MONITOR.
4. POST MIX DISPENSE.	20. BREADING TABLE.	37. EXTRACT HOODS.	61. WATER MAIN.	80. POSITION OF 2nd HOT WATER SUPPLY.
5. COFFEE MACHINE.	20a. LINEAR DOUBLE BREADING TABLE.	38. MOP SINK.	62. WATER CYLINDER / BOILER LOCATION.	81. OIL MANAGEMENT SYSTEM TANK.
6. HCS5.	20b. TANDEM DOUBLE BREADING TABLE.	39. ELECTRIC SWITCHGEAR.	63. INTRUDER ALARM PANEL.	82. CO2 STORAGE.
6a. HCS5 BASE.	20c. SLIMLINE BREADING TABLE.	40. ISS PRODUCT PACK.	64. BRITVIC DRINKS COOLER.	83. PEPSI FRIDGE
7. BUN CHUTE.	21. UPRIGHT FREEZER.	41. UPRIGHT FRIDGE.	65. KEY BOX.	84. FATSTRIPPA GREASE TRAP
7a. 2 TIER TRANSFER BIN	22. S/S TABLING/BENCH.	42. STORAGE SHELVING.	66. THAW CABINET.	84a. COMBINED FATSTRIPPA MOP SINK
7b. 3 TIER TRANSFER BIN	22a. MOBILE CHICKEN PACKING TABLE.	43. INSECT KILLERS.	67. MOP STORAGE.	85. BRUSH RACK
7c. BUCKET CHUTE	22b. MOBILE DRINKS RACK	44. FLOOR STANDING PATCH CABINET.	68. SINK FOR COOK WATER.	86. ELECTRICAL SERVICE COLUMN
8. CHIP DUMP / PASS THRU.	23. HC903.	45. ICE CREAM MACHINE.	69. HOT WELL TABLE.	87. PDMO HOSE.
9. KAYS UNIT.	23a. HC904.	45a. ICE CREAM FREEZER.	70. COLD FOOD TABLE.	88. BIFFA BIN.
10. MICROWAVE.	24. HCW3.	46. FRIDGE UNIT UNDER.	71. TWISTER DRAWER.	89. LEARNING ZONE.
10a. MICROWAVE TABLE.	24a. HCW3 BASE.	47. CONDIMENT UNIT.	72. STAR GRILL TABLE.	90. FUSION TIMER
11. 520x775 CHIP FREEZER.	25. 8 TIER RACKS 600X380.	48. SAFE.	73. HCS2.	91. NEW CHIP DUMP
11a. FRIES BASKET TABLE.	26. HOT DRAWERS.	49. LANDING TABLE.	74. HCW5.	92. FIU5
11b. 900x775 CHIP FREEZER.	27. BREAKING TRAY.	50. 2 DRAWER FILING CABINET	75. GOODS HOIST.	93. FIU5 FILTER
12. 4 HEAD HENNY PENNY.	28. BOTTLE STORAGE.	51. MOBILE BUN DEFROST UNIT.	76a. ADANDE 885x885mm.	94. PACKAGING TOWER
12a. 6 HEAD COLECTROMATIC COUNTER.	29. FREEZER ROOM	52. PHONE.	76b. ADANDE 1100x700mm	95. DUAL SOFT SCOPE DISPENSER
13. 8 HEAD HENNY PENNY.	30. COLD ROOM.	53. WORKTOP ON CHROME LEGS.	76c. ADANDE to HCS5.	96. SATO OVEN
14. 14" FRYER.	31. ICE MACHINE.	54. WALL MOUNTED VIDEO CUPBOARD.	77. RATIONALE OVEN.	
14a. 18" FRYER.	32. 3 BOWL SINK - 2550x750.	55. KITCHEN BIN.	78a. RAZZLE MACHINE.	
15. COUNTER.	32a. SINGLE BOWL SINK.	56. FIRE ALARM INDICATOR PANEL.	78b. PUMP AND TOPPING MACHINE.	

WALL TYPE SCHEDULE

	existing structural wall / column		new structural wall / column
	existing partitioning		new full height partitioning
	existing floor mounted low height partitioning		new floor mounted low height partitioning
	existing worktop mounted full height partitioning		new worktop mounted full height partitioning

FUSION MONITOR KEY

	burger station pack screen		order ready		cctv monitor
	pack screen		beverage		d/t monitor
	chicken pack screen		burger chute (provisional)		
	drive thru expedite		under counter expedite screen - perspex panel to counter top with screen under		

BOH EQUIPMENT COLOURS SCHEDULE

unchanged equipment numbers (black)	00.	additional equipment numbers (red)	00.
repositioned equipment numbers (green)	00.	provisional equipment numbers (blue)	00.

INTERNAL & EXTERNAL FURNITURE SCHEDULE

location	internal	external	location	internal	external
existing seats	95	-	proposed seats	102	-
existing tables	33	-	proposed tables	34	-
existing sets	33	-	proposed sets	25	-

FOH DESIGN SIGNOFF

Name / Title	Signature	Date
Design Manager		24.06.15

BOH DESIGN SIGNOFF



Name / Title	Signature	Date
Equipment Manager		

GROUND FLOOR AREA SCHEDULE

front of house area	170.87 m²	1838.5 ft²
back of house area (inc counter)	74.0 m²	796.4 ft²
staff amenity area	0 m²	0 ft²

NOTE:
SERVICE RUNS FOR FLOORS ABOVE TO BE AGREED

proposed letterbox area detail
scale - 1:20 @ A1

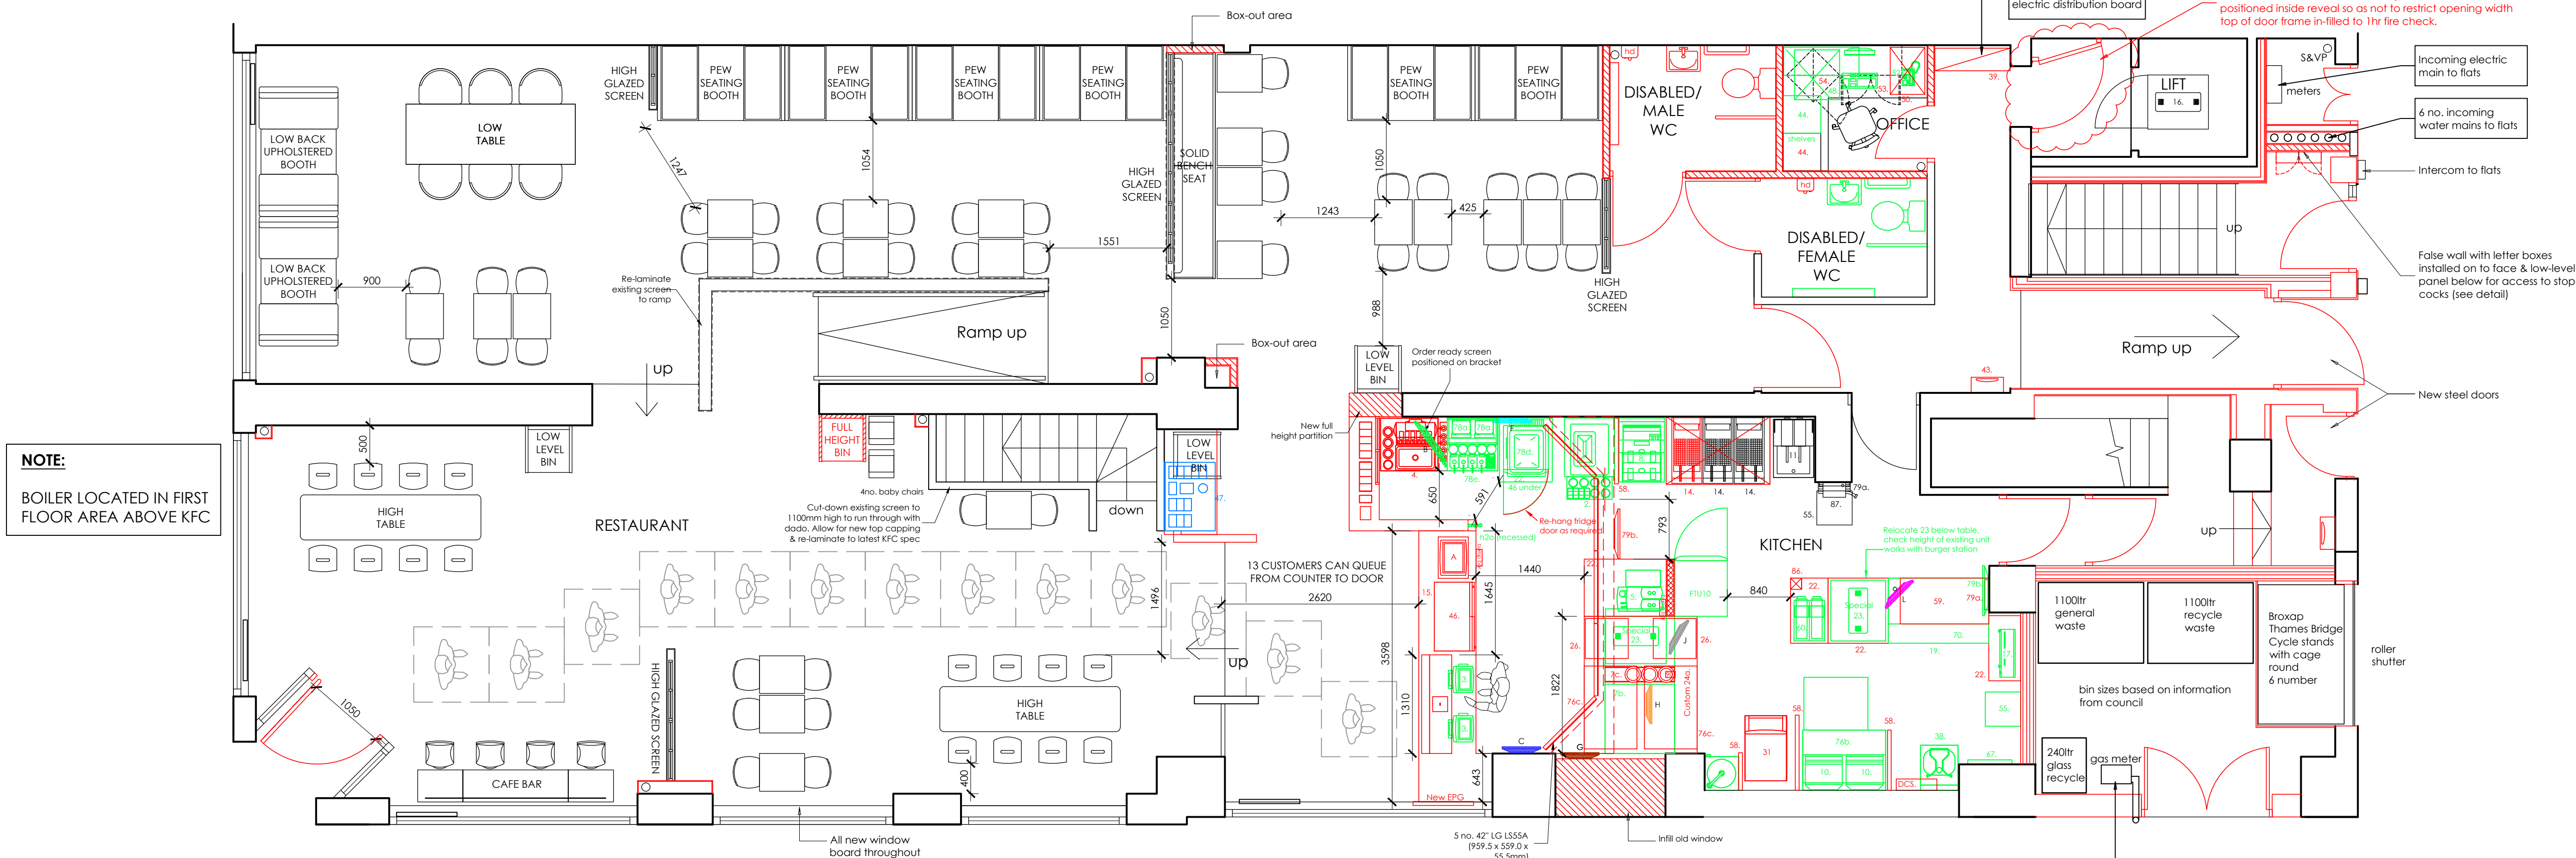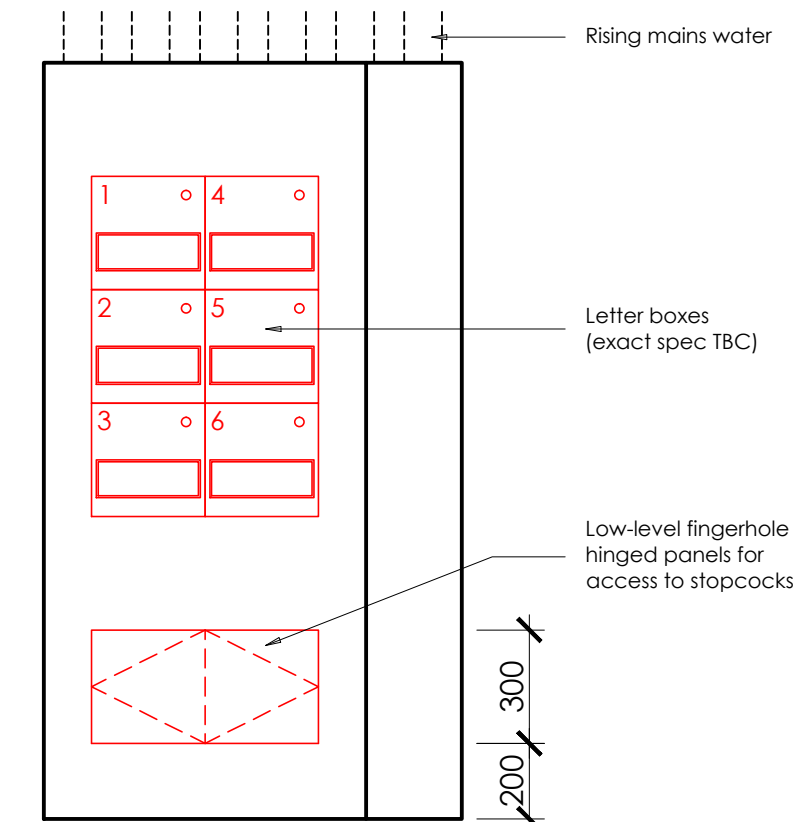

proposed ground floor general arrangement
scale - 1:50 @ A1 / 1:100 @ A3

ALL DIMENSIONS TO BE CHECKED ON SITE.

DO NOT SCALE FROM THIS DRAWING EXCEPT FOR THE PURPOSES OF LOCAL AUTHORITY PLANNING

A	09.07.14	Updated as per KFC's comments RJS
B	22.07.14	Revised as per KFC approved plan & additional revisions to BOH as per existing photos TMC JLE
C	26.01.15	Design updated IE
D	03.02.15	FOH layout amended IE
E	06.02.15	Minor amendments to FOH & BOH IE
F	11.03.15	After B.O.H for flat access/bins, after seating as NH email SBR
G	21.04.15	Plan updated to reflect site dims RJS
H	28.05.15	Plan updated to latest KFC specification RJS
J	02.06.15	Low table removed for high table near entrance TMC
K	26.06.15	KFC FOH design sign off added RJS
L	01.07.15	alter walls to rear entrance to match construction office revised SBR RJS
M	14.07.15	add gas meter location SBR
N	31.07.15	alter access to flat meter cpbd & screen G reloc. SBR
P	24.08.15	Bin store & cycle storage area revised BOH layout amended to suit RJS
Q	04.09.15	Wall to rear kitchen area replaced with s/s screen RJS
R	29.10.15	Rear areas for incoming services revised RJS
S	05.11.15	FOH furniture revised & top repositioned RJS
T	19.11.15	AS BUILT AMENDMENTS RJS
U	09.12.15	Door to lift revised. AS BUILT RJS

rev	date	description

HONE EDWARDS ASSOCIATES
Design Studio
Millars Three
Southmill Road
Bishop's Stortford
Herts. CM23 3DH
email: firstname.lastname@honeedwards.co.uk
Tel: 01279 758545
Fax: 01279 757730



IMAGE ENHANCEMENT

store address
ALDERSHOT
17 UNION STREET
TOWN CENTRE
ALDERSHOT
HAMPSHIRE
GU11 1EP

drawing title
PROPOSED GROUND FLOOR GENERAL ARRANGEMENT PLAN

drawn by	checked	date
RJS	JE	JULY 2014
store no.	scale	
5459	1:50 @ A1	

drawing no.	revision
5459/2015/G100	
HEA drawing no.	revision
2339/G100	U

AS BUILT