


NOTE:
THIS LAYOUT IS PRODUCED ON THE BASIS OF
AN INTERNAL DIMENSION CHECK SURVEY.
ALL DIMENSIONS MUST BE CHECKED AND
VERIFIED ON SITE BY THE MAIN CONTRACTOR
PRIOR TO COMENCEMENT OF ANY WORK OR
SHOP DRAWINGS.

REVISIONS

Rev.	Details.	Date.
	ACR15072 QA 11274 - layout updated WR11521 - Meeting Rooms ACR17166 QA - SR12612 ACR18810 QA - SR13371 QA - SR14564 WR14780 - Layout Updated QA - SR15849 ACR24140 ACR31181	30.12.16 10.01.17 22.03.17 09.08.17 25.10.17 05.02.18 13.02.18 21.11.18 18.01.19 2019Oct25 2019Oct25 2021Dec24

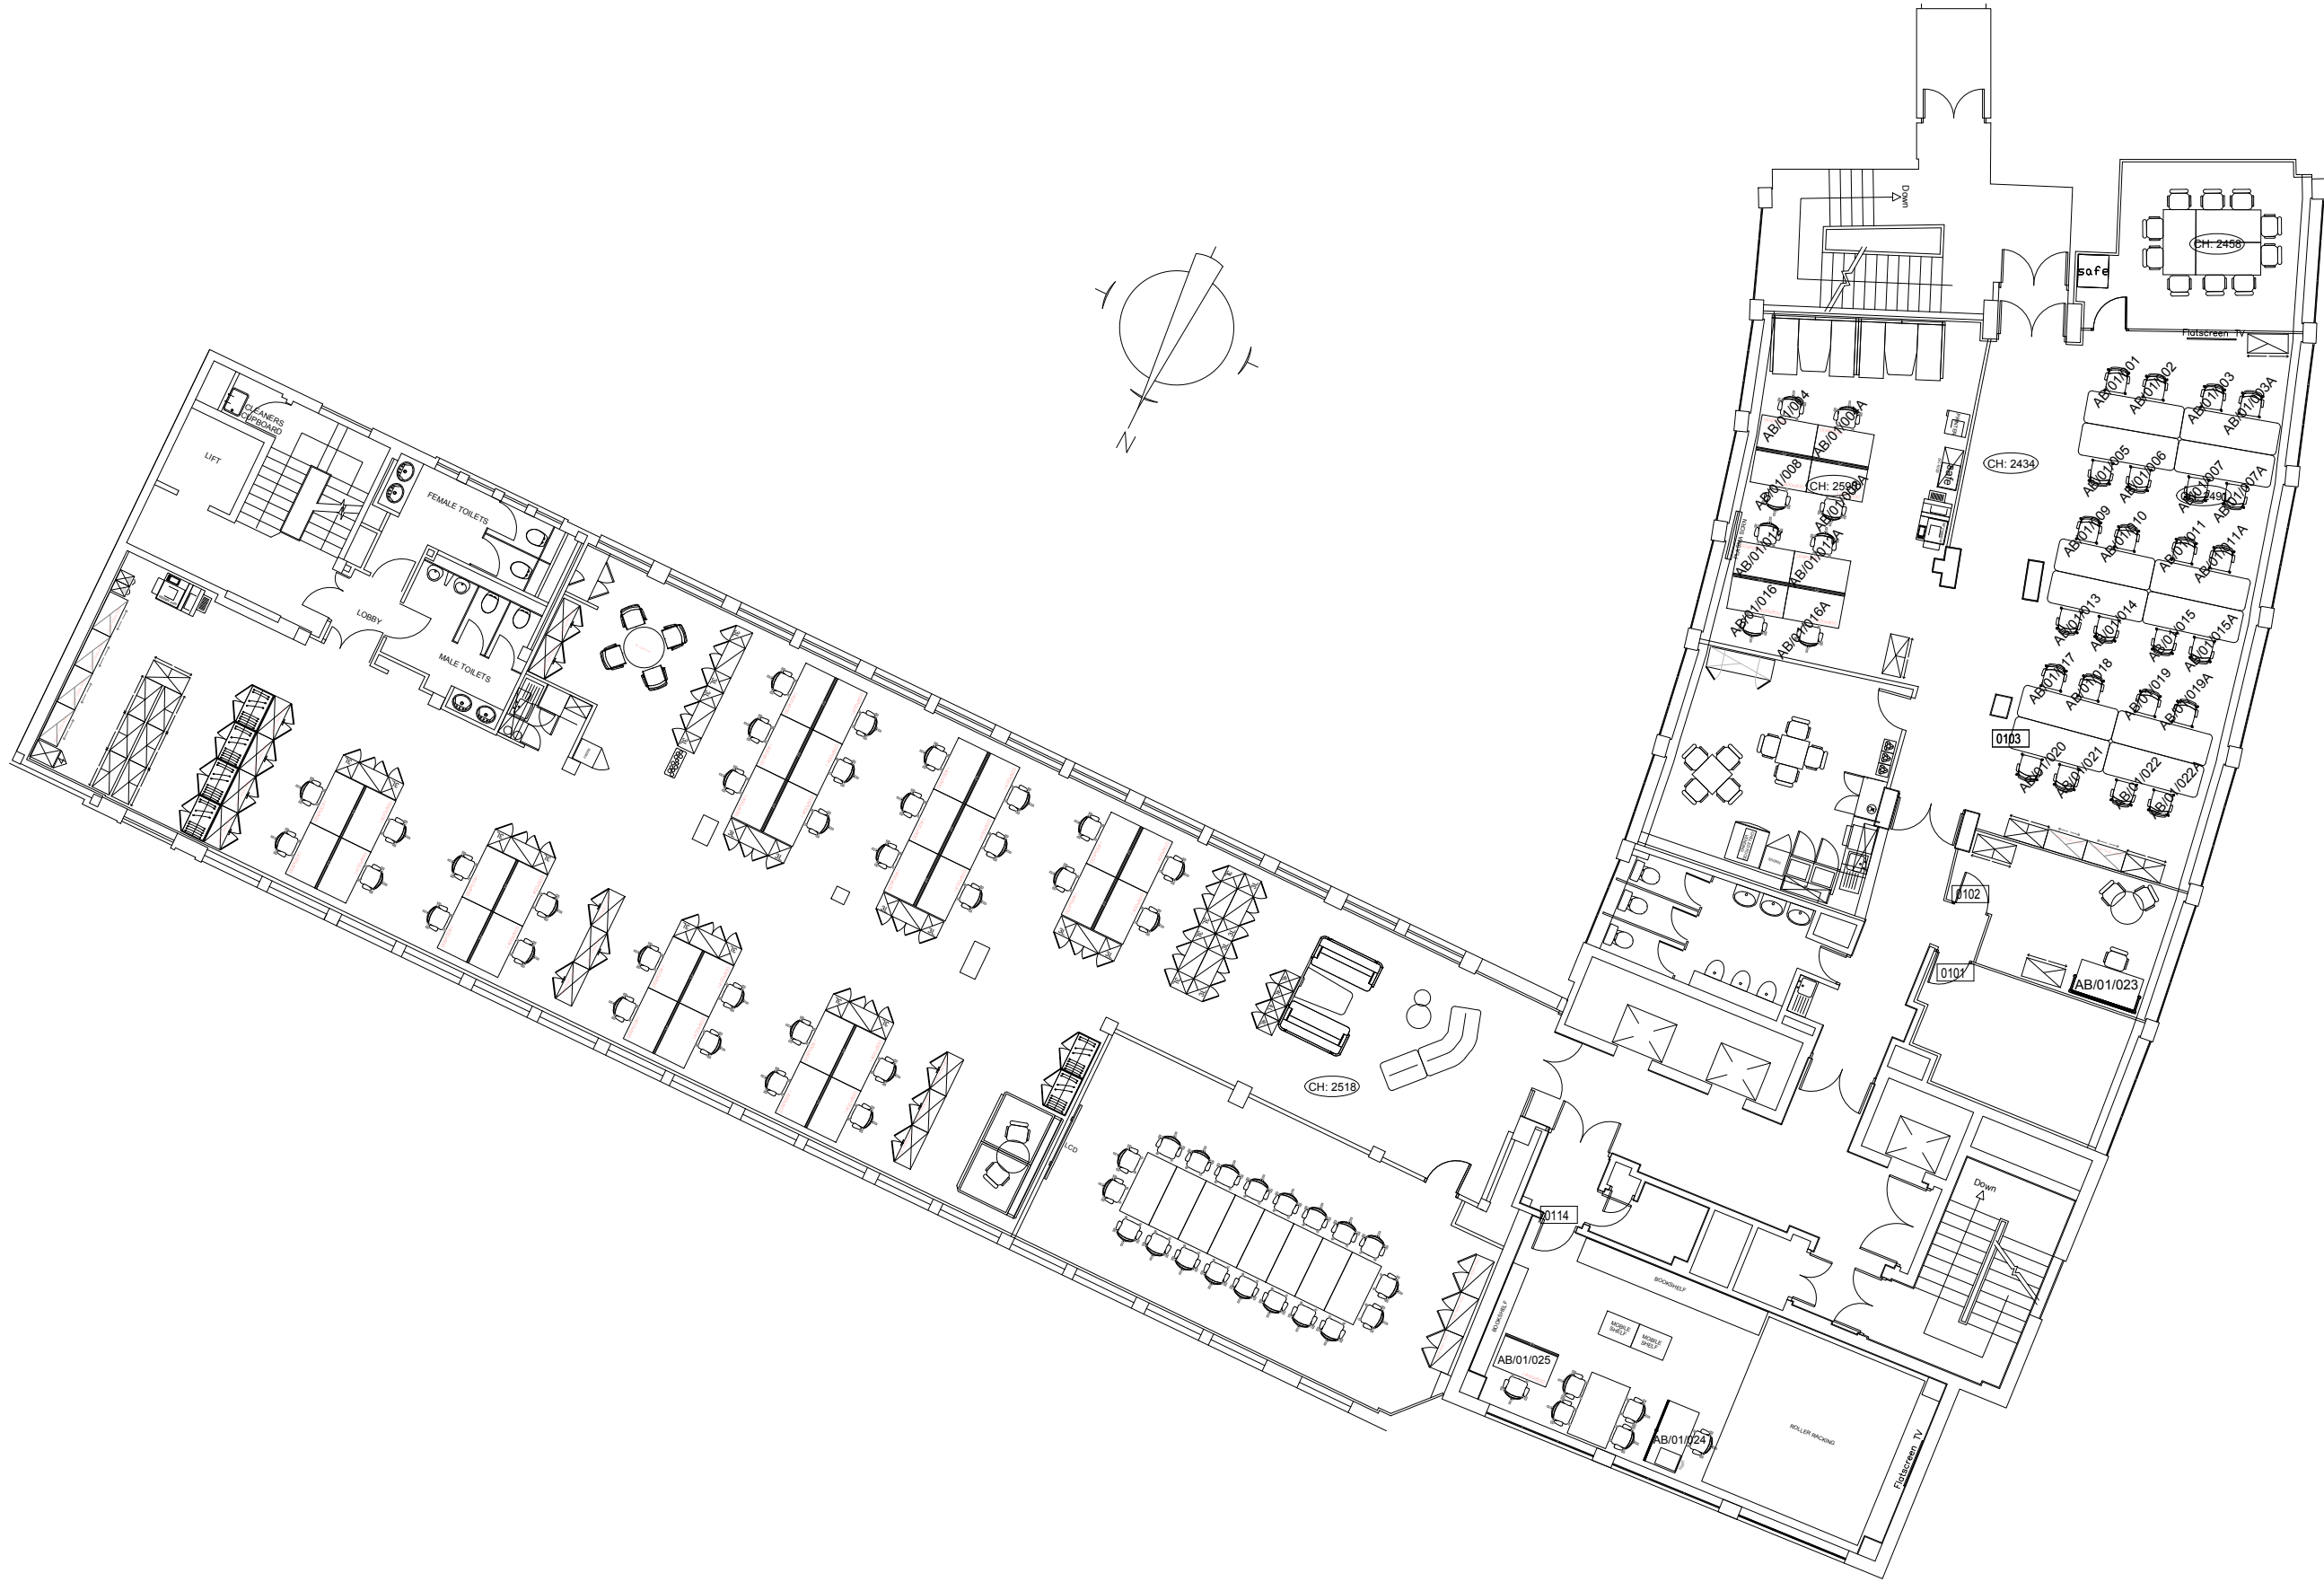

Transport for London

COMMERCIAL DEVELOPMENT
PROJECTS & ACCOMMODATION

PALESTRA
197 BLACKFRIARS ROAD LONDON SE1 8NJ

Drawing Title:

ALBANY HOUSE

Layout:

**FIRST FLOOR
AS BUILT LAYOUT**

Survey Date:	Surveyed By:	Date of Occu Survey:
Drawn By: --	Date: --	Scale: NTS
Checked By:		Date:
Approved By:		Date:

Drg. No.	Rev.
AB_01 TRIRIGA	0