




- Legend
- Carpet tile
 - Vinyl flooring
 - Sheet vinyl for WCs
 - Barrier matting (entrances)

First floor

Ground floor

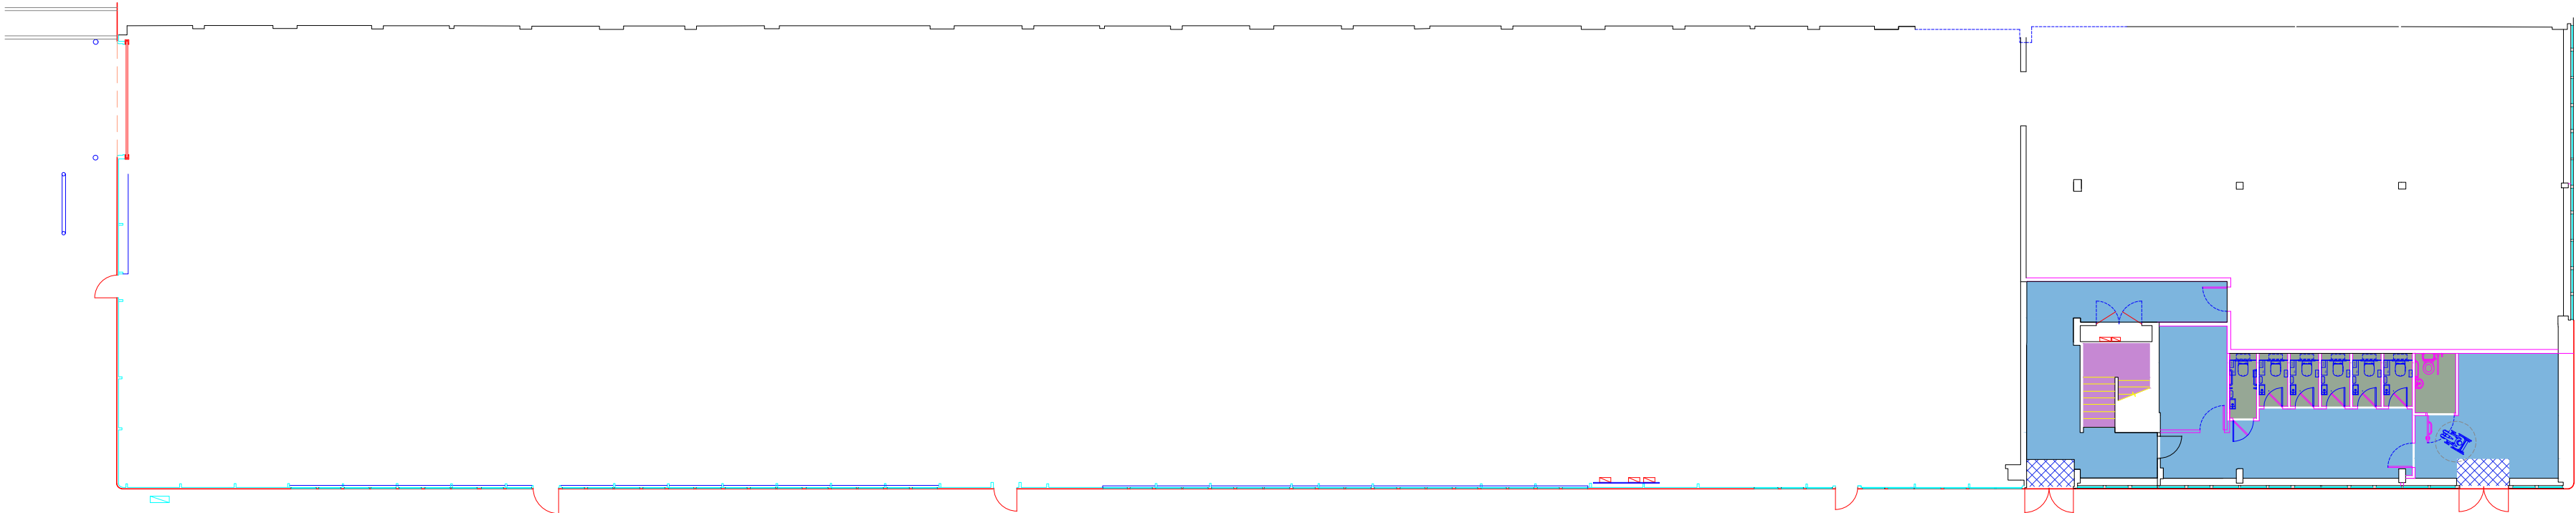

Project: **2 BLACKMOOR LANE
CROXLEY PARK
WATFORD.**

Title: **GROUND AND FIRST FLOOR -
AS BUILT - FLOOR FINISHES**

Drawn:	Checked:	Scale:
Date: AUG 2025	See Status Schedule.	1:200@A2 Do not scale.

Oriongroup ●●●
Building Change

Manor Grange Business Park, Fifield Road, Fifield. SL6 2PG.
t. 01628 621 123
e. admin@oriongroup.uk.com
w. www.oriongroup.uk.com

Drawing No.	Revision
J2343-003	-