


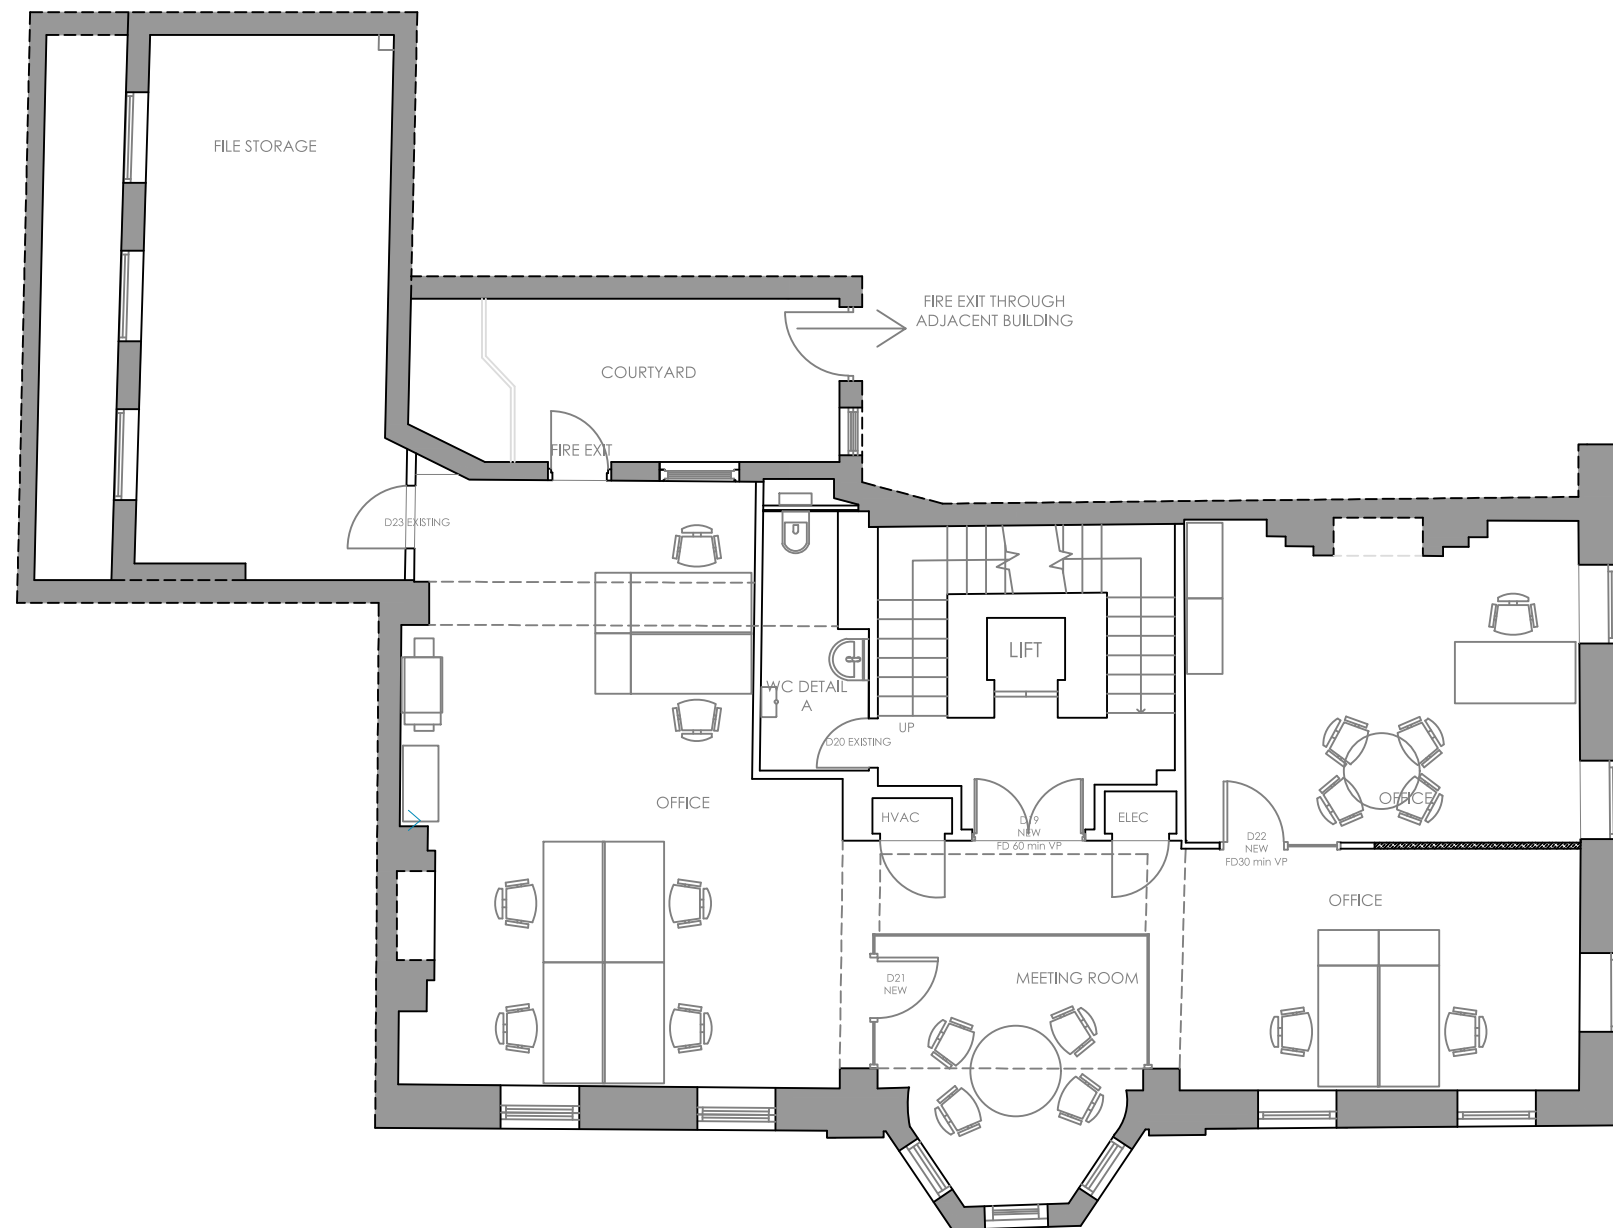

A	Revised Video Entry Locations	03/07/23
-	Initial Issue	12/05/23
Rev:	Amendment:	Date:

Newbury 1
Centrix@Keys
Keys Business Village
Keys Park Road
Hednesford
Staffordshire
WS12 2HA

T: 01543 275101
F: 01543 458278
E: design@hlpuktd.net
W: www.hlpuktd.net



Contract
Sunrider
38 Soho Square
Soho
London
W1D 3HB

Drawing Title
As Builts First Floor

Dwg. no. HLP / 1878 / 02		Rev. -	Paper Size A3
Drawn MM	Date May 2023	Scale 1:100	

SCALE BAR 1:100

Metres: 0 1 2 3 4 5 6

Feet: 0 5 10 15 20