



This drawing is protected under Copyright and at no time must any portion of this drawing be reproduced or copied in any way without the permission of Morgan Lovell.
All dimensions must be checked on site and NOT scaled from this drawing.


SUBJECT TO SITE SURVEY
CHECK SURVEY UNDERTAKEN ONLY
BUILDING PARAMETERS TAKEN FROM DRAWINGS PROVIDED
BUILDING PARAMETERS TAKEN FROM AS BUILT DRAWINGS PROVIDED



- ACCOMMODATION SCHEDULE:**
- 164 OPEN PLAN DESKS
 - 32 HOT CAKE POSITIONS
 - 28 OPEN PLAN WORK TABLE POSITIONS
 - 2 LIBRARY/SILENT WORKING - 15 POSITIONS
 - 2 SEMI-PRIVATE WORK AREA - 12 POSITIONS
 - 25 PRIVATE WORKING PODS/ROOMS
 - 3 HOT OFFICES/MEETING ROOMS
 - 5 COLLABORATION AREAS
 - 3 TEA POINT/COFFEE STATIONS/CATERING STORE
 - 4 PRINT AREAS
 - 1 GOODS IN/POST ROOM
 - 1 CLEANERS STORE
 - 1 FACILITIES STORE
 - 1 FILING ROOMS
 - 1 MARKETING STORE
 - 1 PROJECT ROOM
 - 1 COMMS ROOM
 - 5 SKYPE PODS/ROOMS
 - 17 INFORMAL MEETING AREAS
 - 1 STAND UP MEETING AREAS
 - 6 4 PERSON MEETING ROOMS
 - 4 ONE TO ONE ROOMS
 - 1 6 PERSON MEETING ROOMS
 - 1 10 PERSON MEETING ROOM
 - 2 12-14 PERSON MEETING ROOM
 - 1 16 PERSON MEETING ROOM
 - 1 FURNITURE STORE
 - 1 RECEPTION
 - 1 COFFEE LOUNGE/HUB/COLLABORATION/SEMI PRIVATE MEETS
 - 1 MEDICAL ROOM

- 20 COAT CUPBOARDS IN OPEN PLAN (EST 360 COATS)
- 2.5LM COAT STORAGE IN RECEPTION BEHIND DESK
- 132.5 LM STORAGE WALL
- 82 LM END OF DESK STORAGE
- 279 WORKING POSITIONS OF VARYING STYLE

- 1 EXISTING FURNITURE
- 2 SAGE LOCKERS (PILOT) LOCKERS CAN BE SPLIT IF REQUIRED
- 3 SAGE LOCKERS IN BROADGATE
- 4 NEW LOCKERS

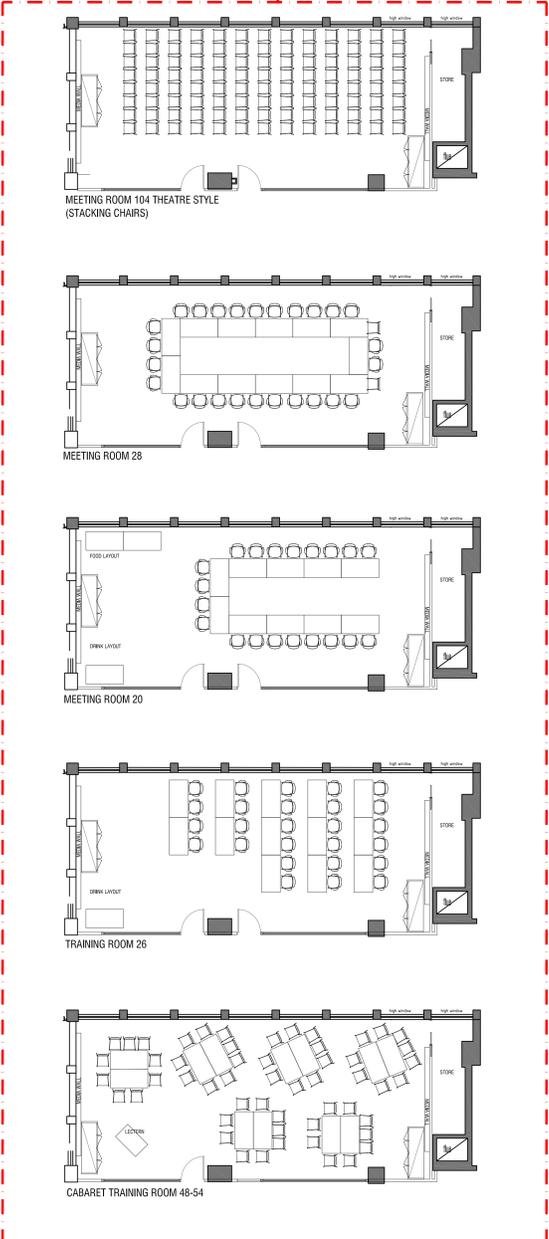

THIRD FLOOR



Rev	Revision	By	Date

AS BUILT

Morgan Lovell

10 Noel Street, London, W1F 8DA
T: 0207 734 4466 F: 0207 734 2969 E: contact@morganlovell.com
W: http://www.morganlovell.com

Client
SAGE

Project
**1 OLIVERS YARD
55-71 CITY ROAD
LONDON
EC1Y 1HQ**

Title
**3RD FLOOR
GENERAL ARRANGEMENT PLAN**

Scale	Date	Designer/Drawn By	Checked By/Date
1:100(BA)	15.04.2019	KL / VM	KL

Drawing Number			
Project No.	Floor	Drawing No.	Rev
ML 3219	3	100	AB