



Please Note:  
This Drawing is a representation only.  
We recommend a check measure prior to any building works.

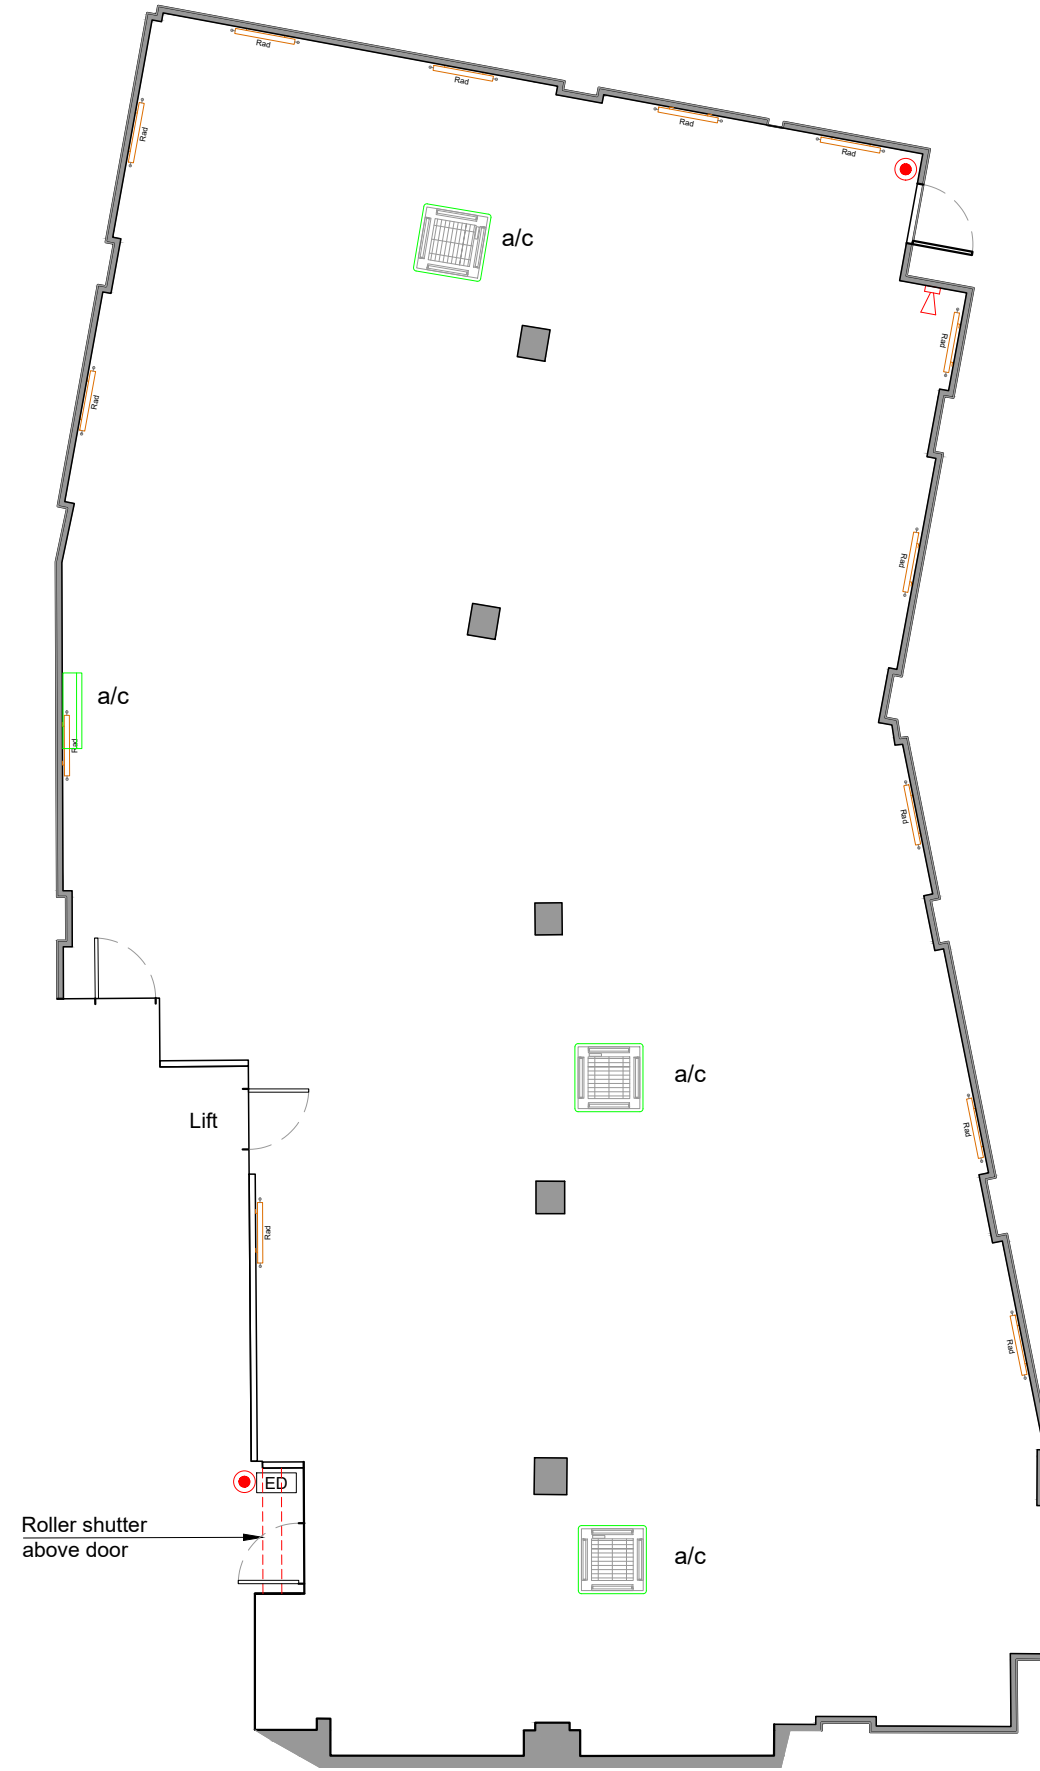

Second Floor

**Legend**

- Fire Strategy**
    - (S) Smoke Detector
    - (●) FA Call point
    - (K) FA Sounder
  - Security**
    - (ED) Door Access Control
  - Mechanical**
    - (Rad) Radiator
    - (A/C) A/C Cassette - Ceiling
    - (A/C) A/C Cassette - Wall
- remedial works

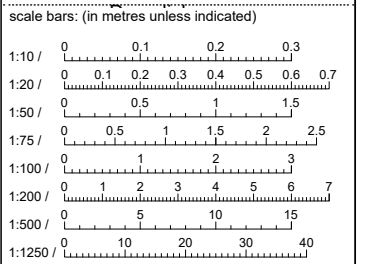

© this drawing is copyright bond davidson, all dimensions to be checked on site.

revisions:

B	Layout amended to asbuilt.	11/09/18	NJ	IH
A	Services and legend added	20/02/18	NJ	IH
	ref.comments.	date.	by.	chk.

site address:  
12 Oval Road  
Camden  
London  
NW1

drawing title:  
Second Floor Layout

drg status: *ASBUILT*		
drg no: 3892.210	rev: B	scale@a3: 1:100
drawn by: NJ	chk'd: IH	date: FEB 2018

**chartered surveyors**  
BOND DAVIDSON  
Warwick House, 1 Claremont Lane,  
Esher, Surrey, KT10 9DP  
T: 01372 469985 / F: 01372 478770  
www.bonddavidson.com

