



NB Responsibility is not accepted for errors made by others scaling from this drawing. All construction information should be taken from figured dimensions only

A3

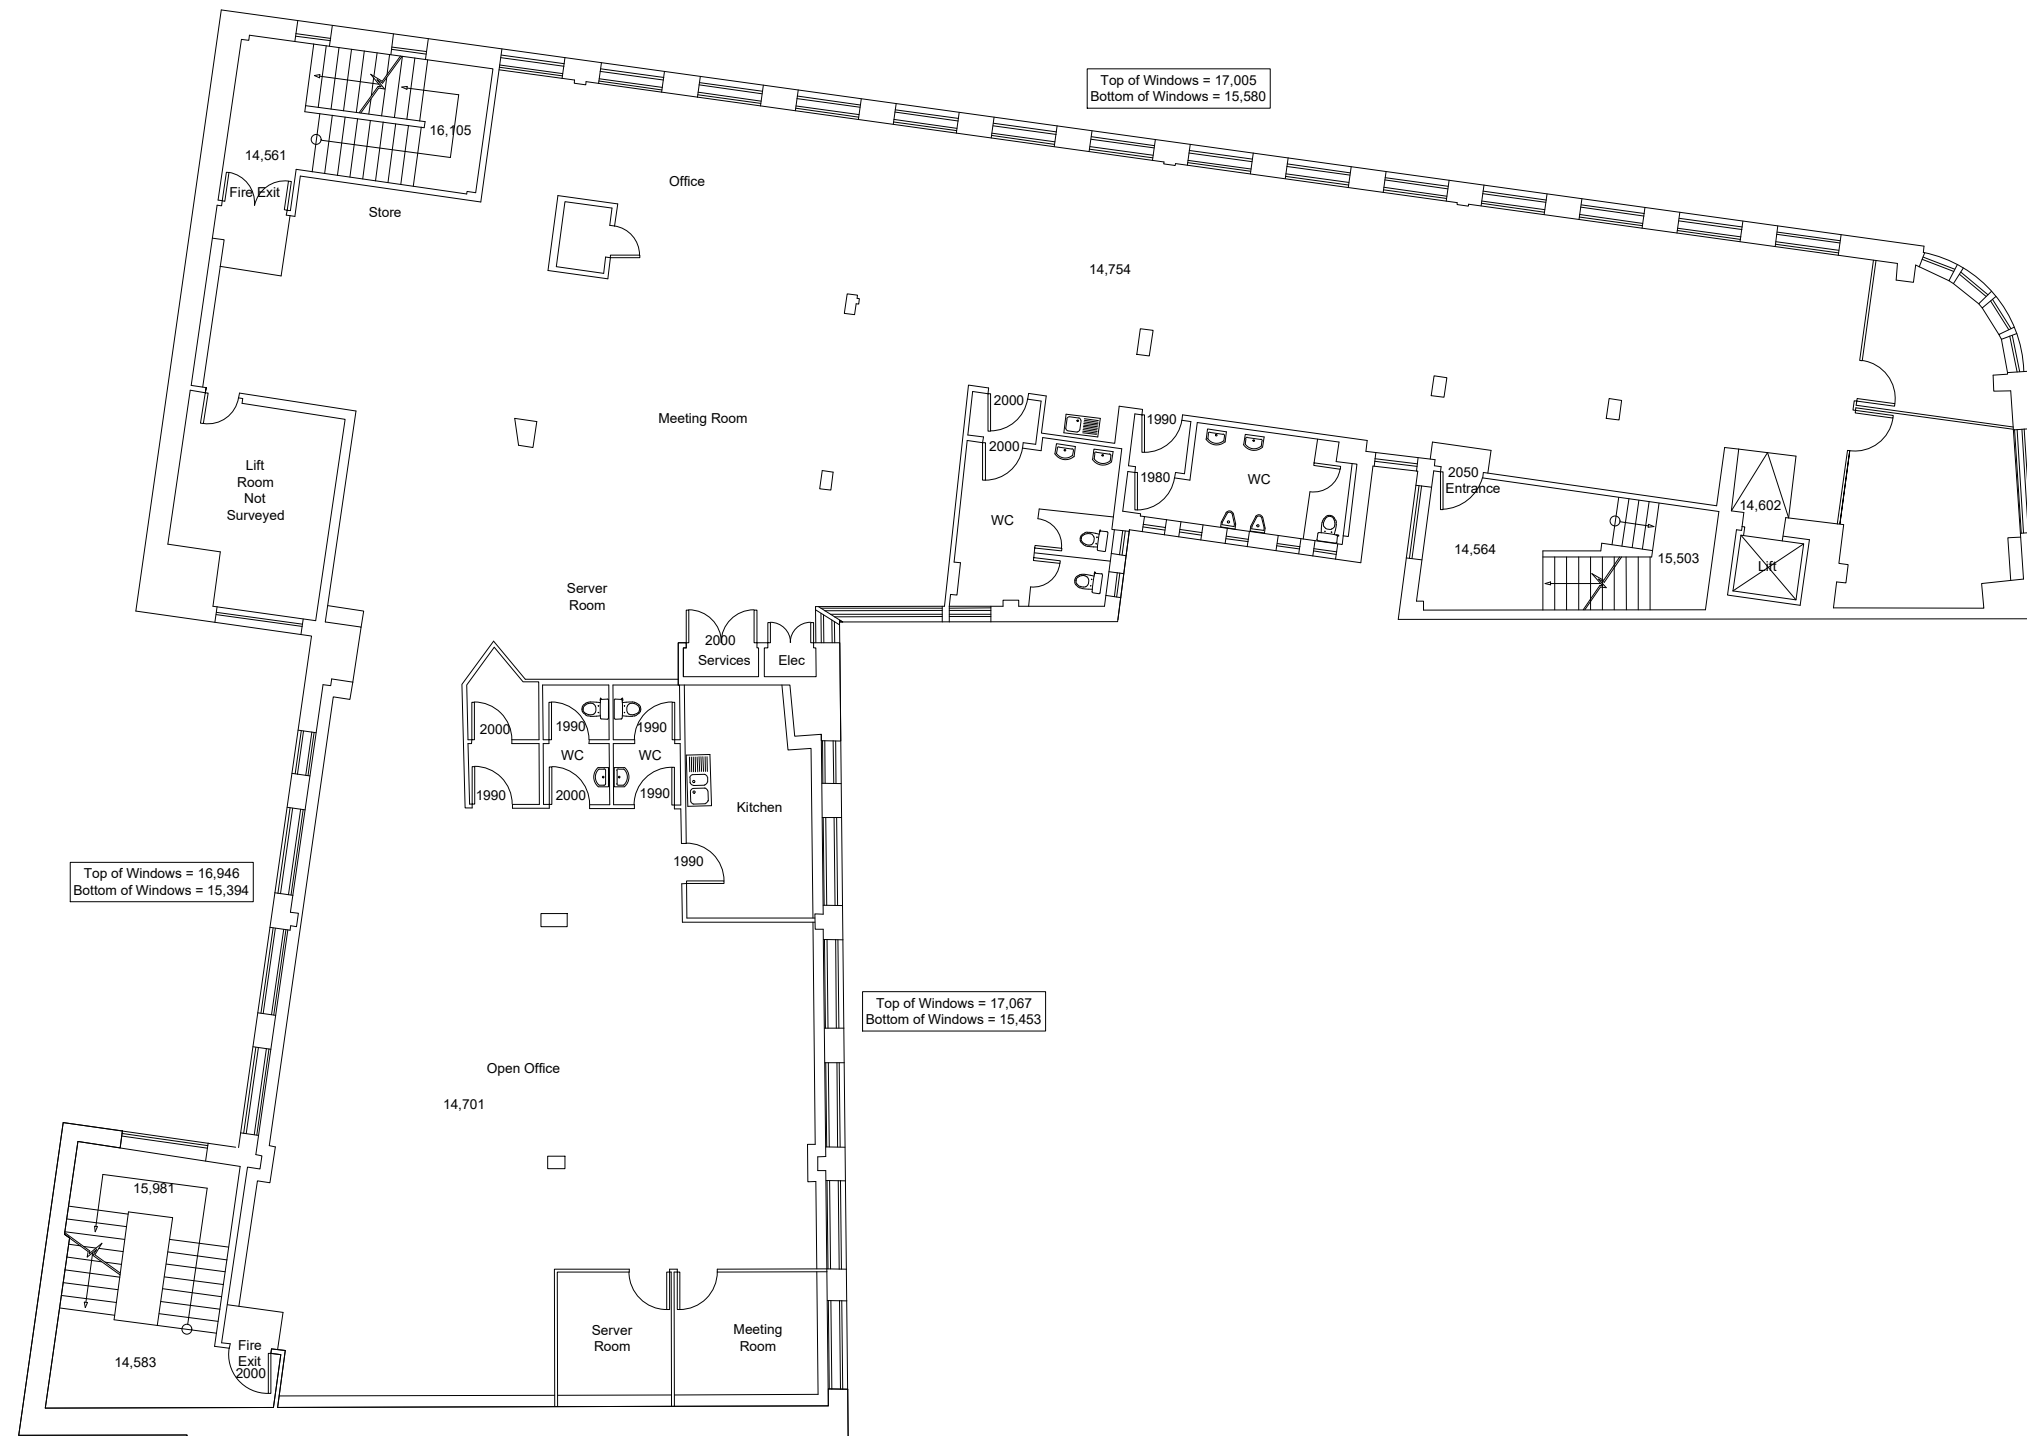

Second Level

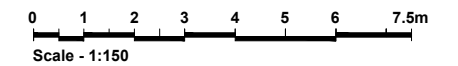

AS BUILT

Rev	Description	By	Date



Project
**REFURBISHMENT TO 32-34
 SOUTHWARK BRIDGE ROAD**

Client
THREADNEEDLE INVESTMENTS Ltd.

Title
**32 SOUTHWARK BRIDGE ROAD
 SECOND FLOOR PLAN**

Drawn by JRO	Surveyor SKC	Date JAN 2020
-----------------	-----------------	------------------



Scale
 1:150 @ A3

Drawing Number L192213-A02-002	Revision
--	----------


Layouts shown were supplied by a 3rd party; Workman LLP therefore take no responsibility for the accuracy or information taken from them.

NB Responsibility is not accepted for errors made by others scaling from this drawing. All construction information should be taken from figured dimensions only

A3

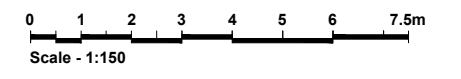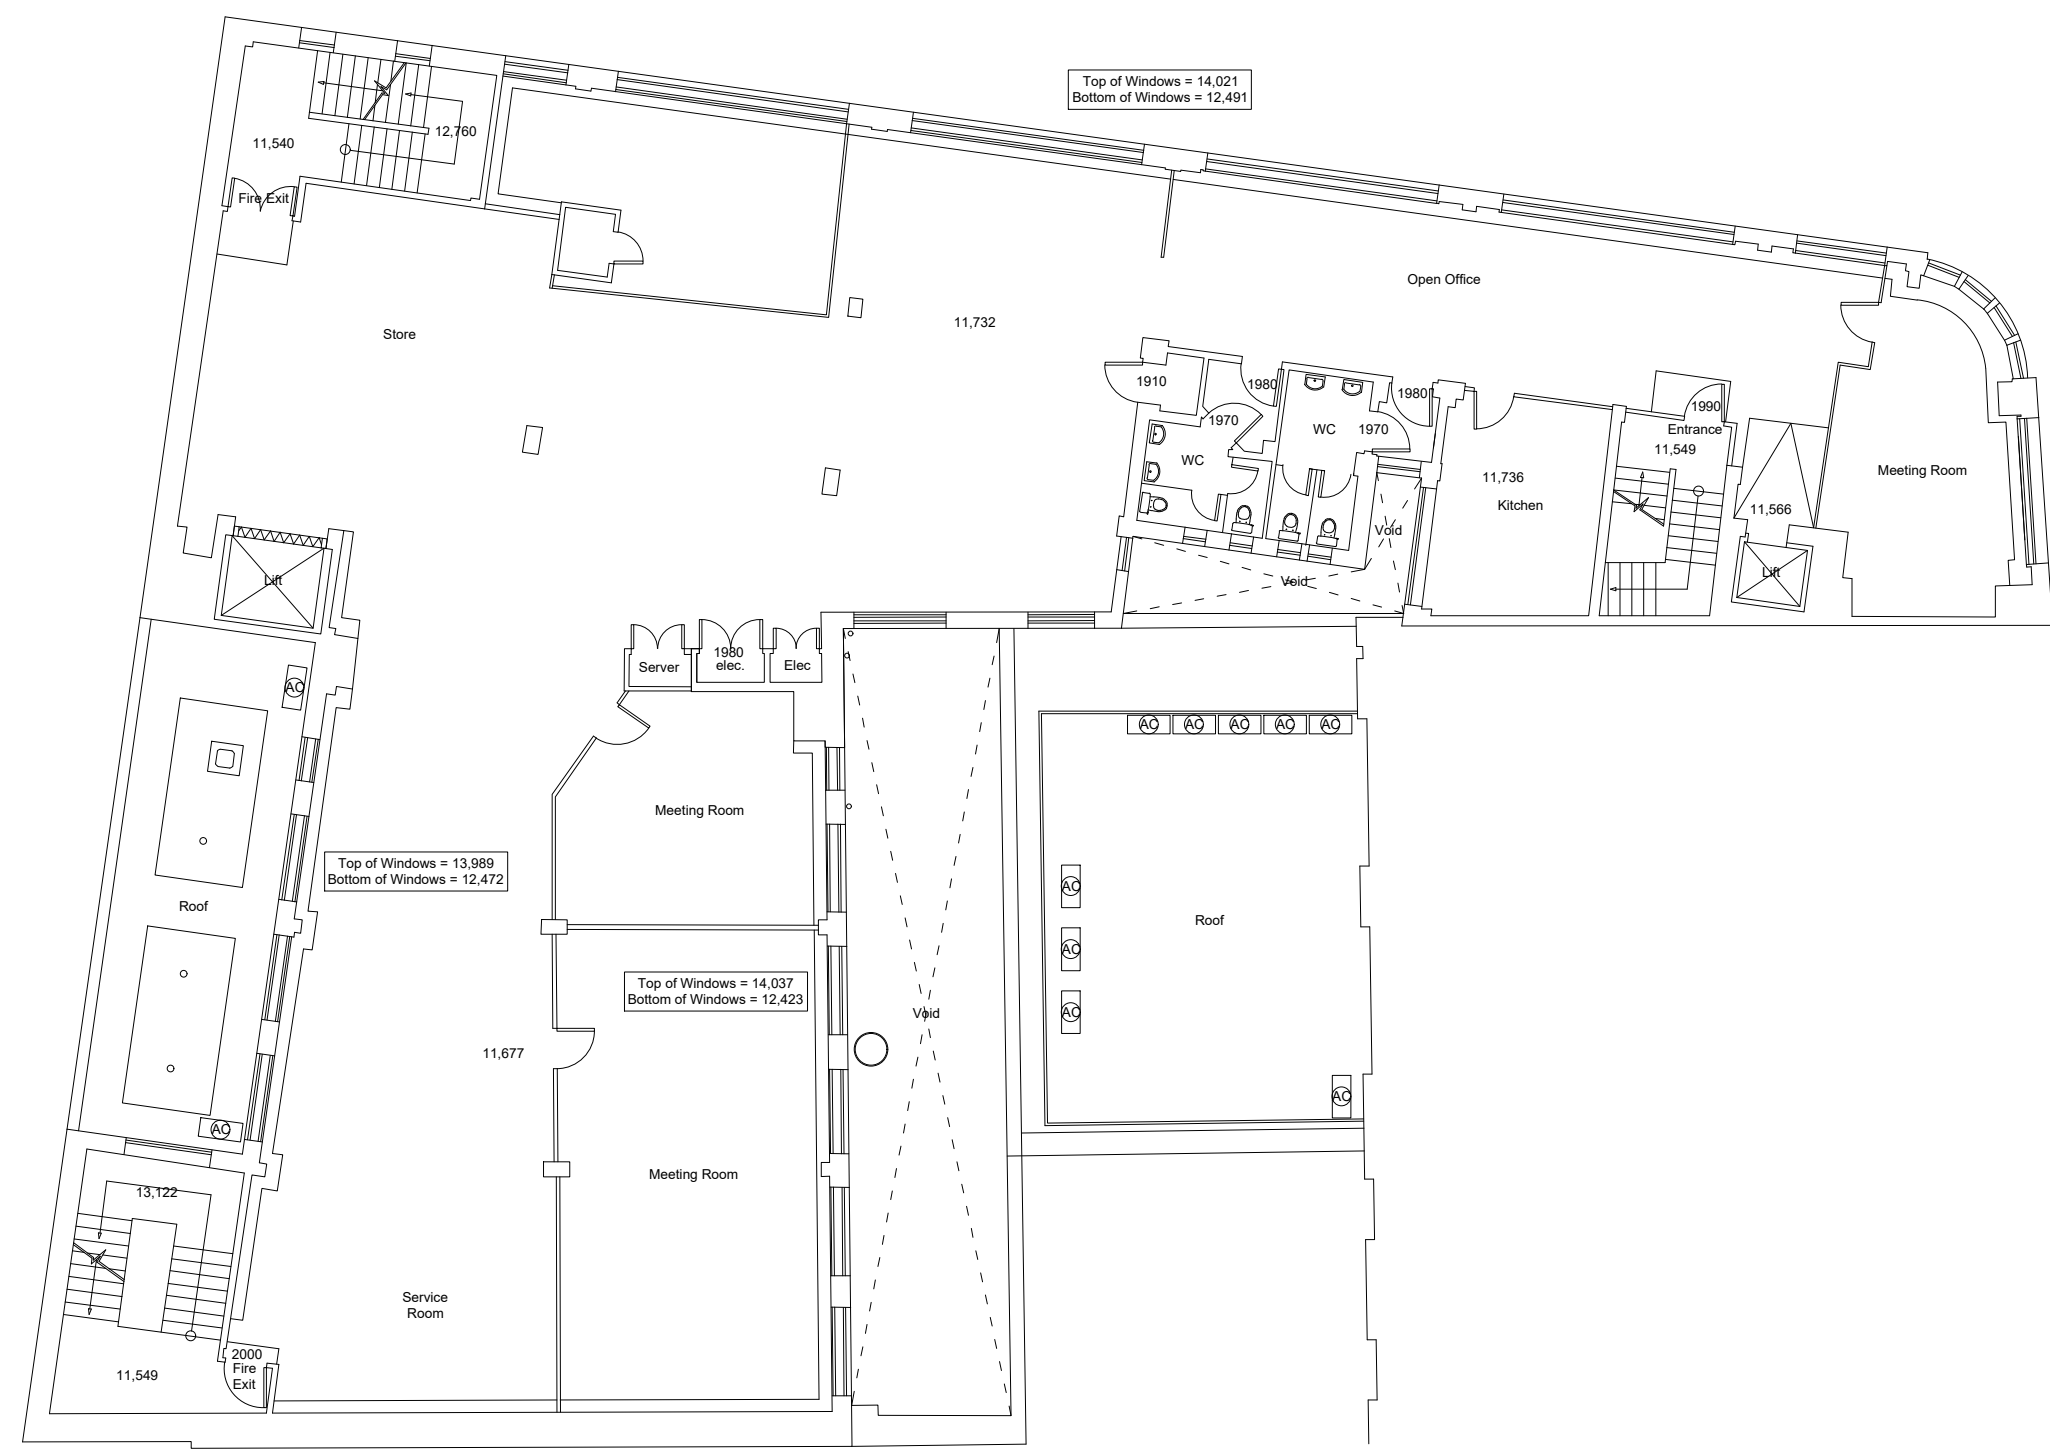

AS BUILT			
Rev	Description	By	Date



Project
REFURBISHMENT TO 32-34
SOUTHWARK BRIDGE ROAD

Client
THREADNEEDLE INVESTMENTS Ltd.

Title
32 SOUTHWARK BRIDGE ROAD
FIRST FLOOR PLAN

Drawn by JRO	Surveyor SKC	Date JAN 2020
-----------------	-----------------	------------------

Scale
1:150 @ A3

Drawing Number L192213-A02-001	Revision
-----------------------------------	----------

First Level

Layouts shown were supplied by a 3rd party; Workman LLP therefore take no responsibility for the accuracy or information taken from them.