

NOTES:

The Drawings, Designs and Details shown are property and copyright of AL Munsell and shall not be copied or reproduced in any form without their written consent.

AL MUNSSELL GROUP copyright 2013



A. All dimensions shown are in millimeters, and do not take into account applied finishes, unless specifically indicated otherwise.

B. Any omissions or discrepancies found shall be reported to the Architect/Designer immediately.

C. This drawing is to be read in conjunction with the relevant section of the specification and schedules.

D. The contractor shall submit test / setting / not drawing for approval (based on site dimensions) prior to commencement of any site works, or placing any materials in manufacture of any fittings, fixtures or components shown.

AS-BUILT
DRAWINGS

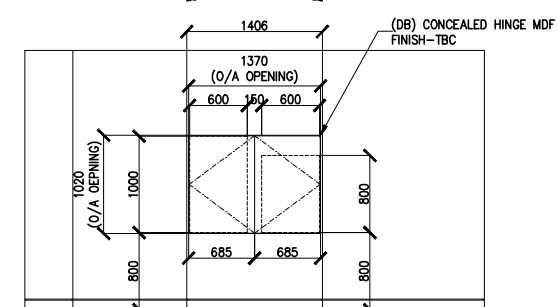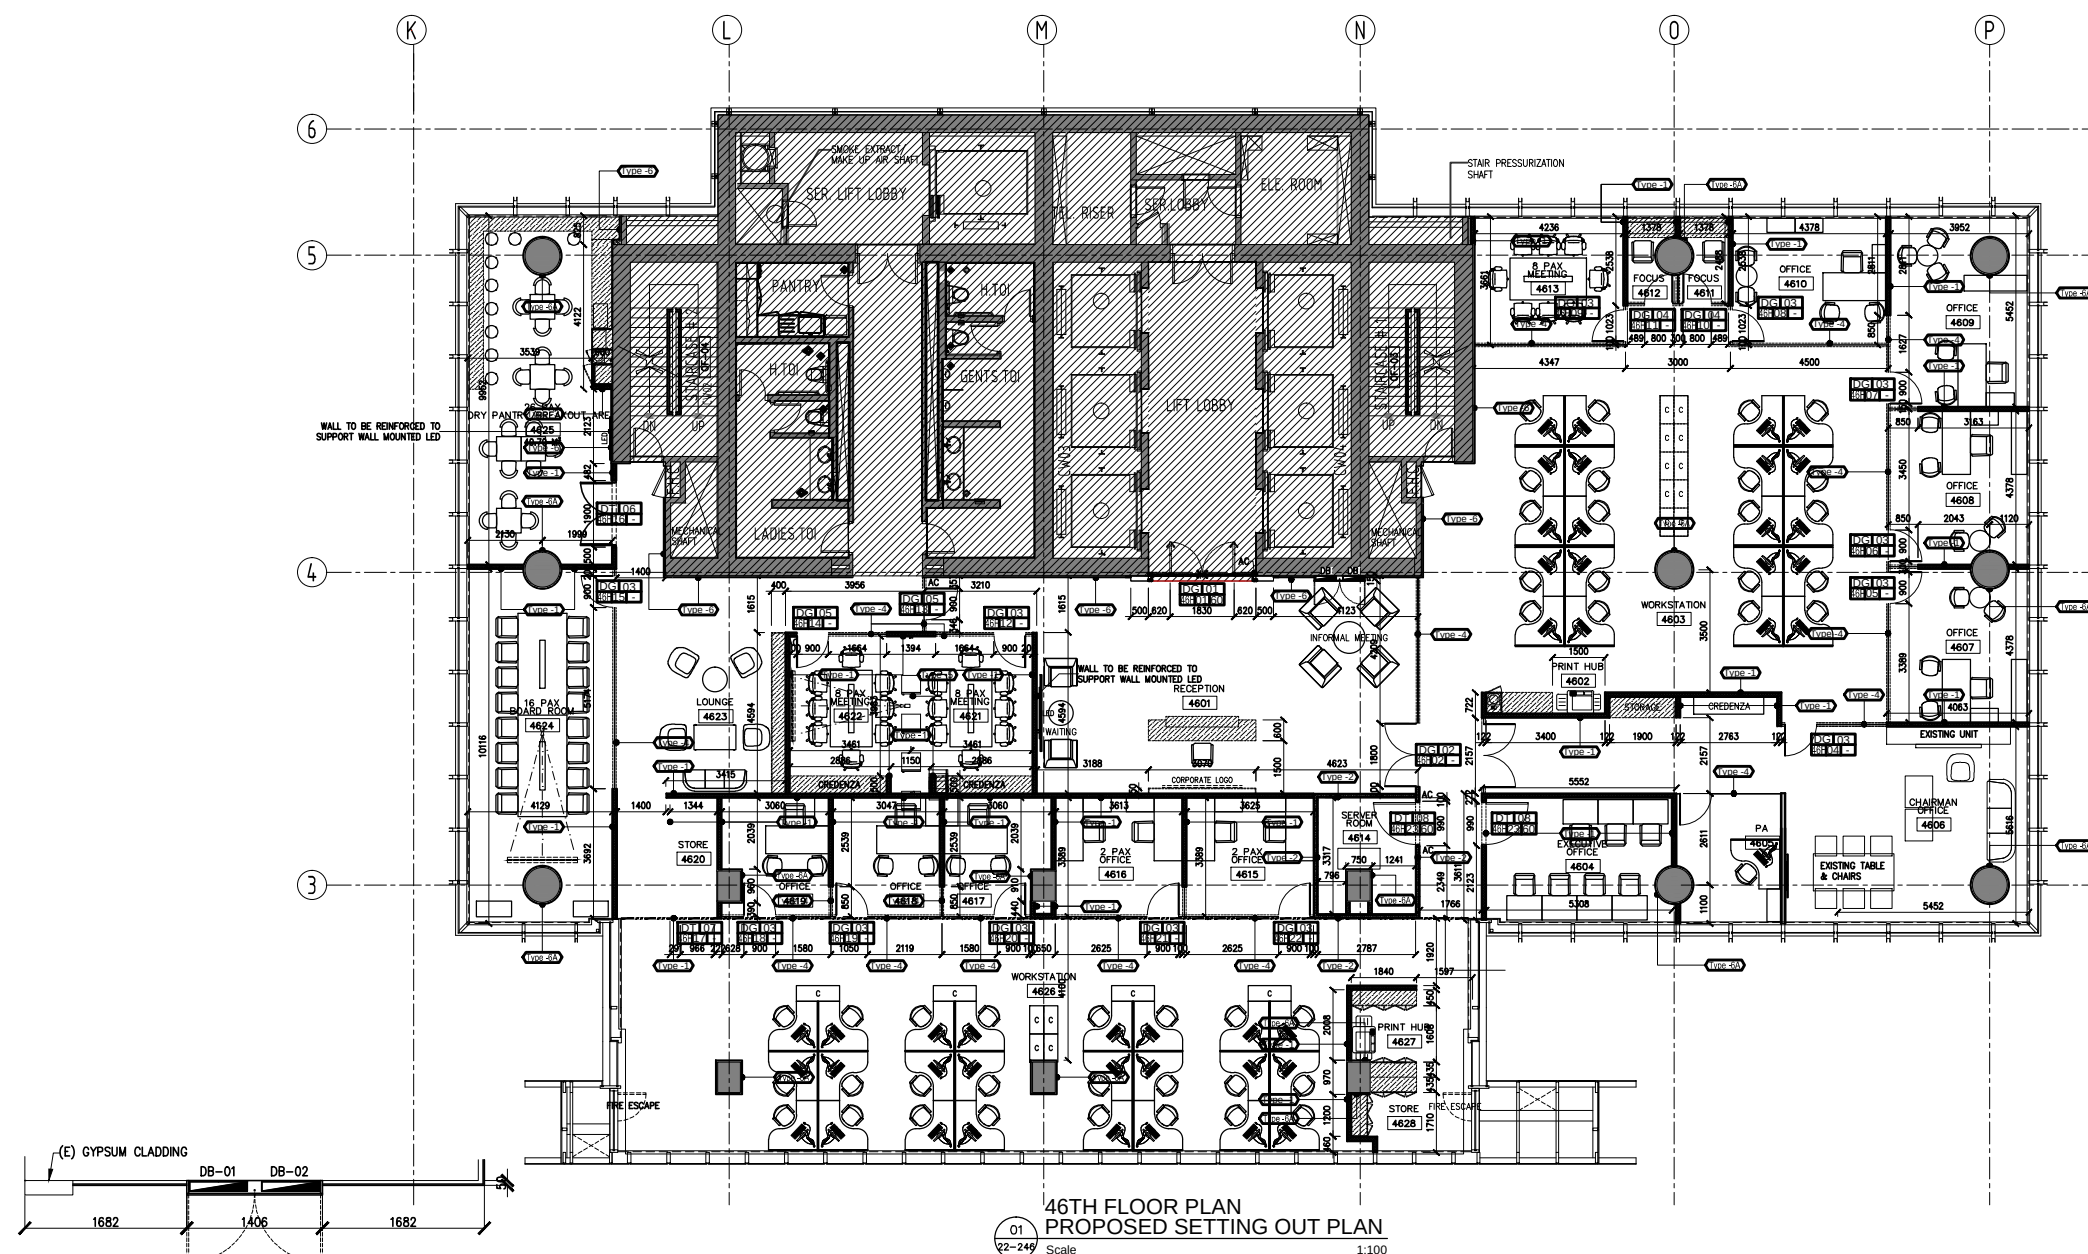

WALL TYPE LEGEND :

		- EXISTING WALLS & CONCRETE COLUMNS (TYPE OF WALLS TO BE VERIFY AT SITE)
TYPE-1		(FLOOR TO SOFFIT OF SLAB) 122mm THK. PARTITION WITH DOUBLE LAYER OF 12.5MM THK. GYPROC REGULAR BOARD ON BOTH SIDES
TYPE-2		(FLOOR TO SOFFIT OF SLAB) 122mm THK. PARTITION WITH DOUBLE LAYER OF 12.5MM THK. GYPROC FIRESTOP BOARD ON BOTH SIDES
TYPE-3		(FLOOR TO SOFFIT OF SLAB) 122mm THK. PARTITION WITH DOUBLE LAYER OF 12.5MM GYPROC MOISTURE RESISTANT BOARD ON BOTH SIDES
TYPE-4		(FLOOR TO CEILING) SINGLE GLAZED 12MM GLASS WALL PARTITION
TYPE-5		FOLDABLE PARTITION
TYPE-6		PROPOSED SINGLE LAYER GYPSUM WALL LINING TO BLOCK WORKS
TYPE-6-A		PROPOSED SINGLE LAYER GYPSUM WALL LINING TO STRUCTURAL COLUMN

- ALL CURVE PARTITION SHALL BE CONSTRUCTED WITH GYPWALL CURVE SYSTEM BY GYPROC OR SIMILAR APPROVED.


DOOR LEGEND—REFER 32-500 DRAWING SERIES

DOOR LEGEND REFER SEE DRAWING SERIES

DOOR CLASSIFICATION:
EX - EXISTING DOORS TO BE REFURBISHED
DT - SEMI-SOLID/ FLUSH/ FIRE RATED DOORS
DG - GLAZED DOOR
DA - ACRYLIC DOOR
SP - SYSTEM PARTITION DOOR

DOOR TYPE
DOOR FIRE RATING (in MINUTES)
DOOR SEQUENCE NUMBER
FLOOR LEVEL

INTERIOR FIT-OUT CONSULTING

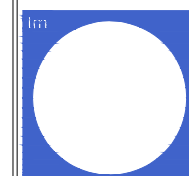

BLUEHAUS

PROJECT DETAILS
NEW FIT-OUT WORK FOR KOOHJI
OFFICE
TEL: 0730 950 55 / 020 466 04

MAIN FIT-OUT CONTRACTOR
مناول الديكور
AL MUNAWEL DECOR L.L.
Interior Consultant and Contractor
P.O. #0714 280 8666, FAX: #0714 280 6464, P.O.B. 117293
DUBAI, UNITED EMIRATES
info@munawelgroup.com

SUB-CONTRACTOR

Downloaded from ascelibrary.org by University of California, San Diego on 06/01/15. Copyright ASCE, For All Rights Reserved, No part of this document may be reproduced without written permission from ASCE.

DRAGON TITLE

BH644_22-246--SETTING OUT PLAN

FILE REFERENCE	
----------------	--

AMD / DP / TH/ 234 / 2013