 



Blockwork walls - H & H Celcon standard grade blocks with a single coat of Thistle Browning and a single coat of Thistle multi finish plaster either side

New Bridge Street

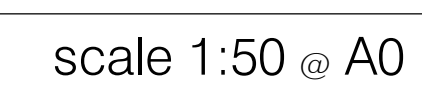

Client Sadipo Trust.

Project	6-7 New Bridge Street London EC2N 2BQ
----------------	--

Drawing First Floor
General Arrangement Plan

Drawing Status
AS BUILT

Scale 1:50 @A0

Drawn by	mc	Project no.	11123
----------	----	-------------	-------

Checked by	Drawing no.	03
Date	March 2012	Revision
		D