


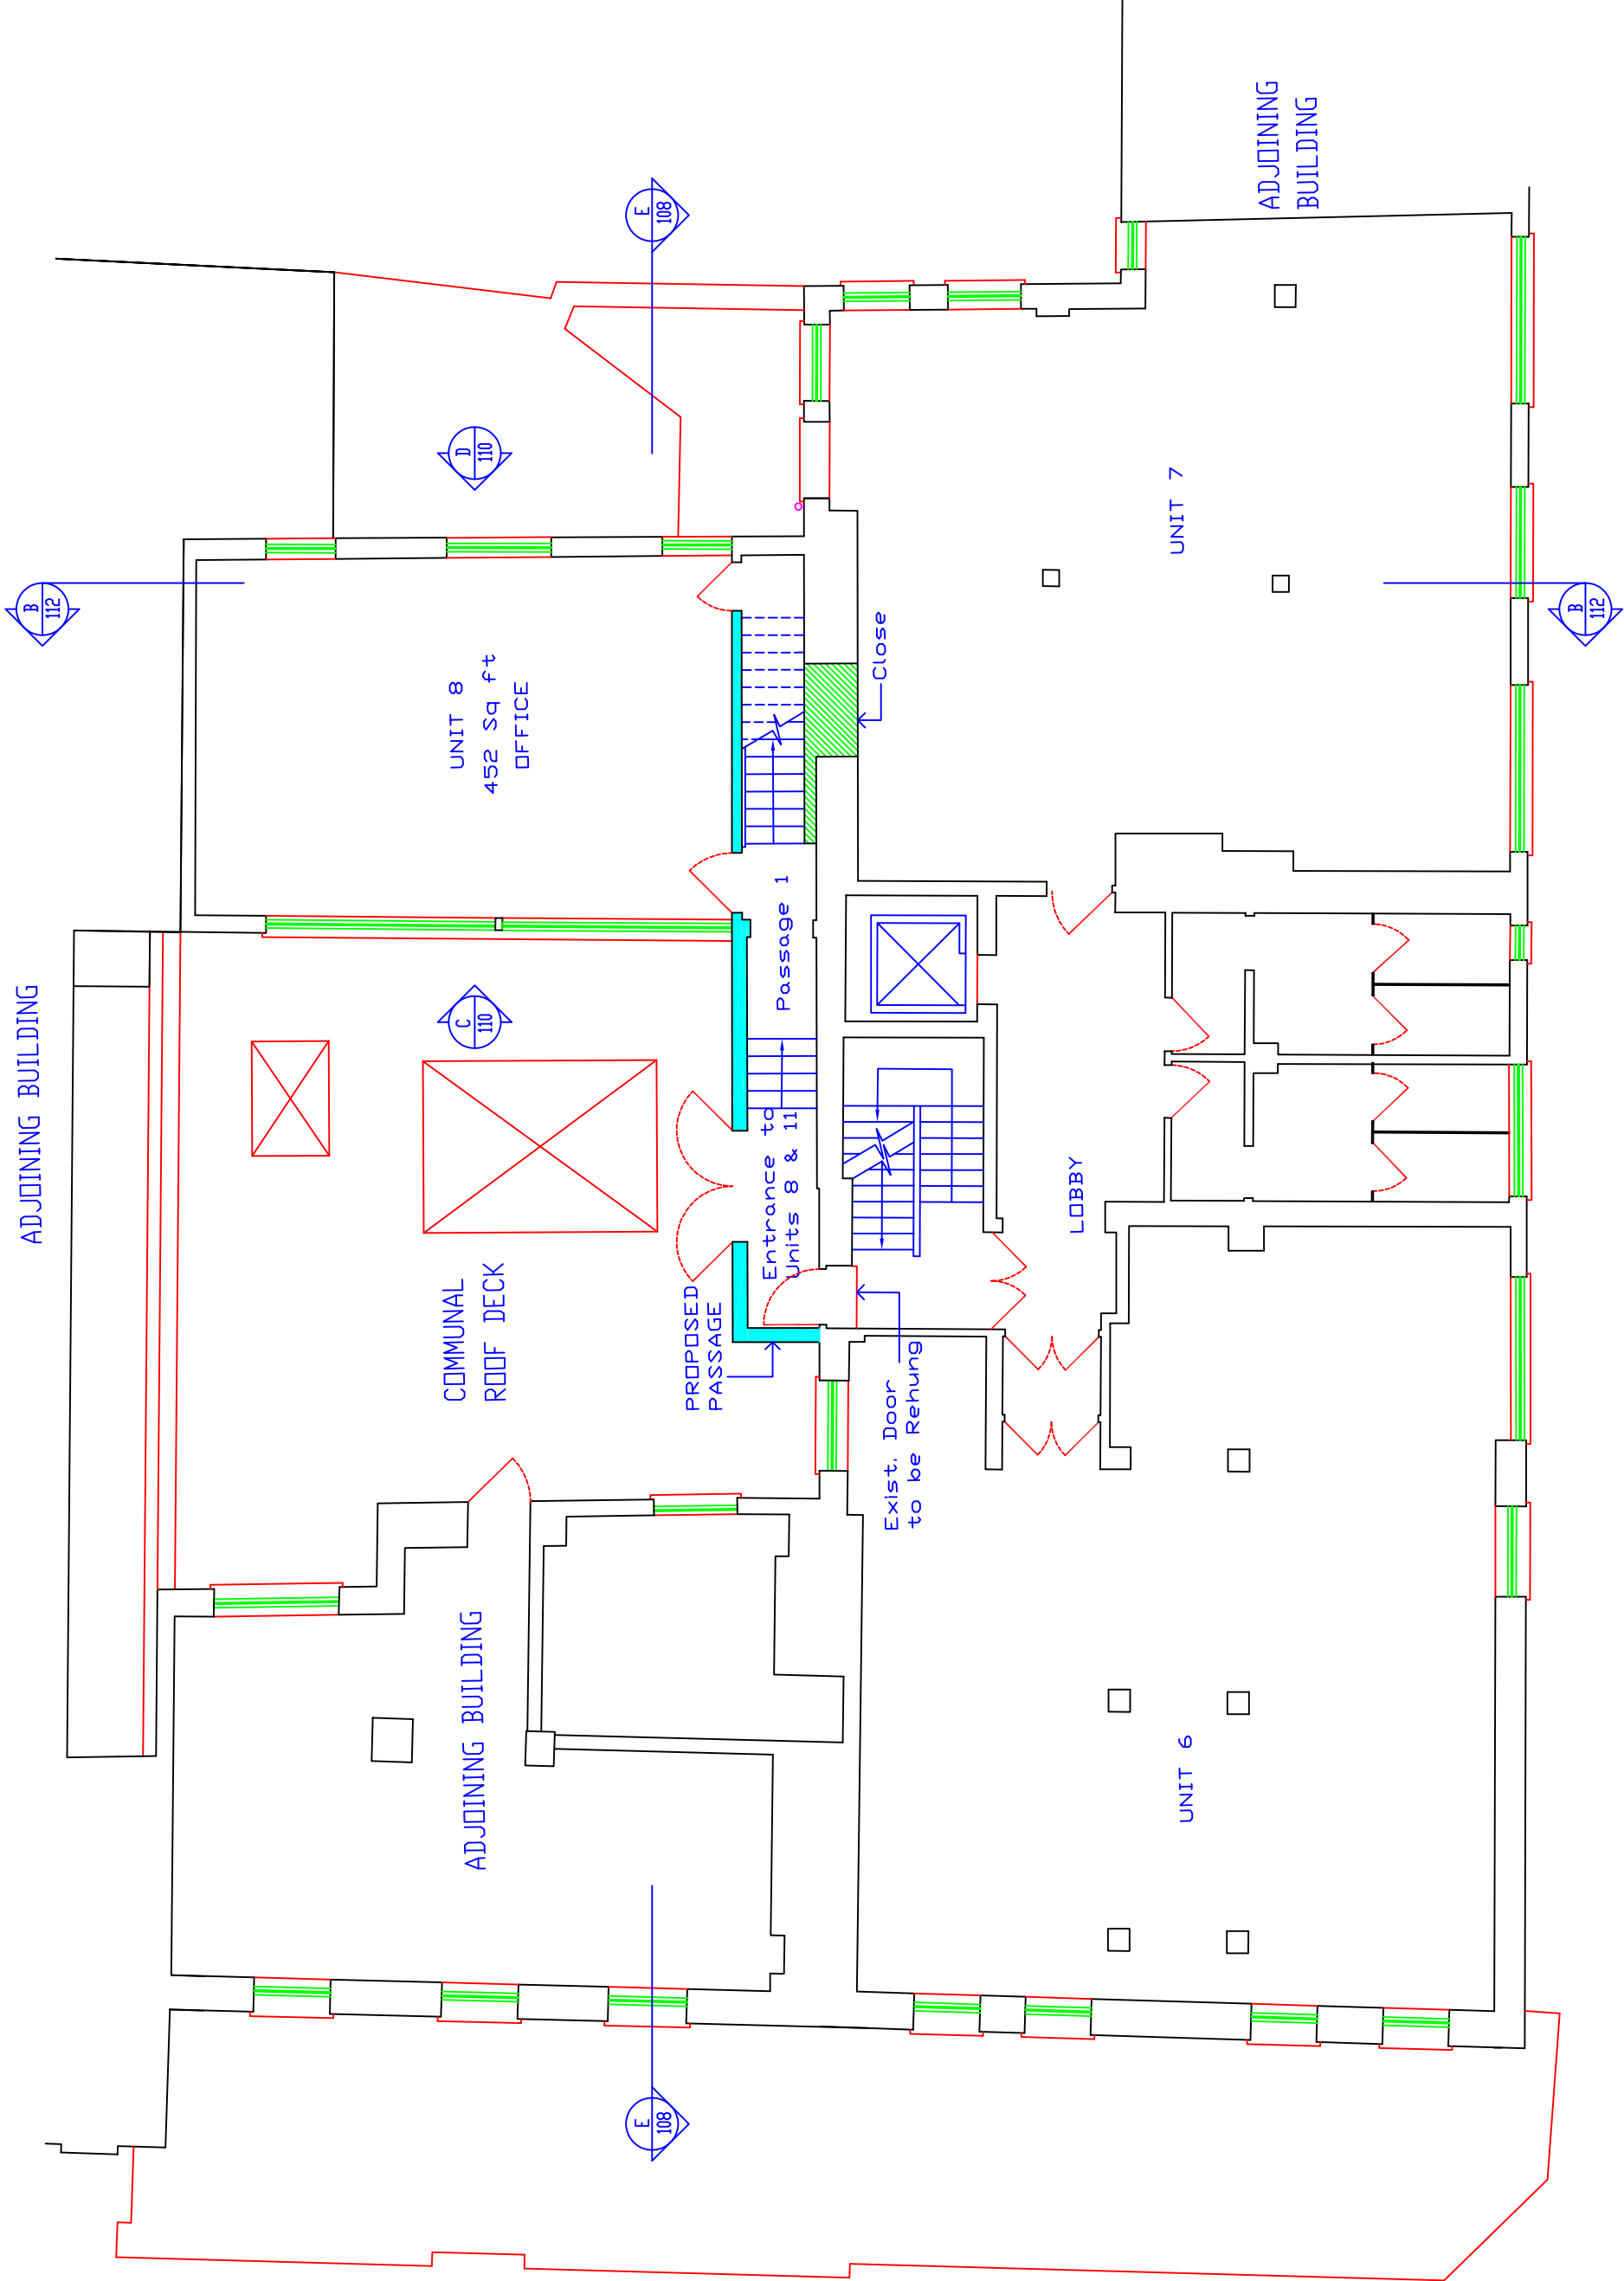

PROJECT :		CLIENT :		1 IF IN DOUBT - ASK 2 DO NOT SCALE OFF THIS DRAWING 3 ALL DIMENSIONS ARE TO BE VERIFIED ON SITE BY THE CONTRACTOR AND REPORTED TO THE ARCHITECT BEFORE CONSTRUCTION 4 THIS DRAWING IS TO REPLACE PREVIOUSLY ISSUED DRAWING 5 COPYRIGHT OF THIS DRAWING REMAINS WITH THE ARCHITECT		NO	DATE	REVISION	DRAWING TITLE :						
SUNA HOUSE 128-130 Curtain Road & 63-65 Rivington Street London EC2		LEAMINGTON HOLDINGS Ltd							PROPOSED FIRST FLOOR PLAN						
MITTELMAN ASSOCIATES, 75 College Road, London SE21 7HH		Tel: 0208 299 0101 Fax: 0208 299 0201							SCALE:	1:100	PROJECT NO :	2000-138	DRAWN BY :	Jm	A3
									DATE:	24/05/00	DRAWING NO :	103	REV. :		