


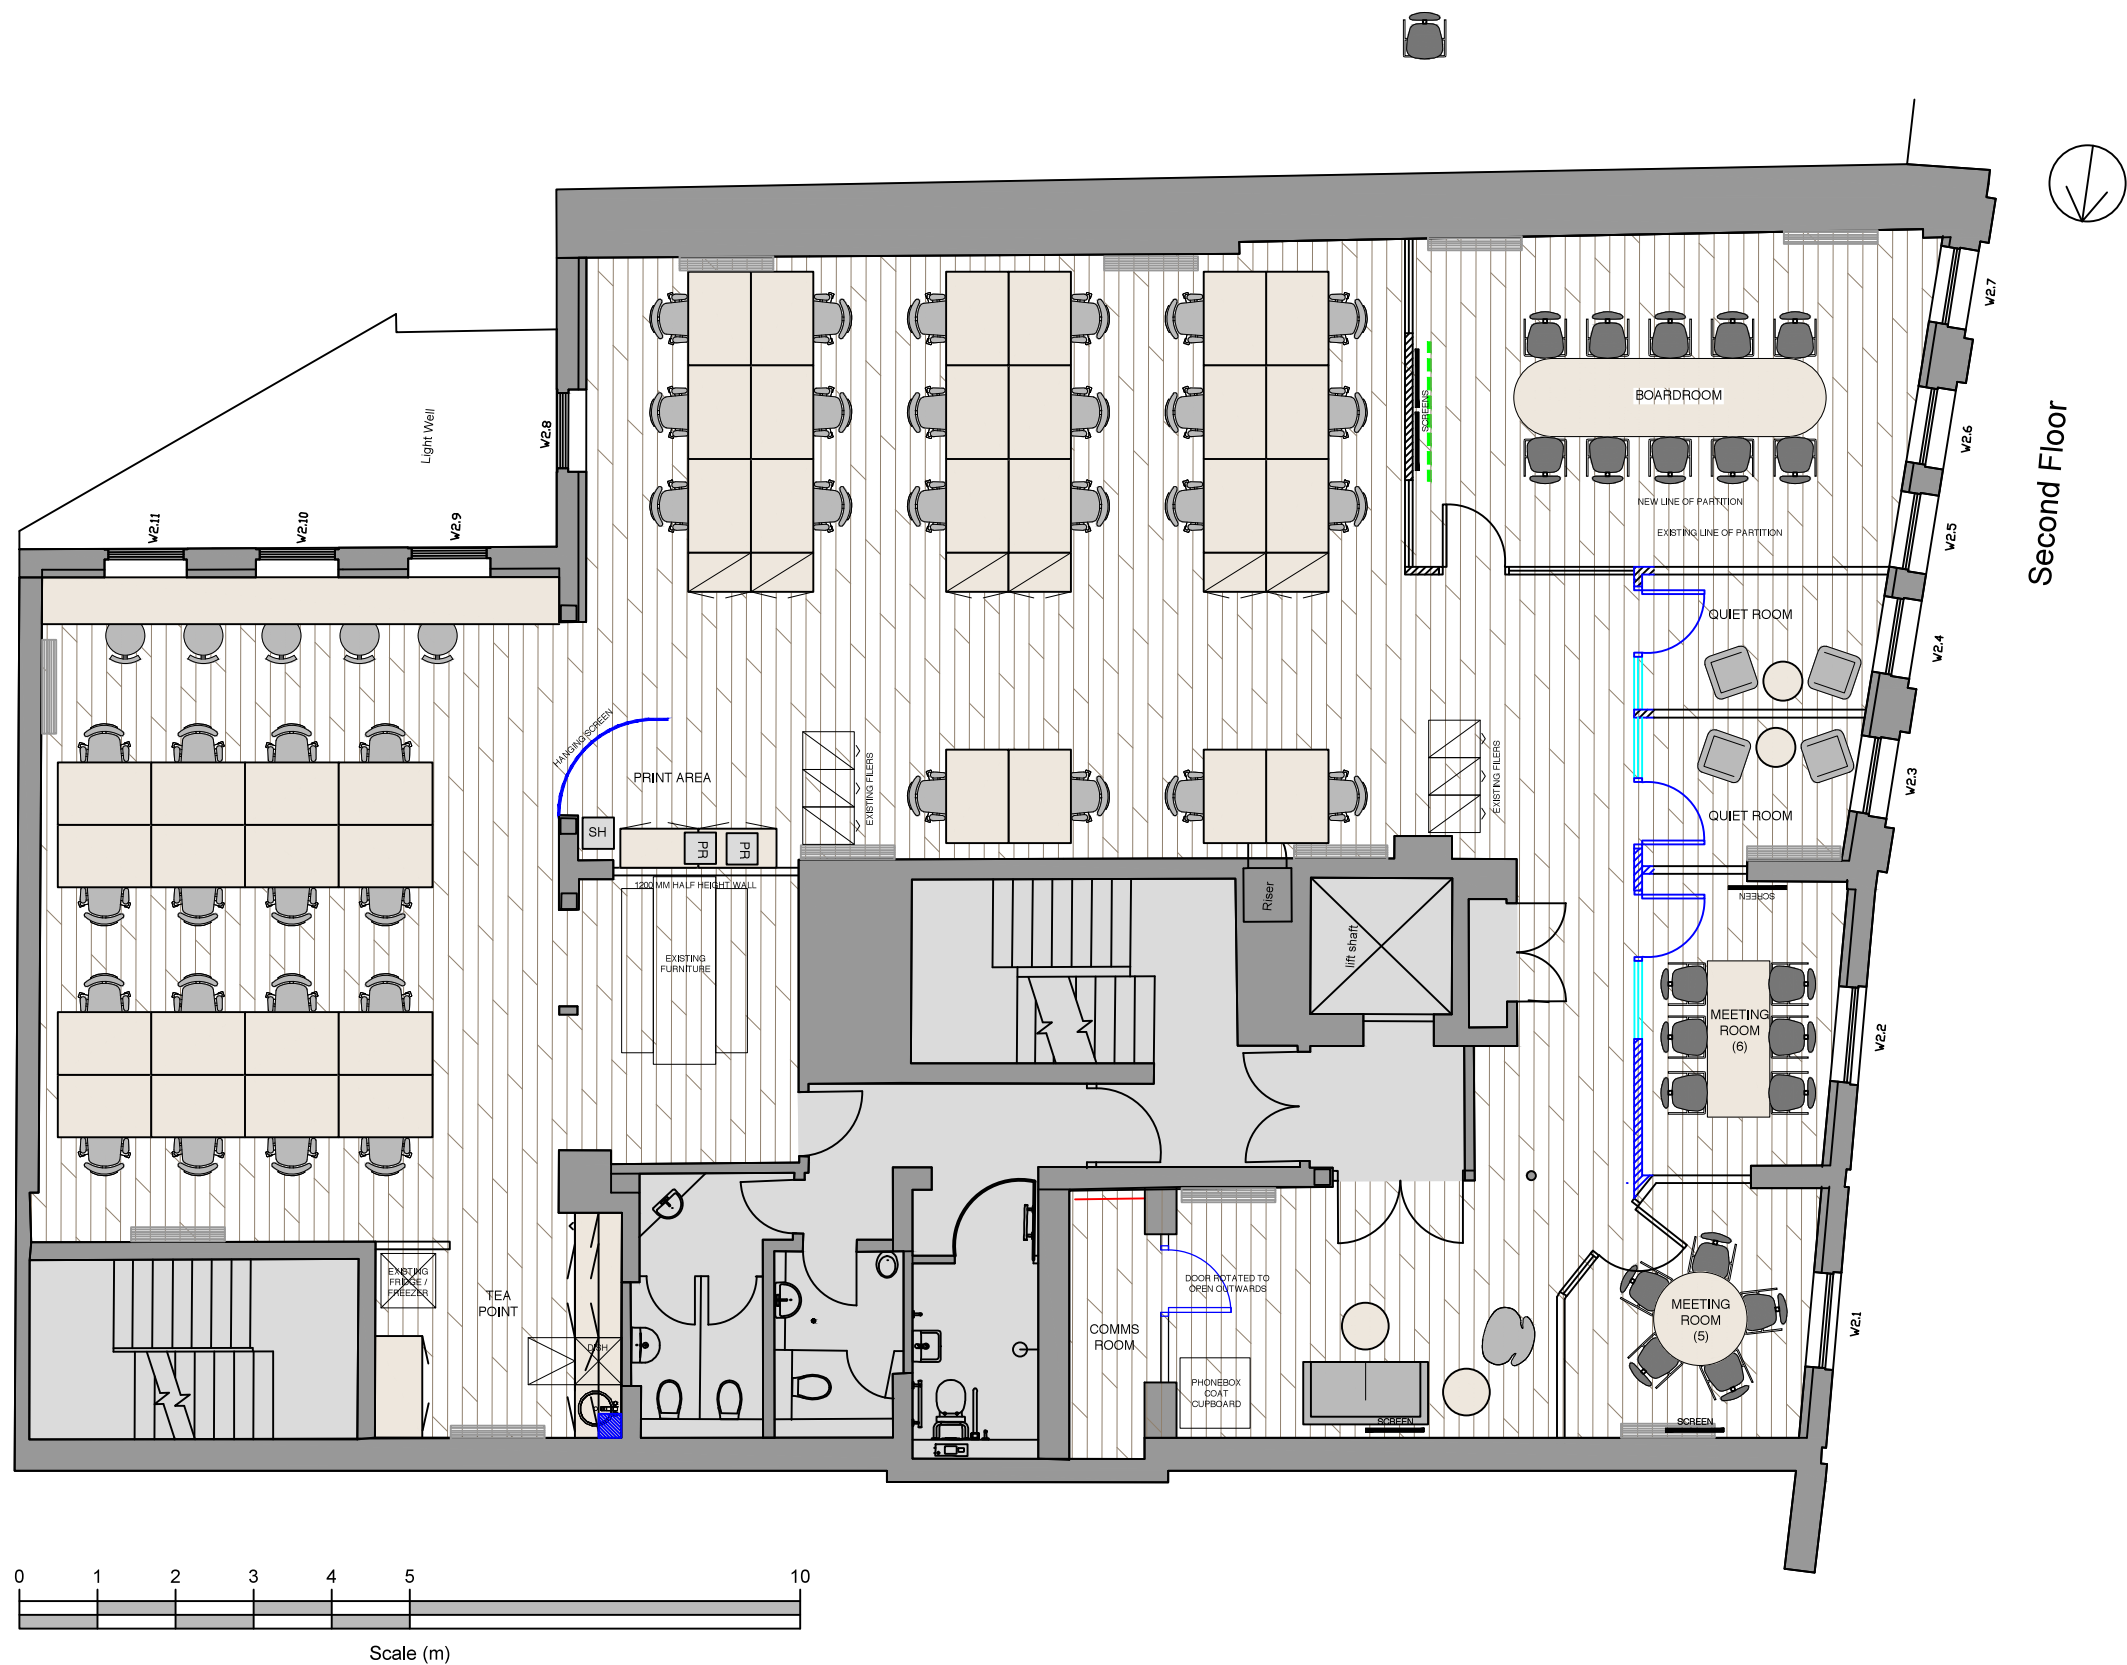

- KEY
- EXISTING PARTITION
 - DEMOLITIONS
 - 100mm DOUBLE BOARDED SOLID STUD
 - PAINTED TO MATCH EXISTING WALL
 - MDF SKIRTING TO MATCH EXISTING
 - 75mm SINGLE BOARDED SOLID STUD PARTITION
 - SILICON JOINT DOUBLE GLAZING
 - SILICON JOINT SINGLE GLAZING
 - GREY ALUMINIUM TRACK
 - HALF HEIGHT WALL
 - 100MM SOLID STUD WALL
 - 1200MM HEIGHT FFFL
 - NEW SOLID DOOR - WHITE PAINT GRADE WITH GREY ALUMINIUM FRAME
 - NEW SINGLE GLAZED GLASS DOOR WITH FRAME
 - NEW SINGLE GLAZED GLASS DOOR
 - PLY REINFORCEMENT

STIRLINGGREY.

37 Foley St, London W1W 7TN
0844 330 1649
hello@stirlinggrey.co.uk

Head Office: Unit 3, Blackhill Drive, Wolverton Mill, Milton Keynes, MK12 5TS

TECHSTYLE

2ND FLOOR
38 ST MARTINS LANE
LONDON
WC2N 4ER

GENERAL ARRANGEMENT

SGC113_02_GA

ASBUILT

1:100 @ A3

GENERAL NOTES:
All dimensions to be checked on site prior to commencement of any works, and/or preparation of any shop drawings.
Any discrepancies between information shown on this drawing and any other contract information / site information / manufacturer recommendations is to be brought to the attention of the Project Manager/Designer.
This drawing remains the property of Stirling Grey and may not be copied, reproduced or given to any third parties without the permission of Stirling Grey.
Proposals are subject to statutory approvals.
DO NOT SCALE FROM THIS DRAWING

© Stirling Grey