



NB Responsibility is not accepted for errors made by others scaling from this drawing. All construction information should be taken from figured dimensions only


A3

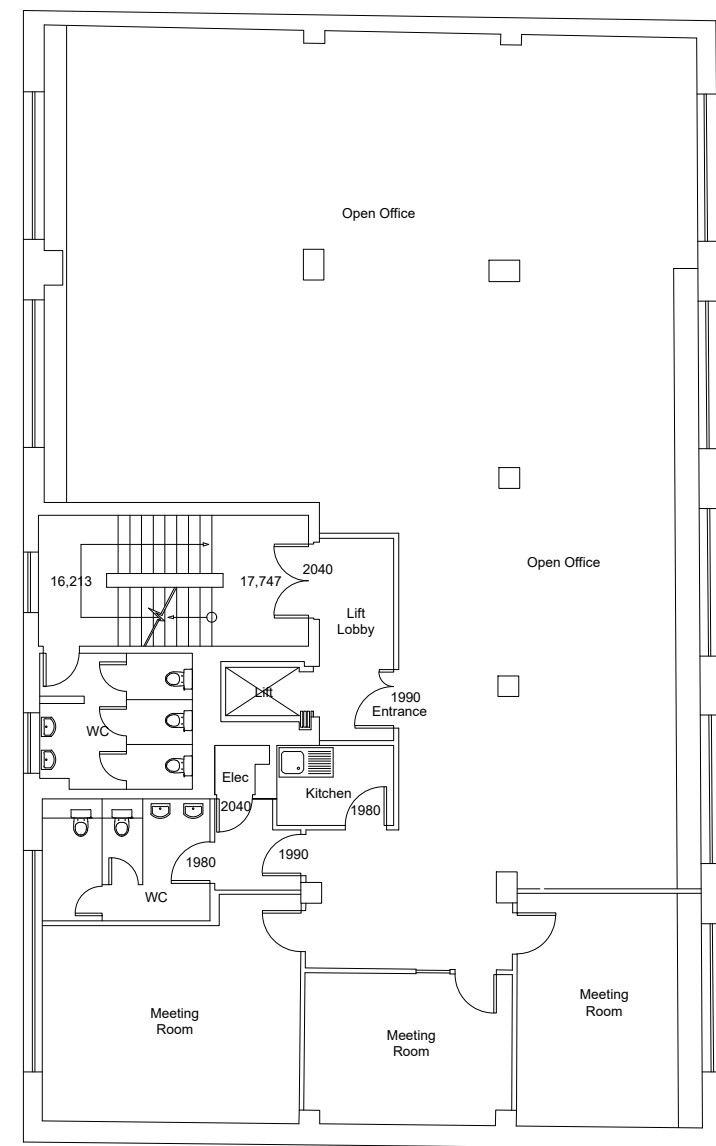

Third Level

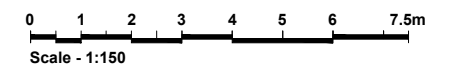

AS BUILT			
Rev	Description	By	Date



Project  
REFURBISHMENT TO 32-34  
SOUTHWARK BRIDGE ROAD

Client  
THREADNEEDLE INVESTMENTS Ltd.

Title  
34 SOUTHWARK BRIDGE ROAD  
THIRD FLOOR PLAN

Drawn by JRO	Surveyor SKC	Date JAN 2020
-----------------	-----------------	------------------

Scale  
1:150 @ A3

Drawing Number L192213-A02-003	Revision
-----------------------------------	----------

Layouts shown were supplied by a 3rd party; Workman LLP therefore take no responsibility for the accuracy or information taken from them.