




DO NOT SCALE OFF THIS DRAWING  
ALL DIMENSIONS TO BE CHECKED ON SITE

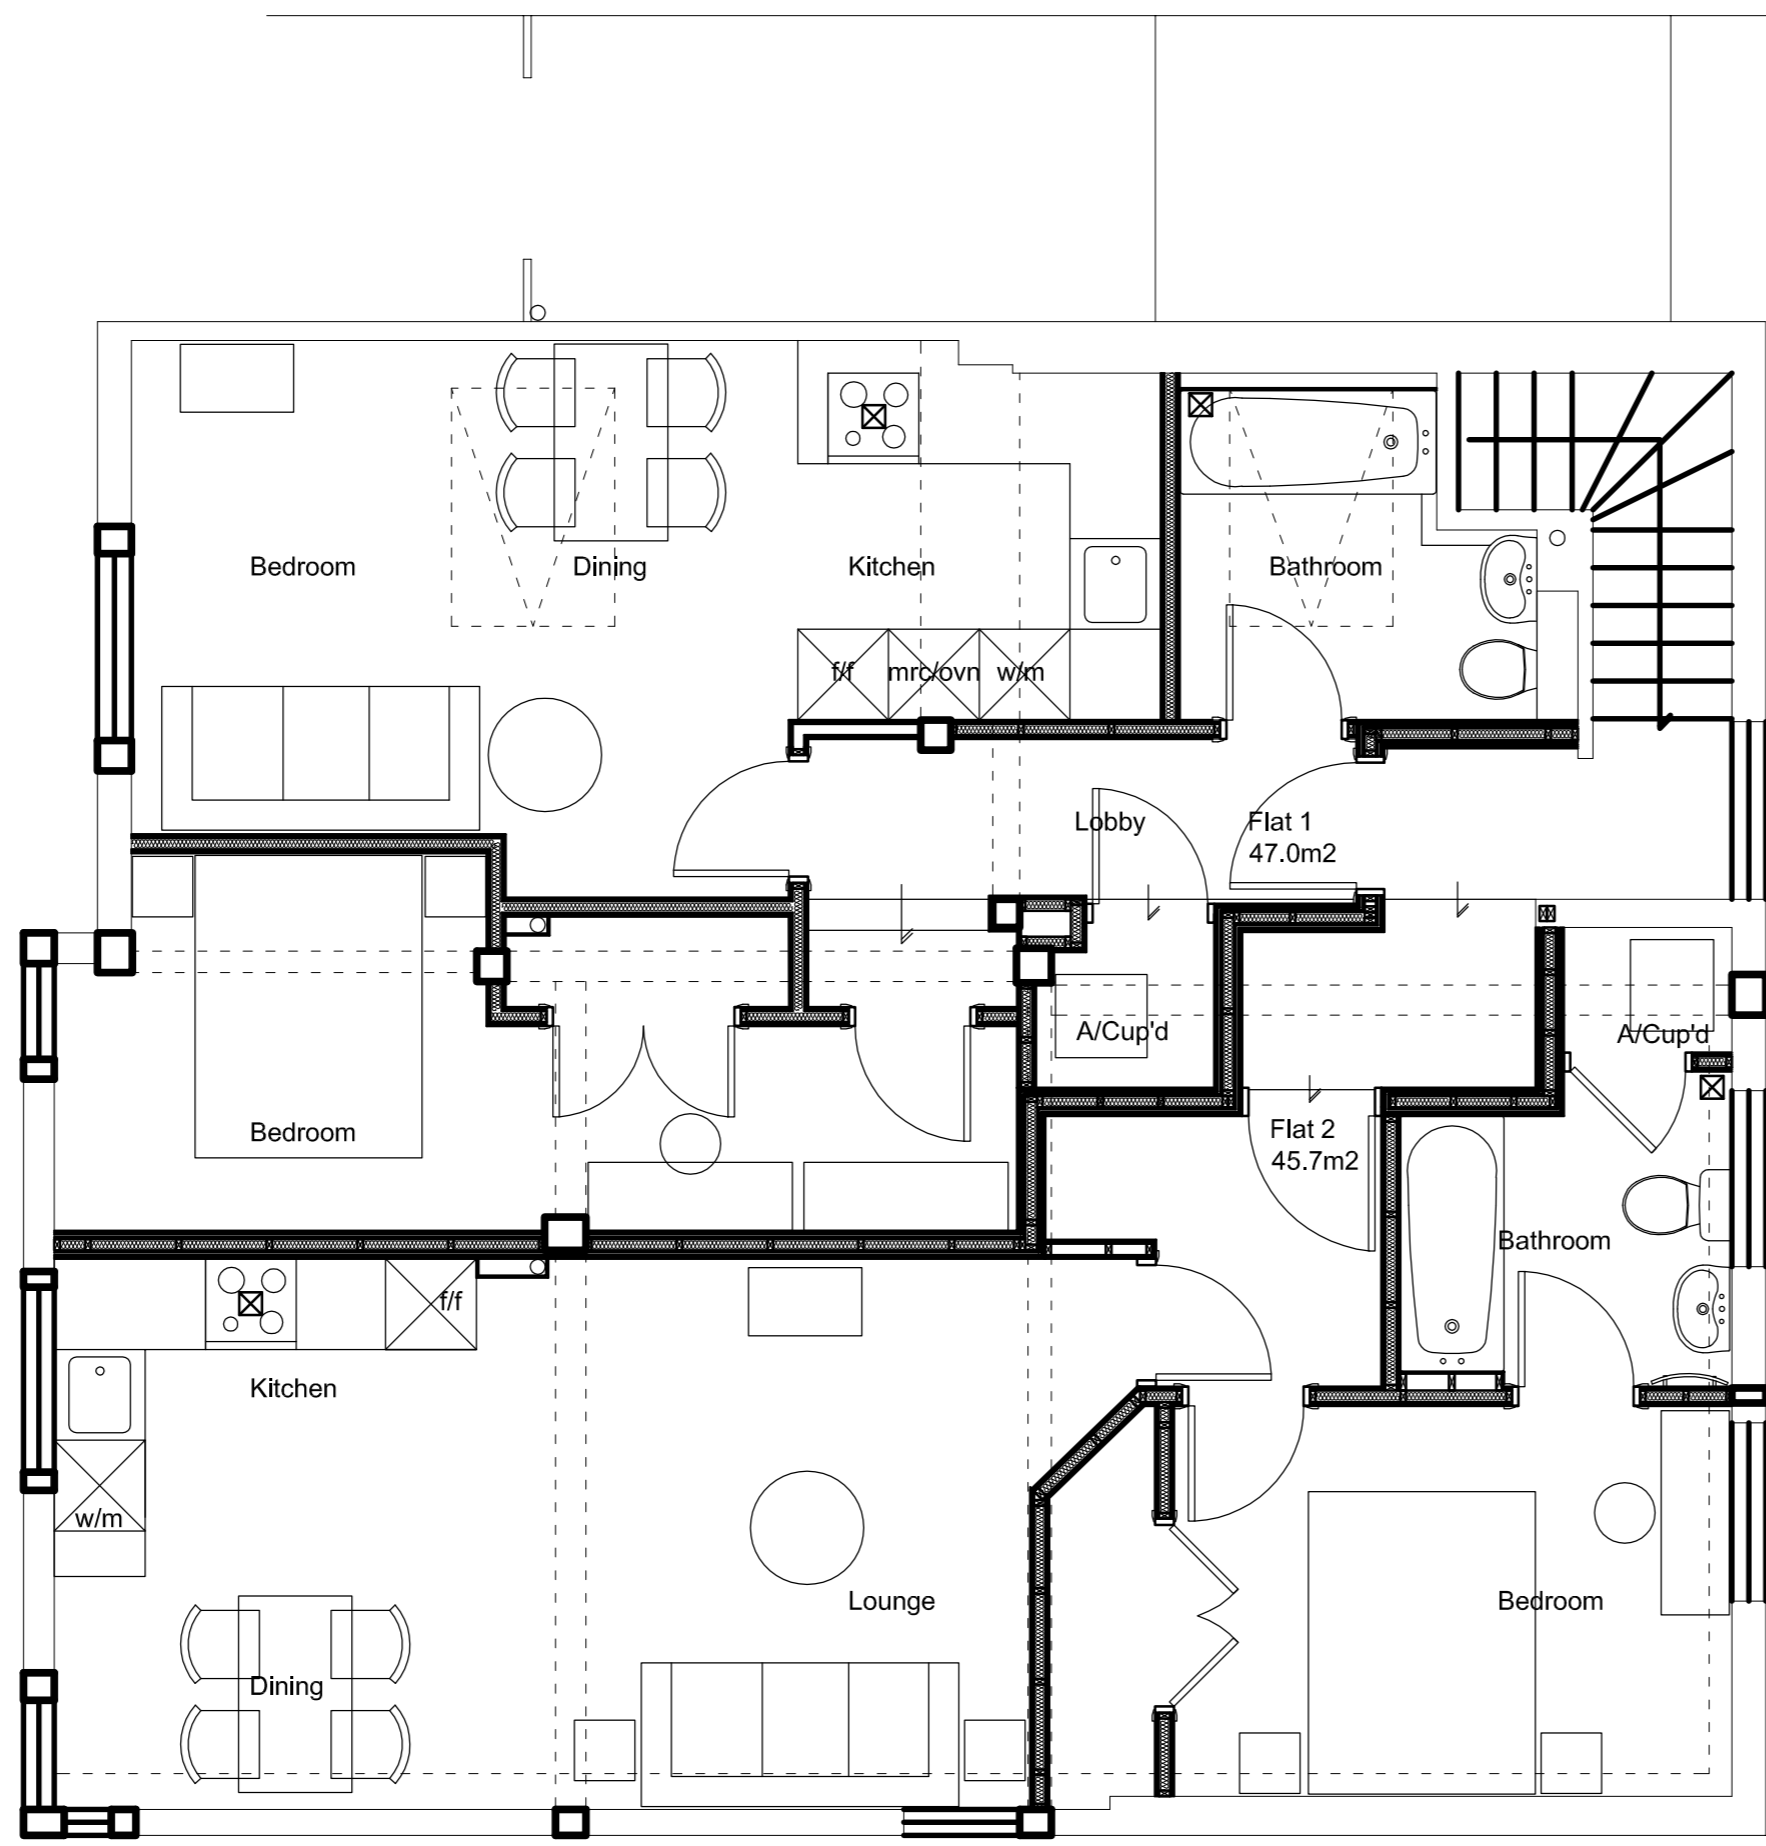

First floor plan  
1:50

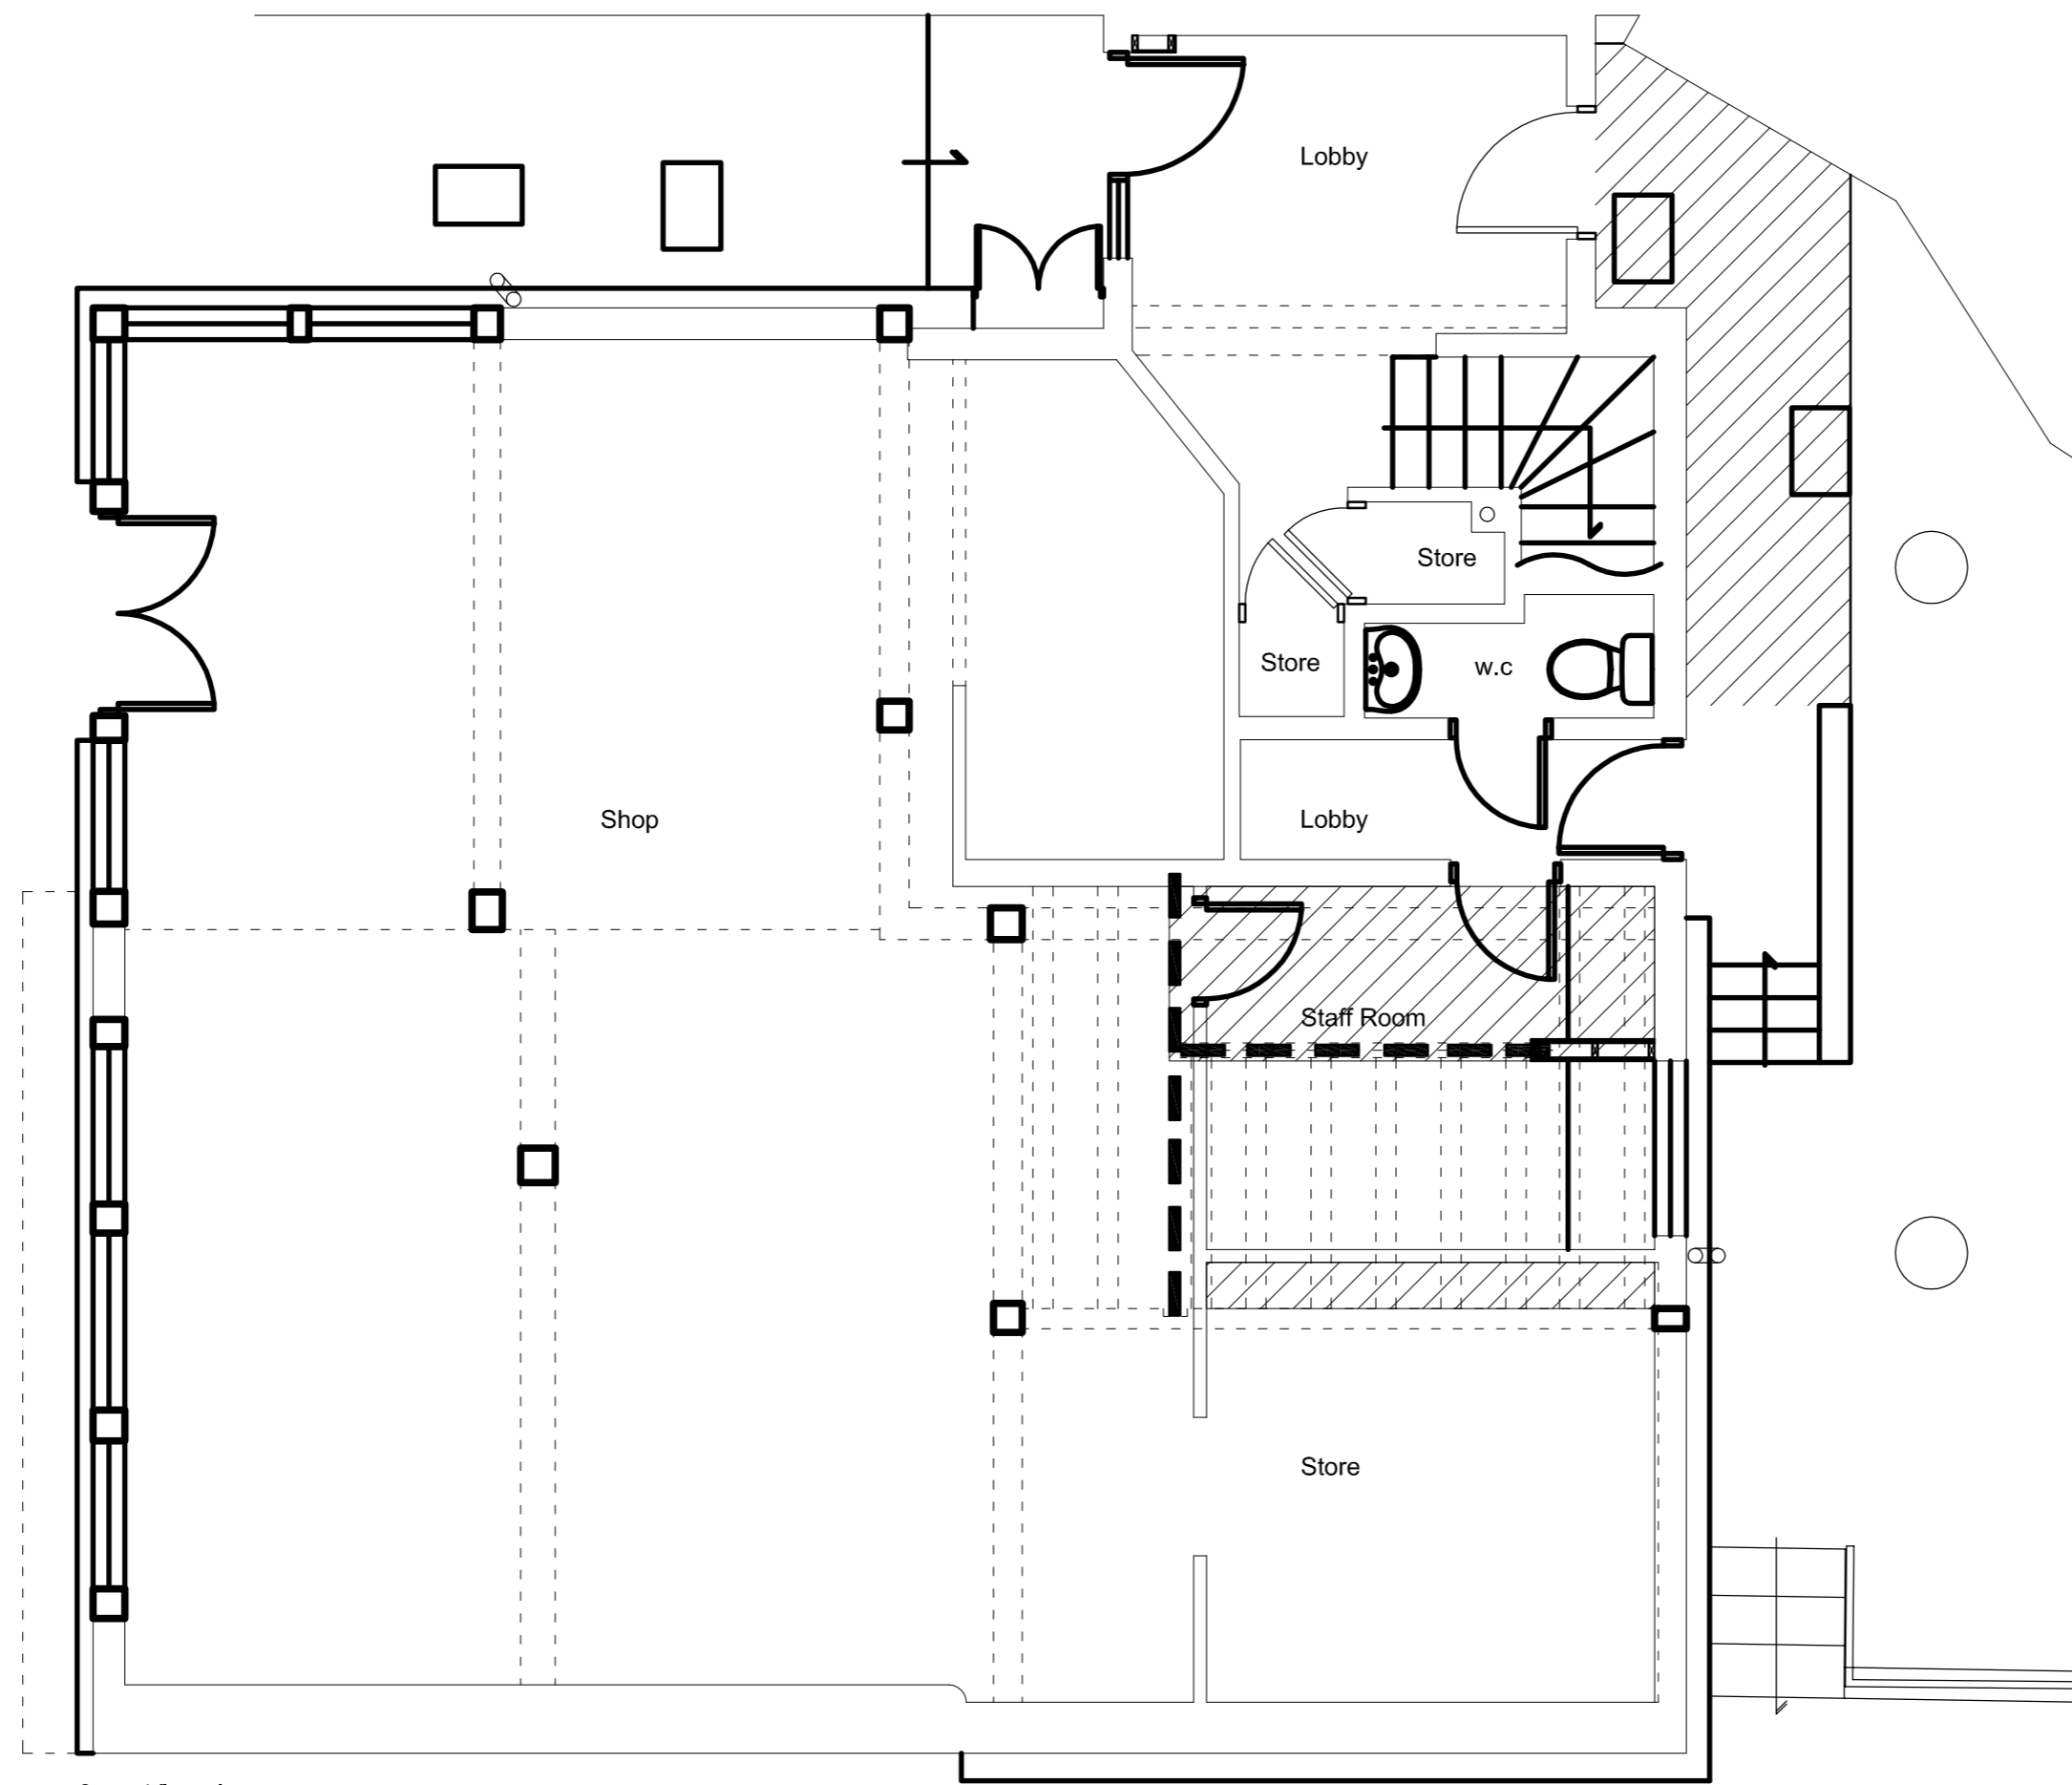


Ground floor plan  
1:50

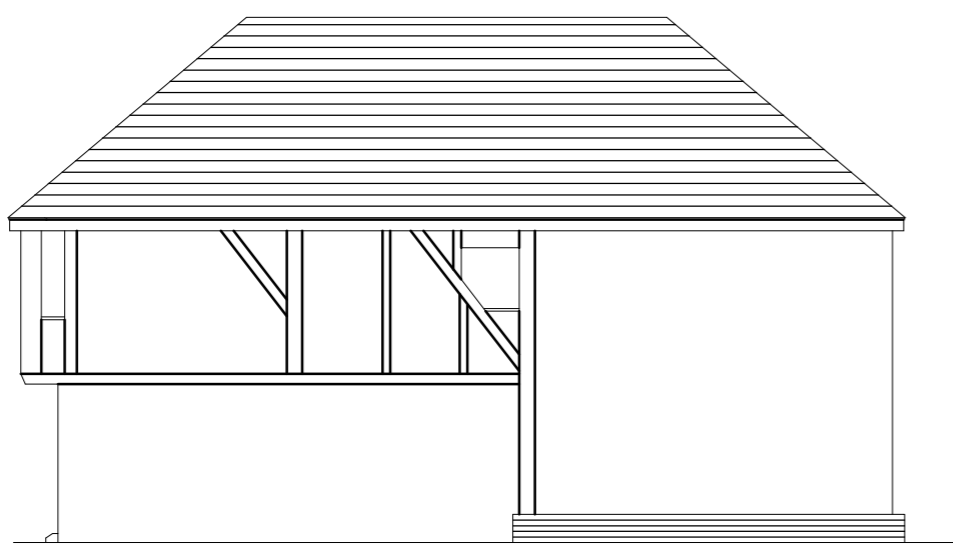


East elevation  
1:100




South elevation  
1:100

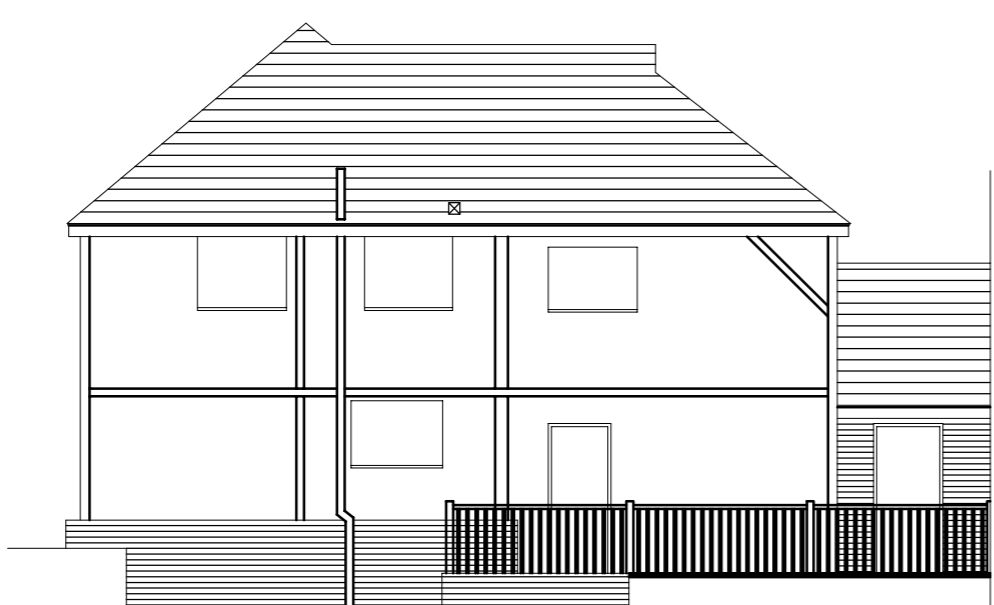

North elevation  
1:100

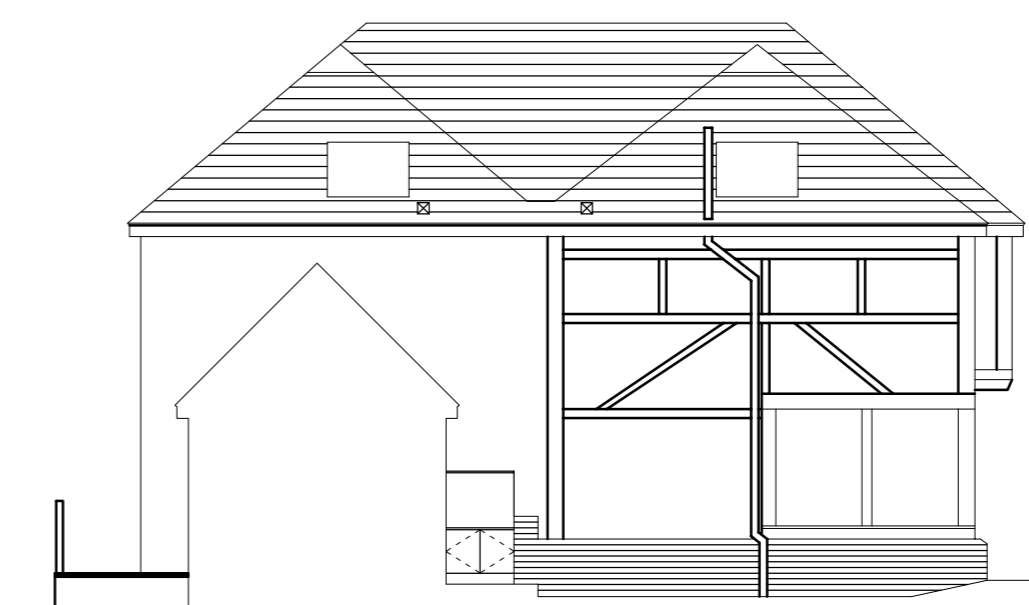

West elevation  
1:100

Rev	Description	Drawn	Check	Date
Revisions				
 SURVEYS & DESIGN <small>© Brian Wray Gutterford Surrey GU24 7JY www.brianwray.com tel 07870 134664</small>				
PROJECT				
33 - 35 High Street Leatherhead, KT22 8AB				
DRAWING TITLE				
As Built Plans & Elevations				
DATE	Jan 2012	SCALE	1:50	
SHEET	AA	CHK	JA	CAD REF. as dwg no.
DO NOT SCALE OFF THIS DRAWING ALL DIMENSIONS TO BE CHECKED ON SITE				
JOB / DRAWING No.				REV.
A11266.05.03				-